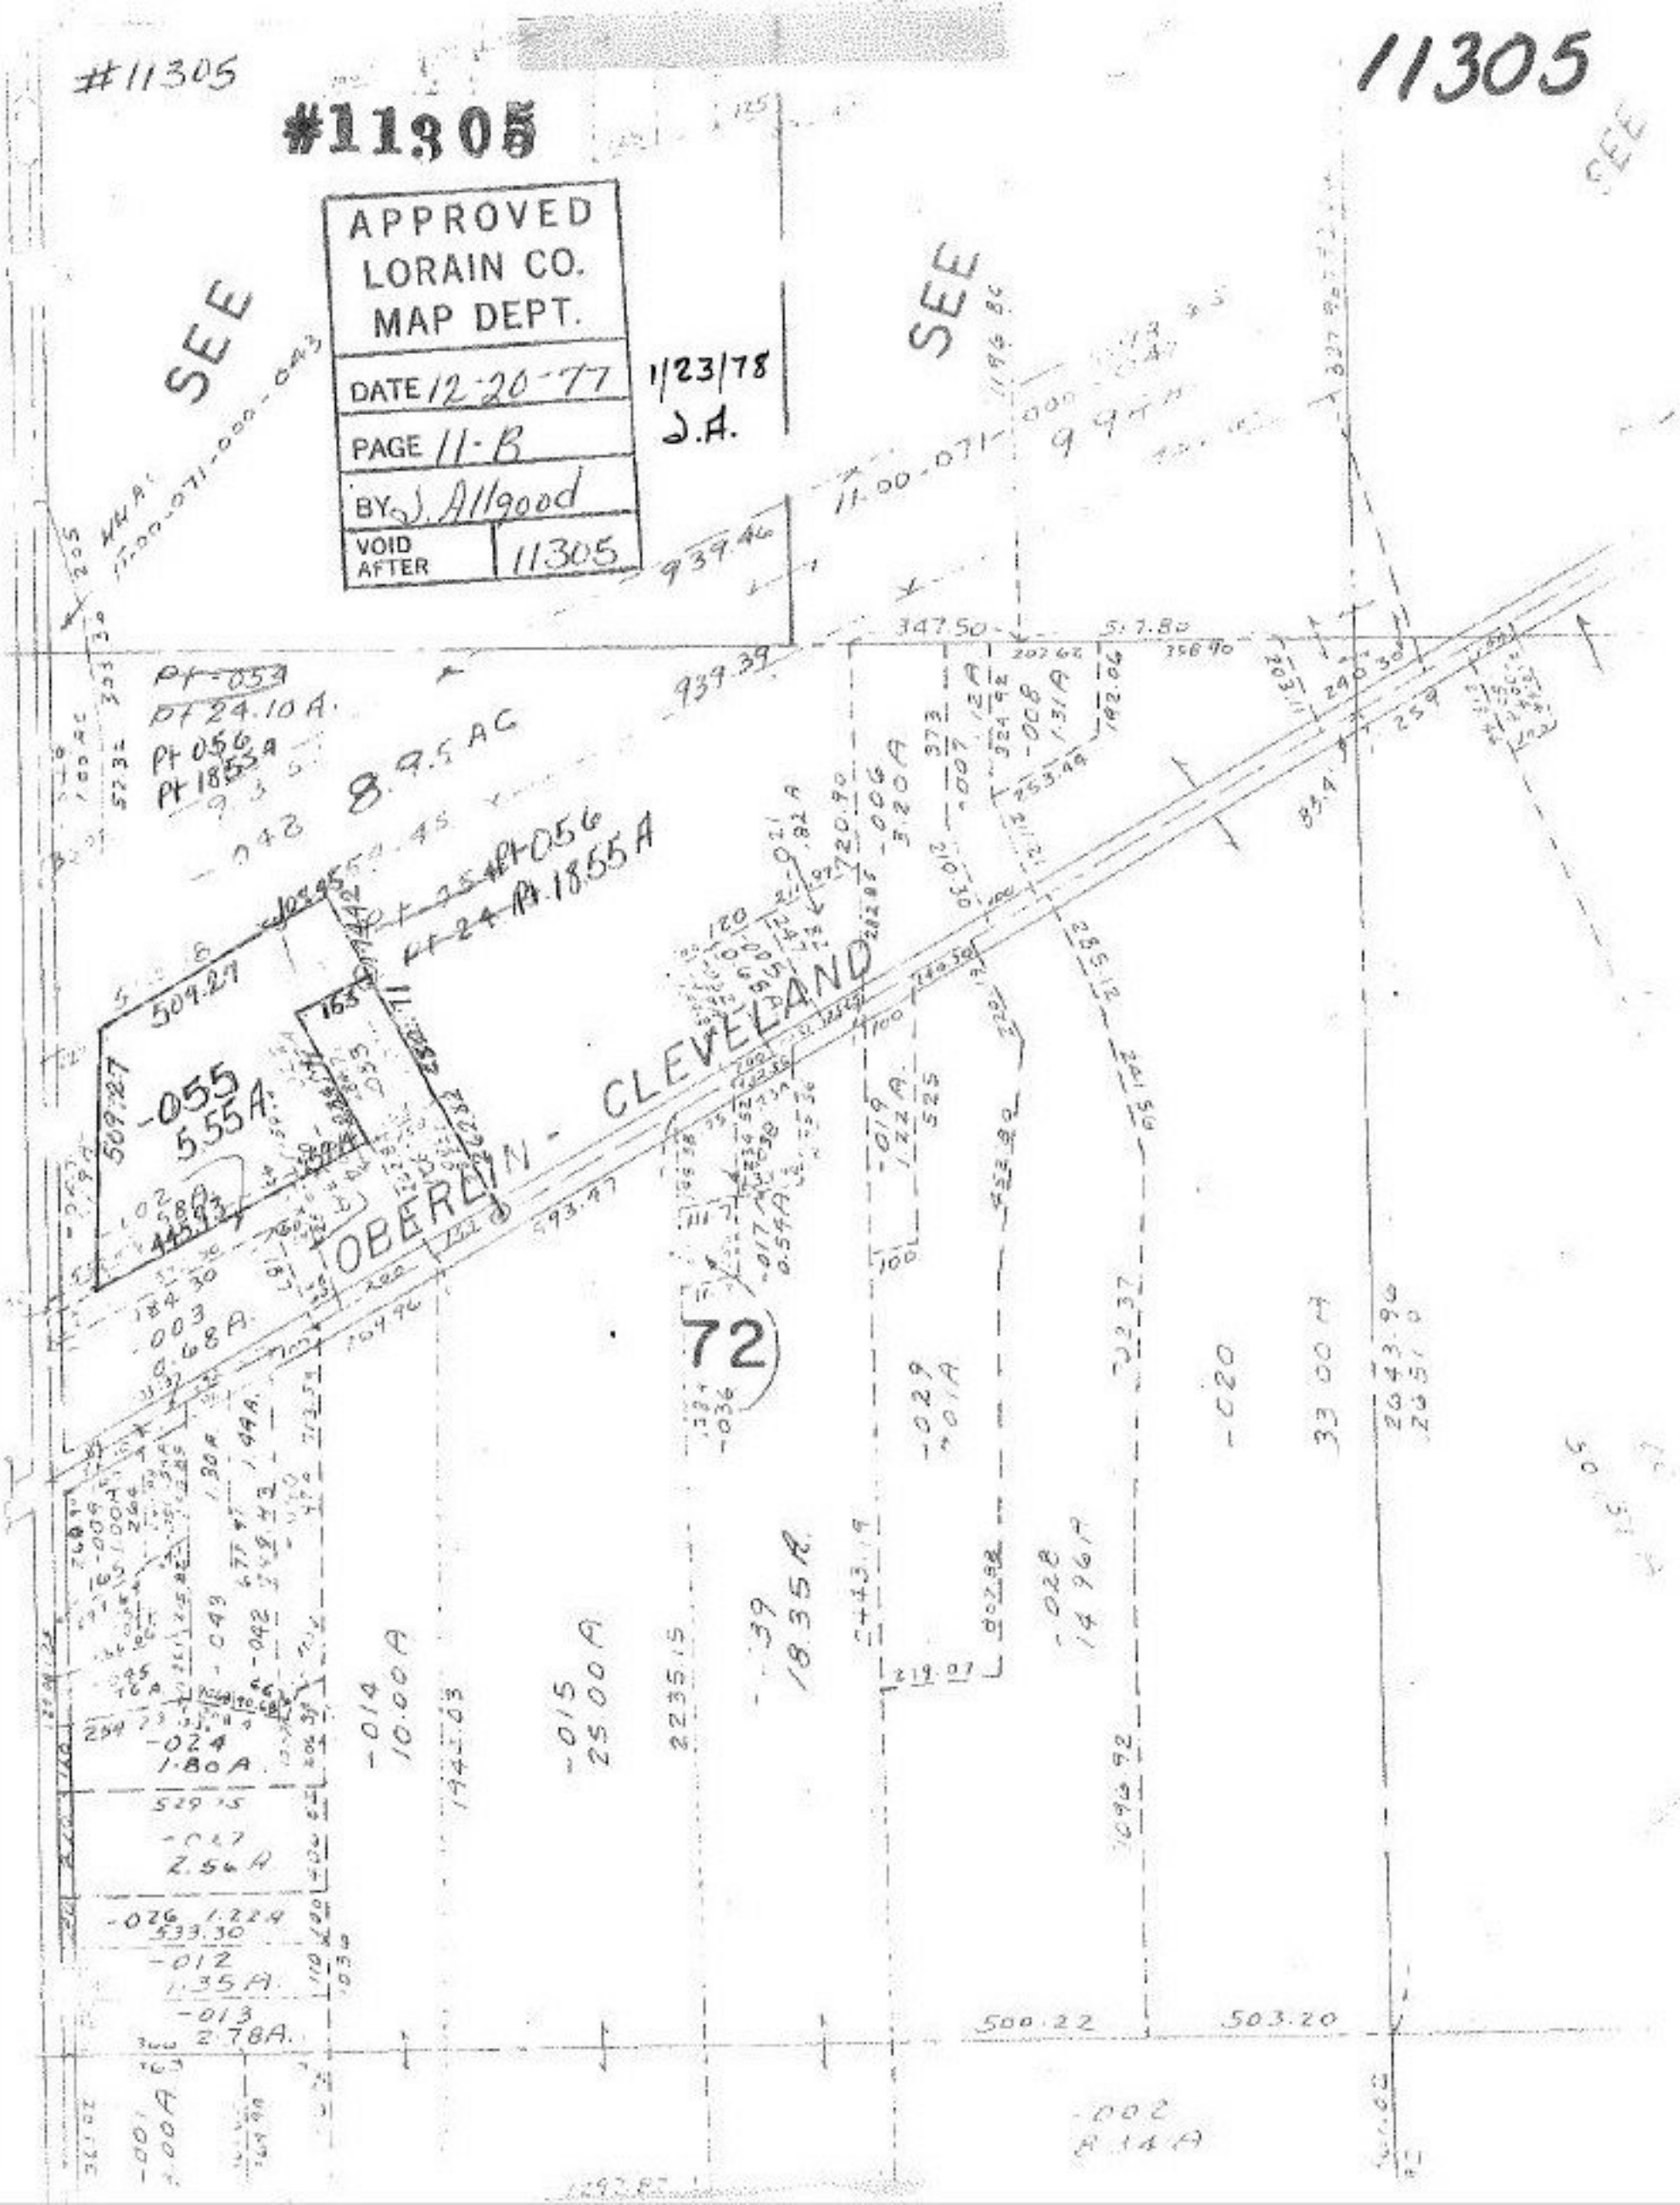
#11305
11305
#11305
APPROVED
LORAIN CO.
MAP DEPT.
DATE 12-20-77
PAGE 11-B
BY J. Allgood
VOID AFTER 11305
1/23/78
J.A.
SEE
SEE
SEE
OBERLIN - CLEVELAND
72
Pt-054
Pt 24.10 A.
Pt 056
Pt 1855 A
8.95 AC
-055
5.55 A.
-014
10.00 A
-015
25.00 A
-039
18.35 A
-028
14.96 A
-020
33.00 A
-024
1.80 A
-027
2.56 A
-026
1.22 A
-012
1.35 A
-013
2.78 A
-002
8.14 A
-001
2.00 A
-003
0.68 A
-029
-019
1.22 A
-017
0.54 A
-006
3.20 A
-008
1.31 A
-007
-012
1.30 A
-043
-042
-036
939.46
939.39
347.50
517.80
509.27
509.27
593.47
500.22
503.20
2235.15
1944.03
1096.92
2643.96
2651.0
1292.87