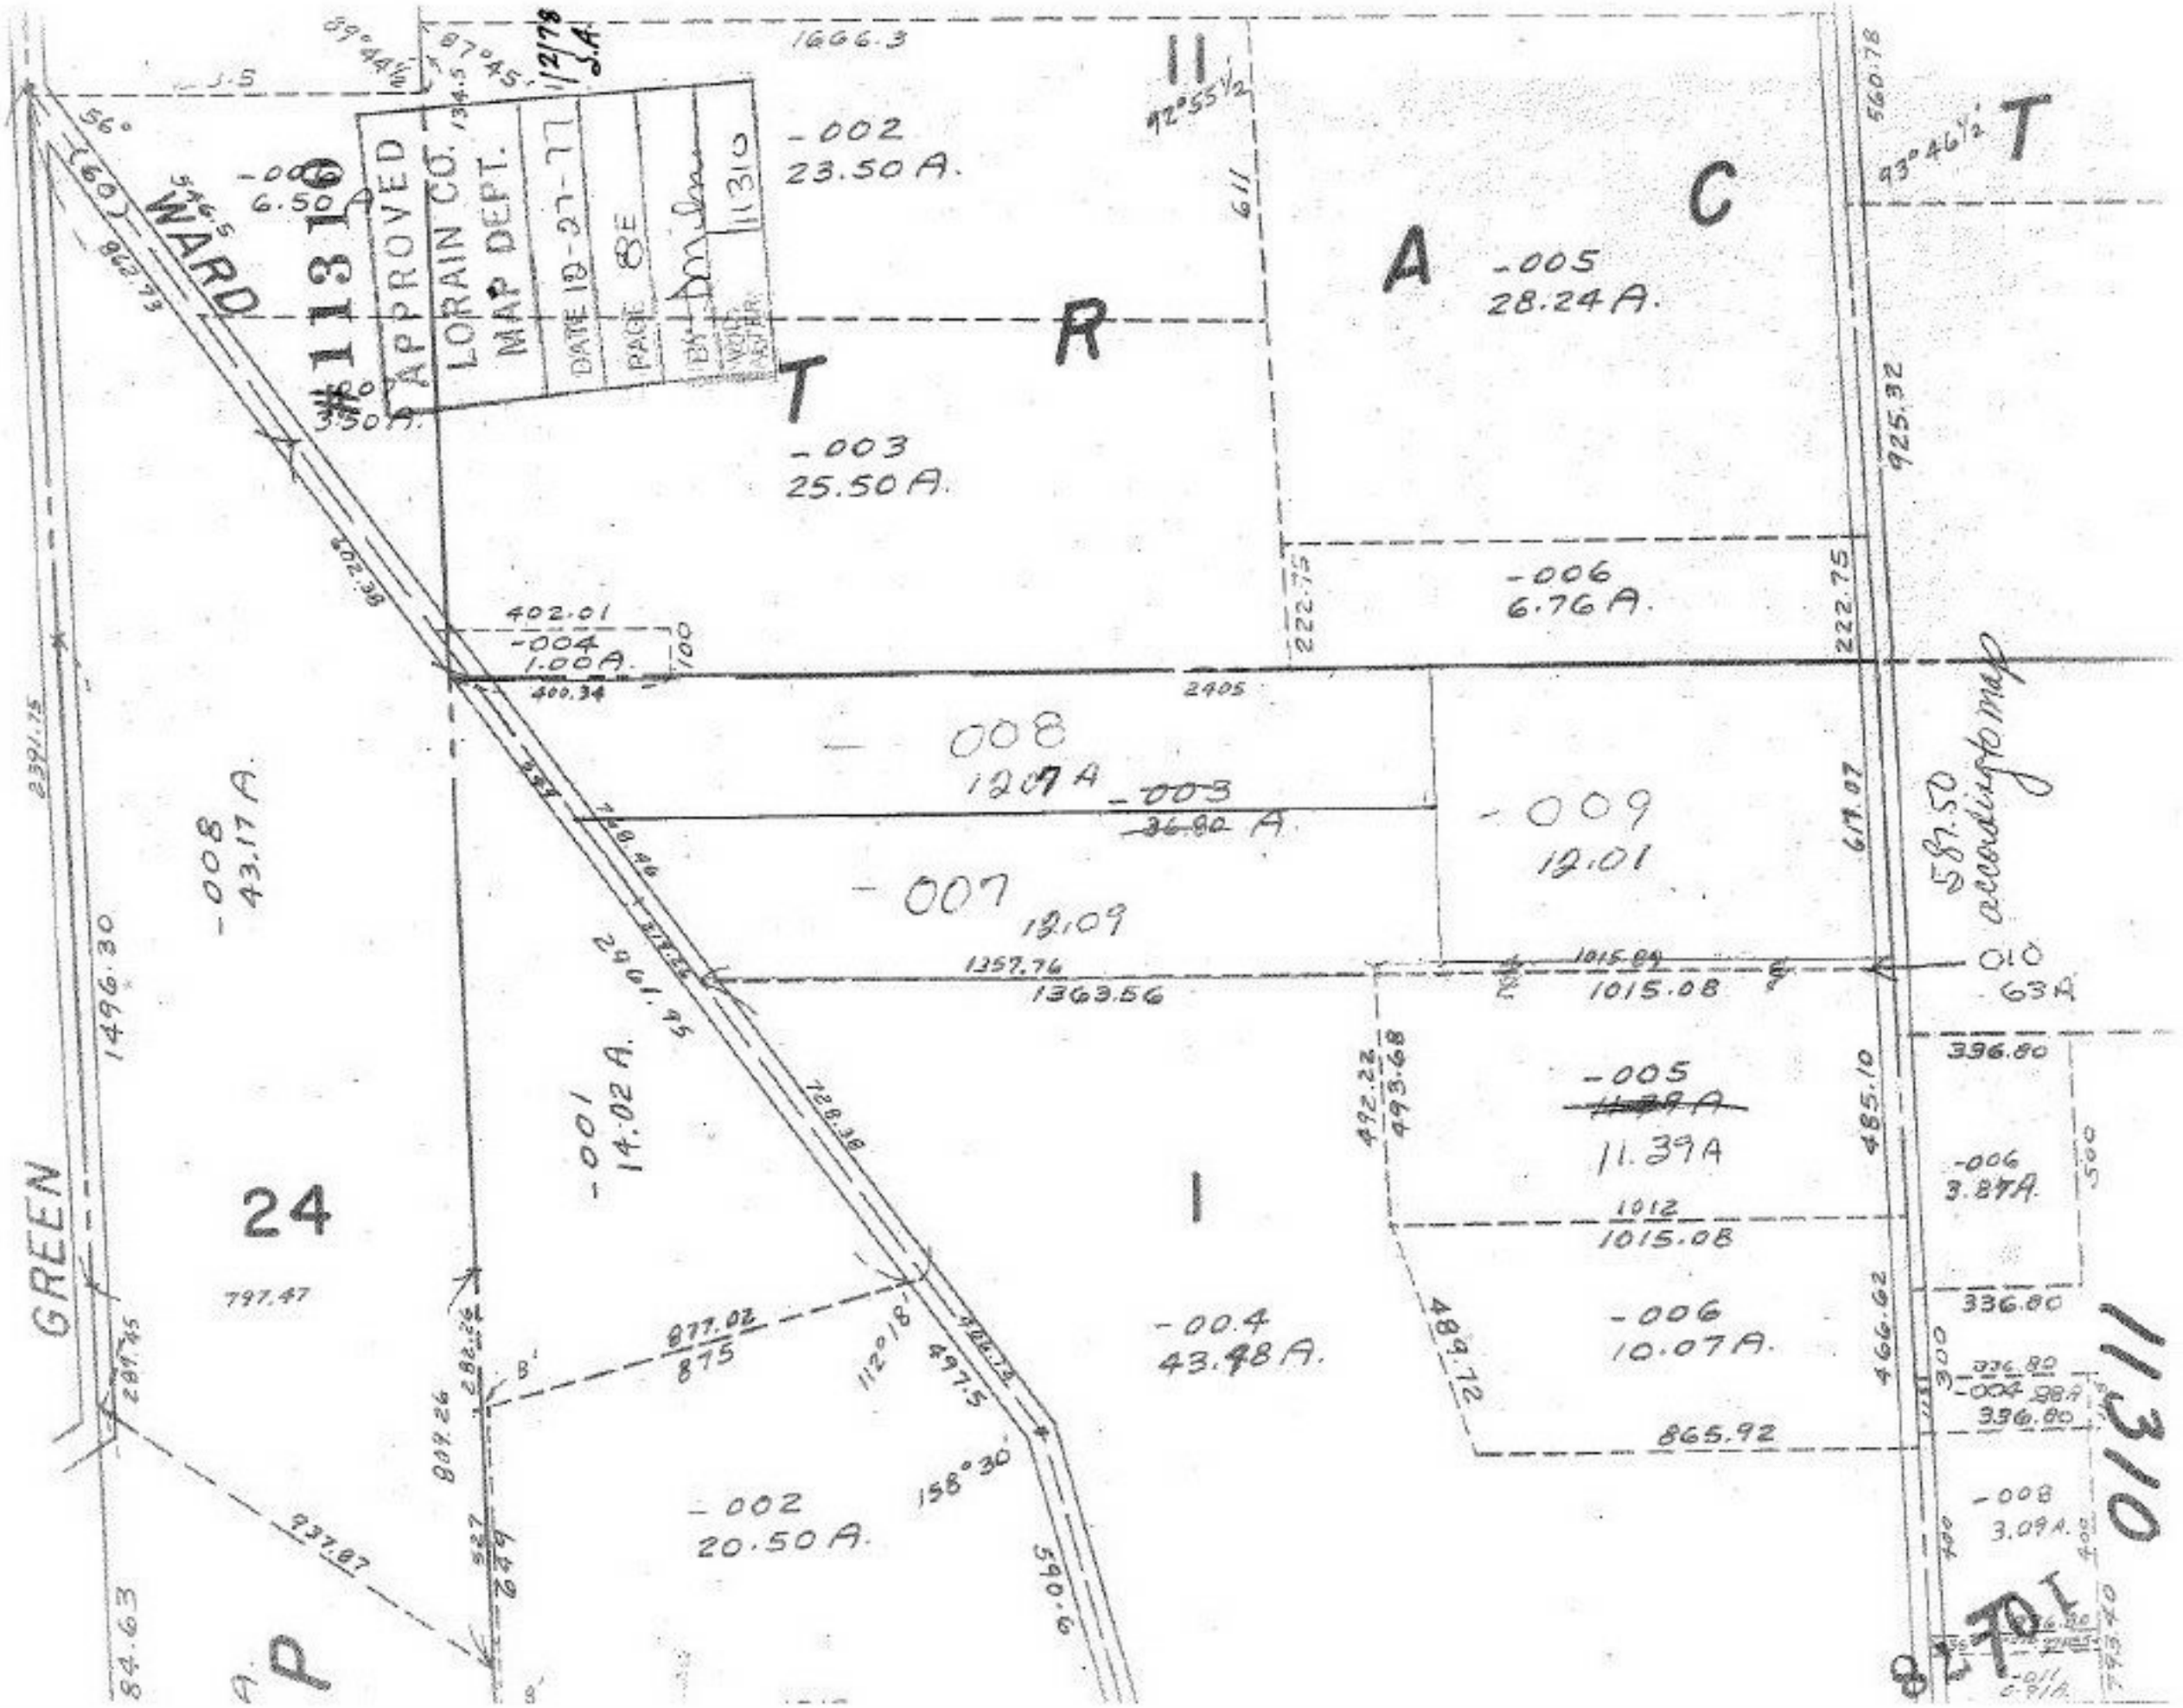

APPROVED
LORAIN CO.
MAP DEPT.
DATE 10-27-77
PAGE 8E
BY
WOD
11310
#11310
WARD
GREEN
24
T
R
A
C
T
-002
23.50 A.
-003
25.50 A.
-005
28.24 A.
-006
6.76 A.
-004
1.00 A.
-008
12.07 A
-003
36.80 A
-009
12.01
-007
12.09
-008
43.17 A.
-001
14.02 A.
-005
11.39 A
-006
3.87 A.
-006
10.07 A.
-004
43.48 A.
-002
20.50 A.
-008
3.09 A.
1666.3
1357.76
1363.56
1015.08
1012
1015.08
865.92
402.01
400.34
2405
2961.95
1496.30
797.47
877.02
875
112°18'
158°30'
590.6
497.5
489.72
492.22
493.68
485.10
466.62
396.80
336.80
587.50
according to map