# 11320

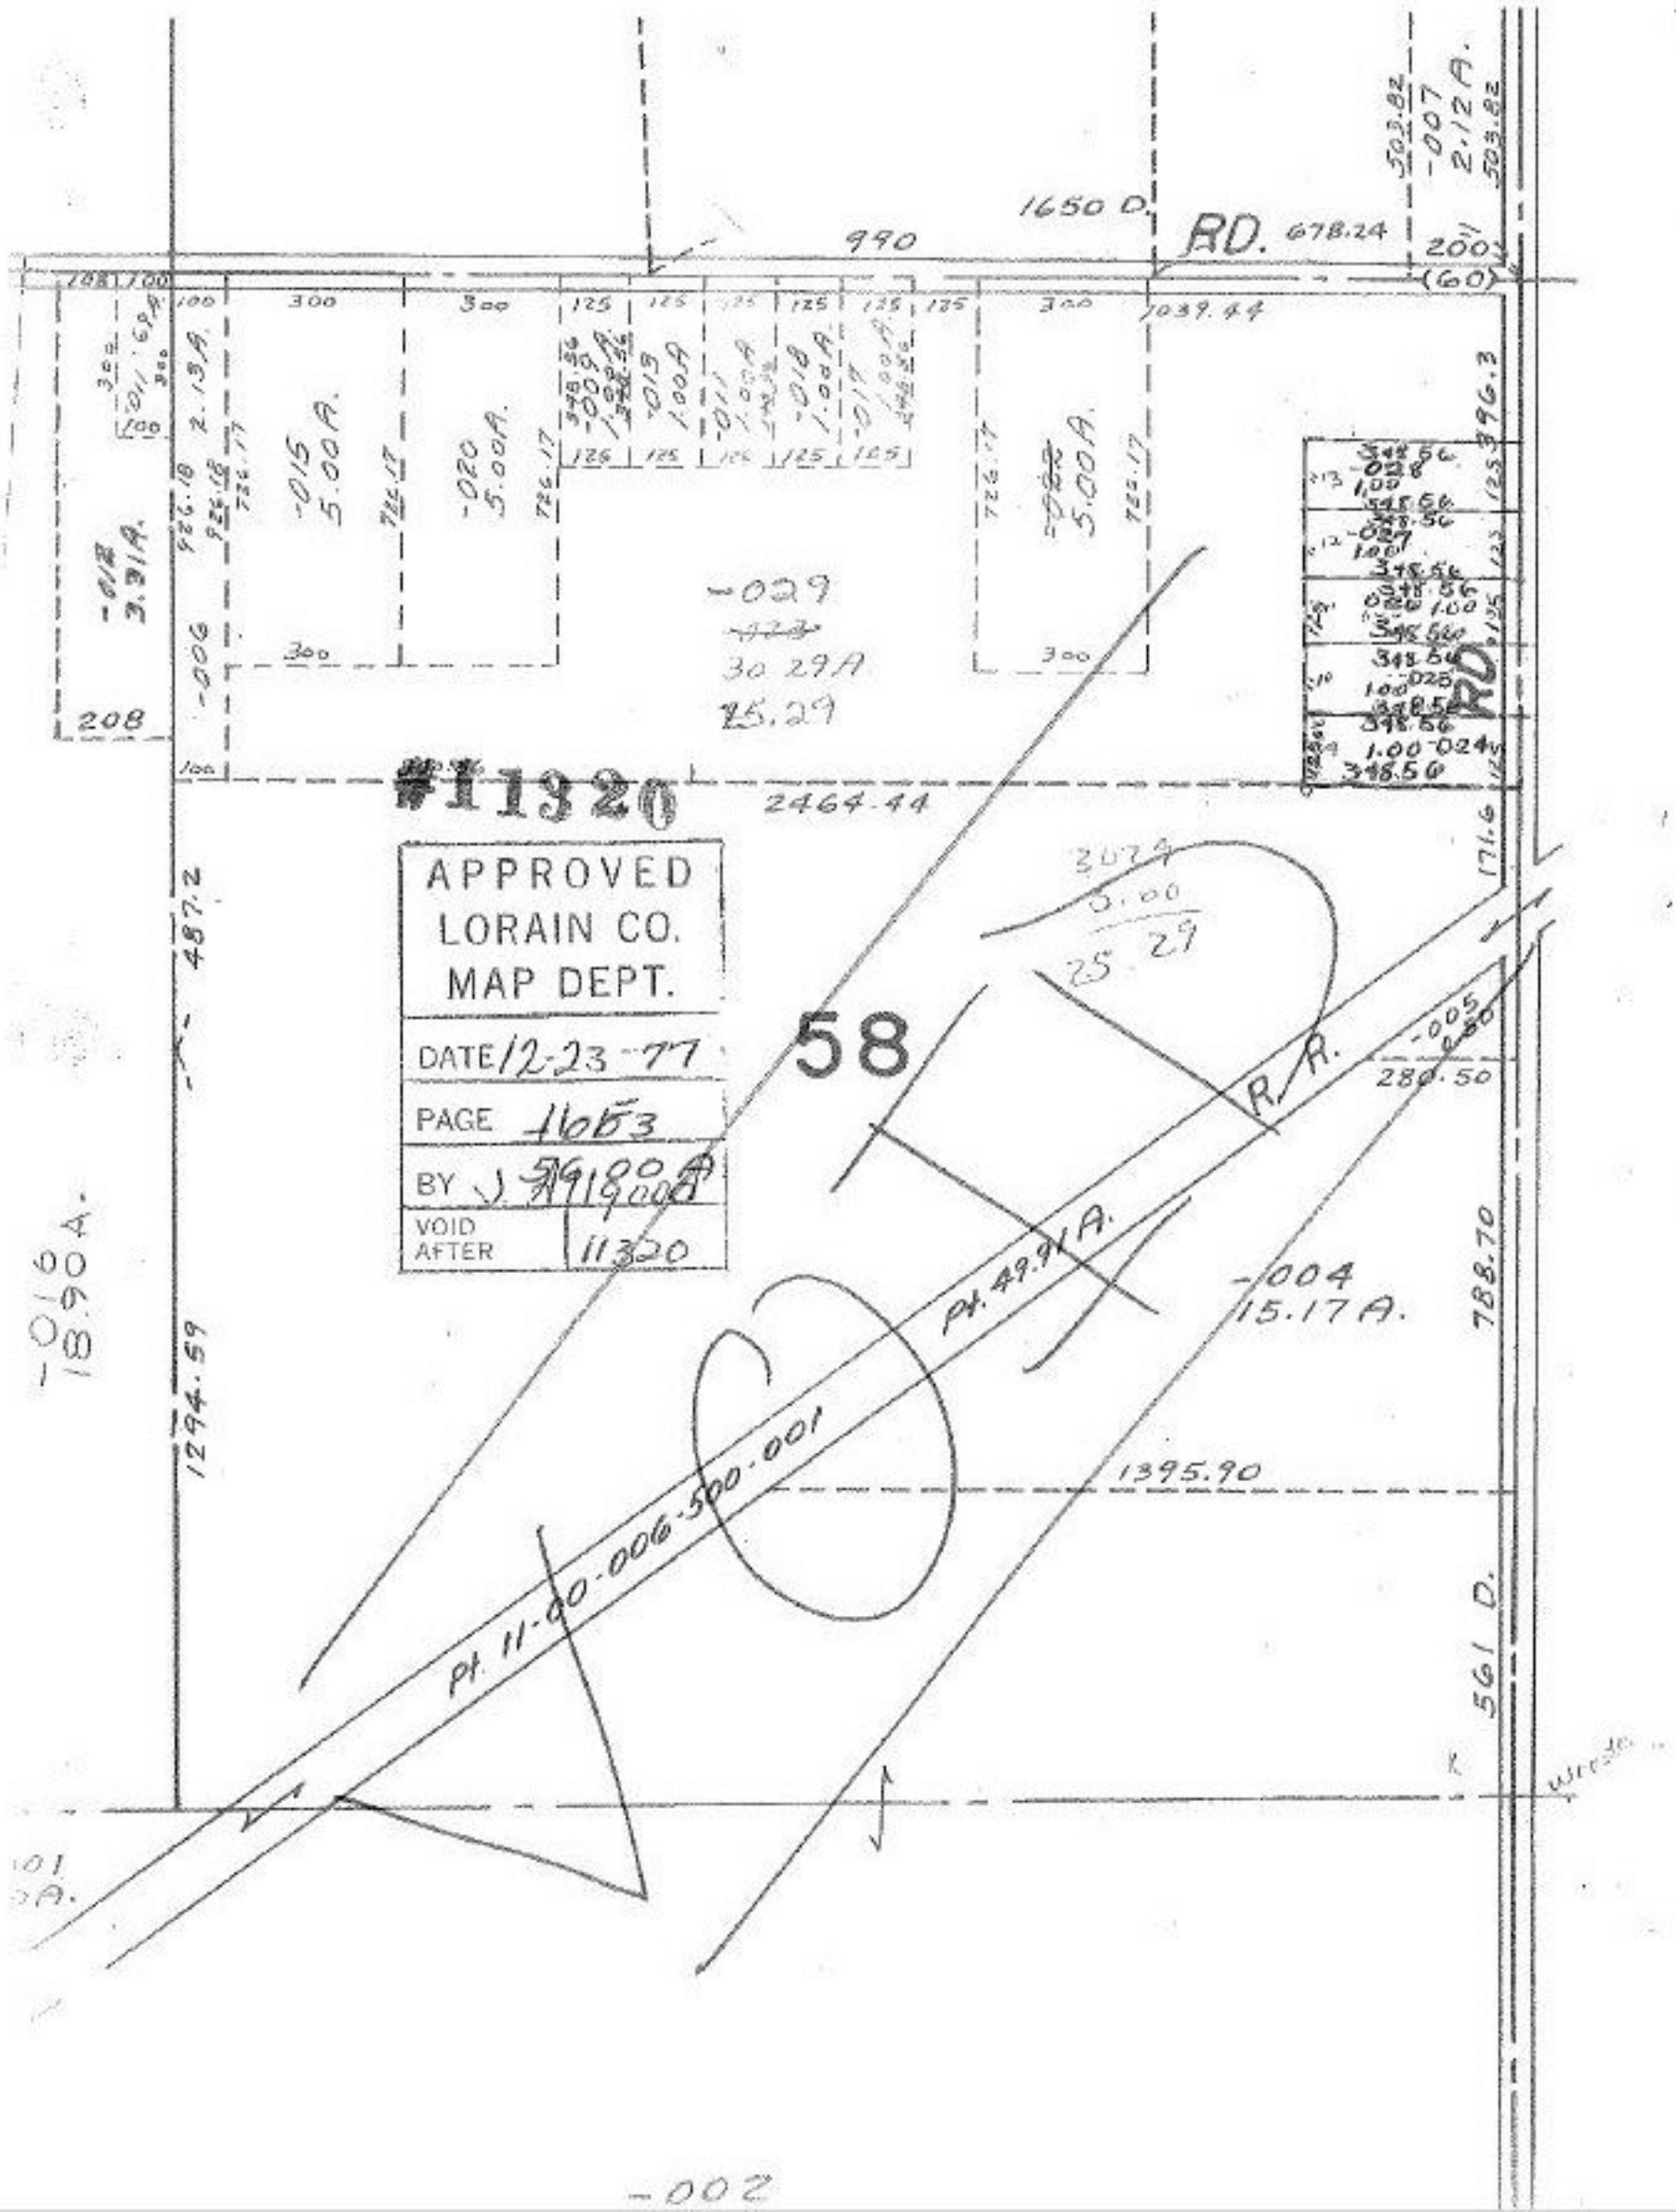

1650 D.
RD. 678.24
990
200
(60)
1039.44
-007
2.12 A.
503.82
-015
5.00 A.
-020
5.00 A.
-029
30.29 A
25.29
-012
3.31 A.
-006
208
2464.44
#11320
APPROVED
LORAIN CO.
MAP DEPT.
DATE 12-23-77
PAGE 1653
BY J. 56.00 A 19.00 A
VOID AFTER 11320
58
R. R.
Pt. 49.91 A.
Pt. 11-00-006-500-001
-004
15.17 A.
-005
280.50
788.70
1395.90
561 D.
487.2
1294.59
-016
18.90 A.
-002