11328
10-78

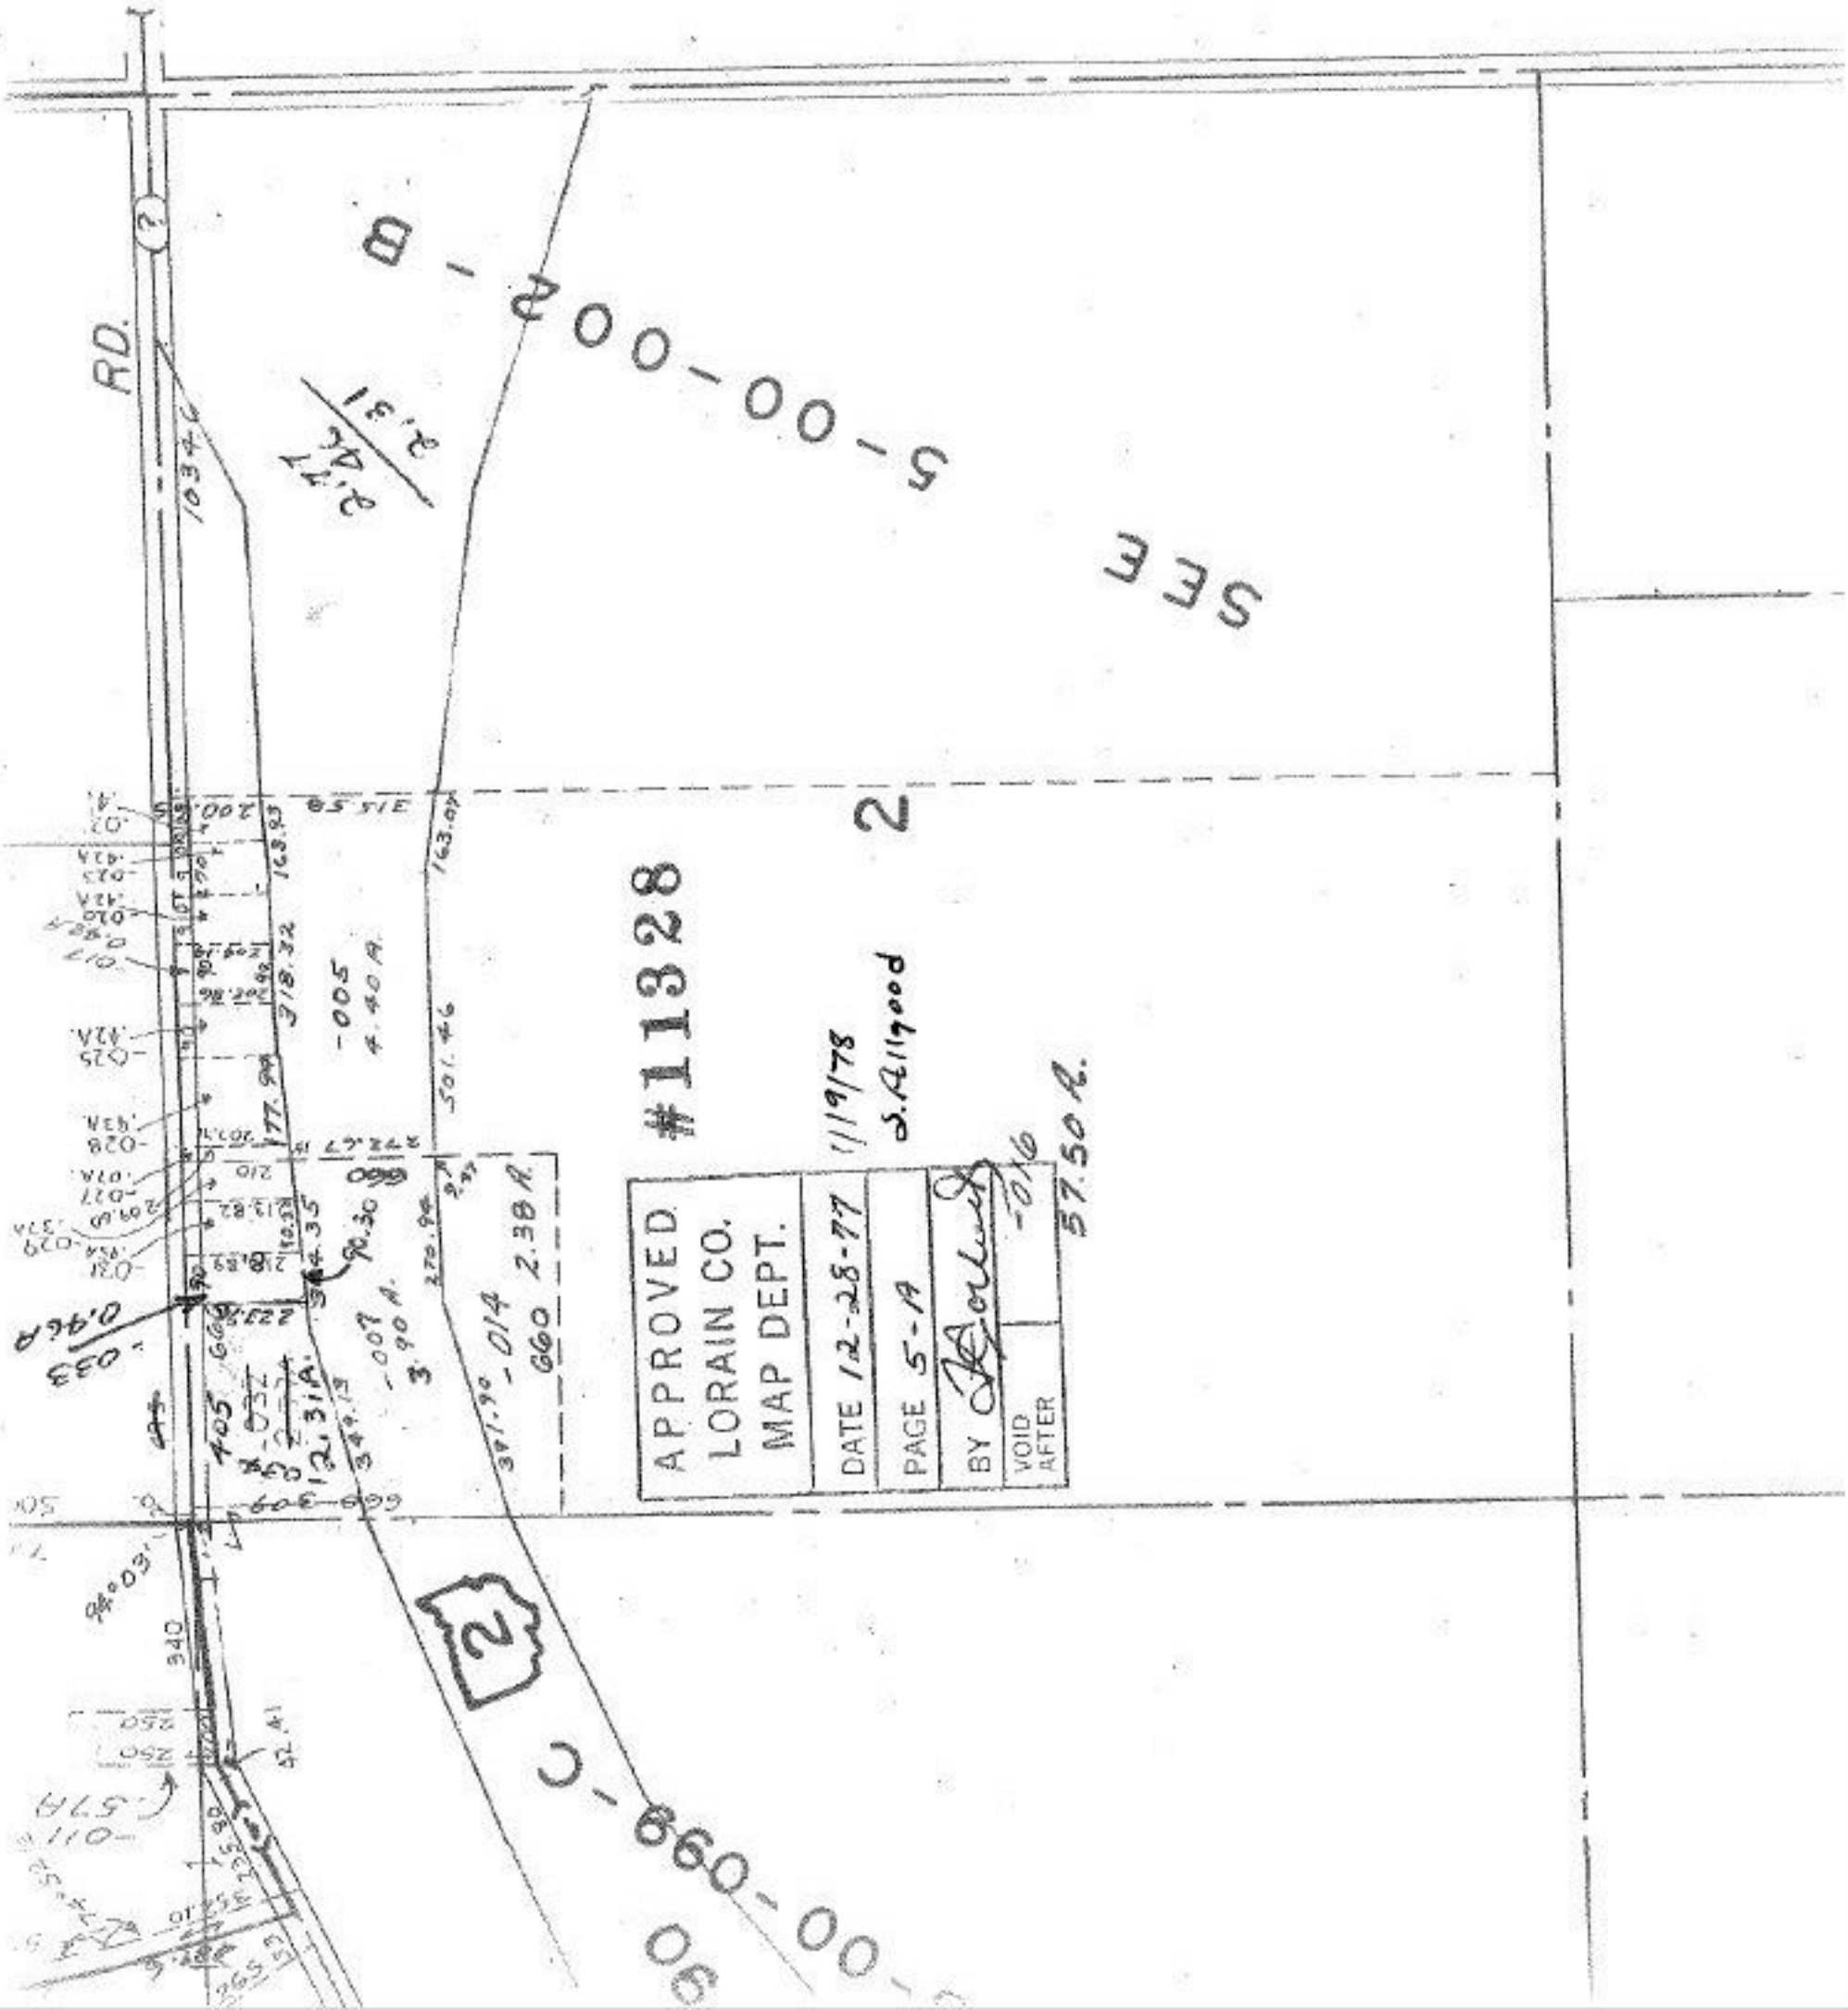

RD.
SEE 5-00-002-B
#11328
APPROVED
LORAIN CO.
MAP DEPT.
DATE 12-28-77
PAGE 5-A
BY
VOID AFTER
1/19/78
57.50 A.
2.38 A.
2.31
2.77
4.40 A.
-005
-014
-007
-033
-016
-011
-57A
-033
0.46 A