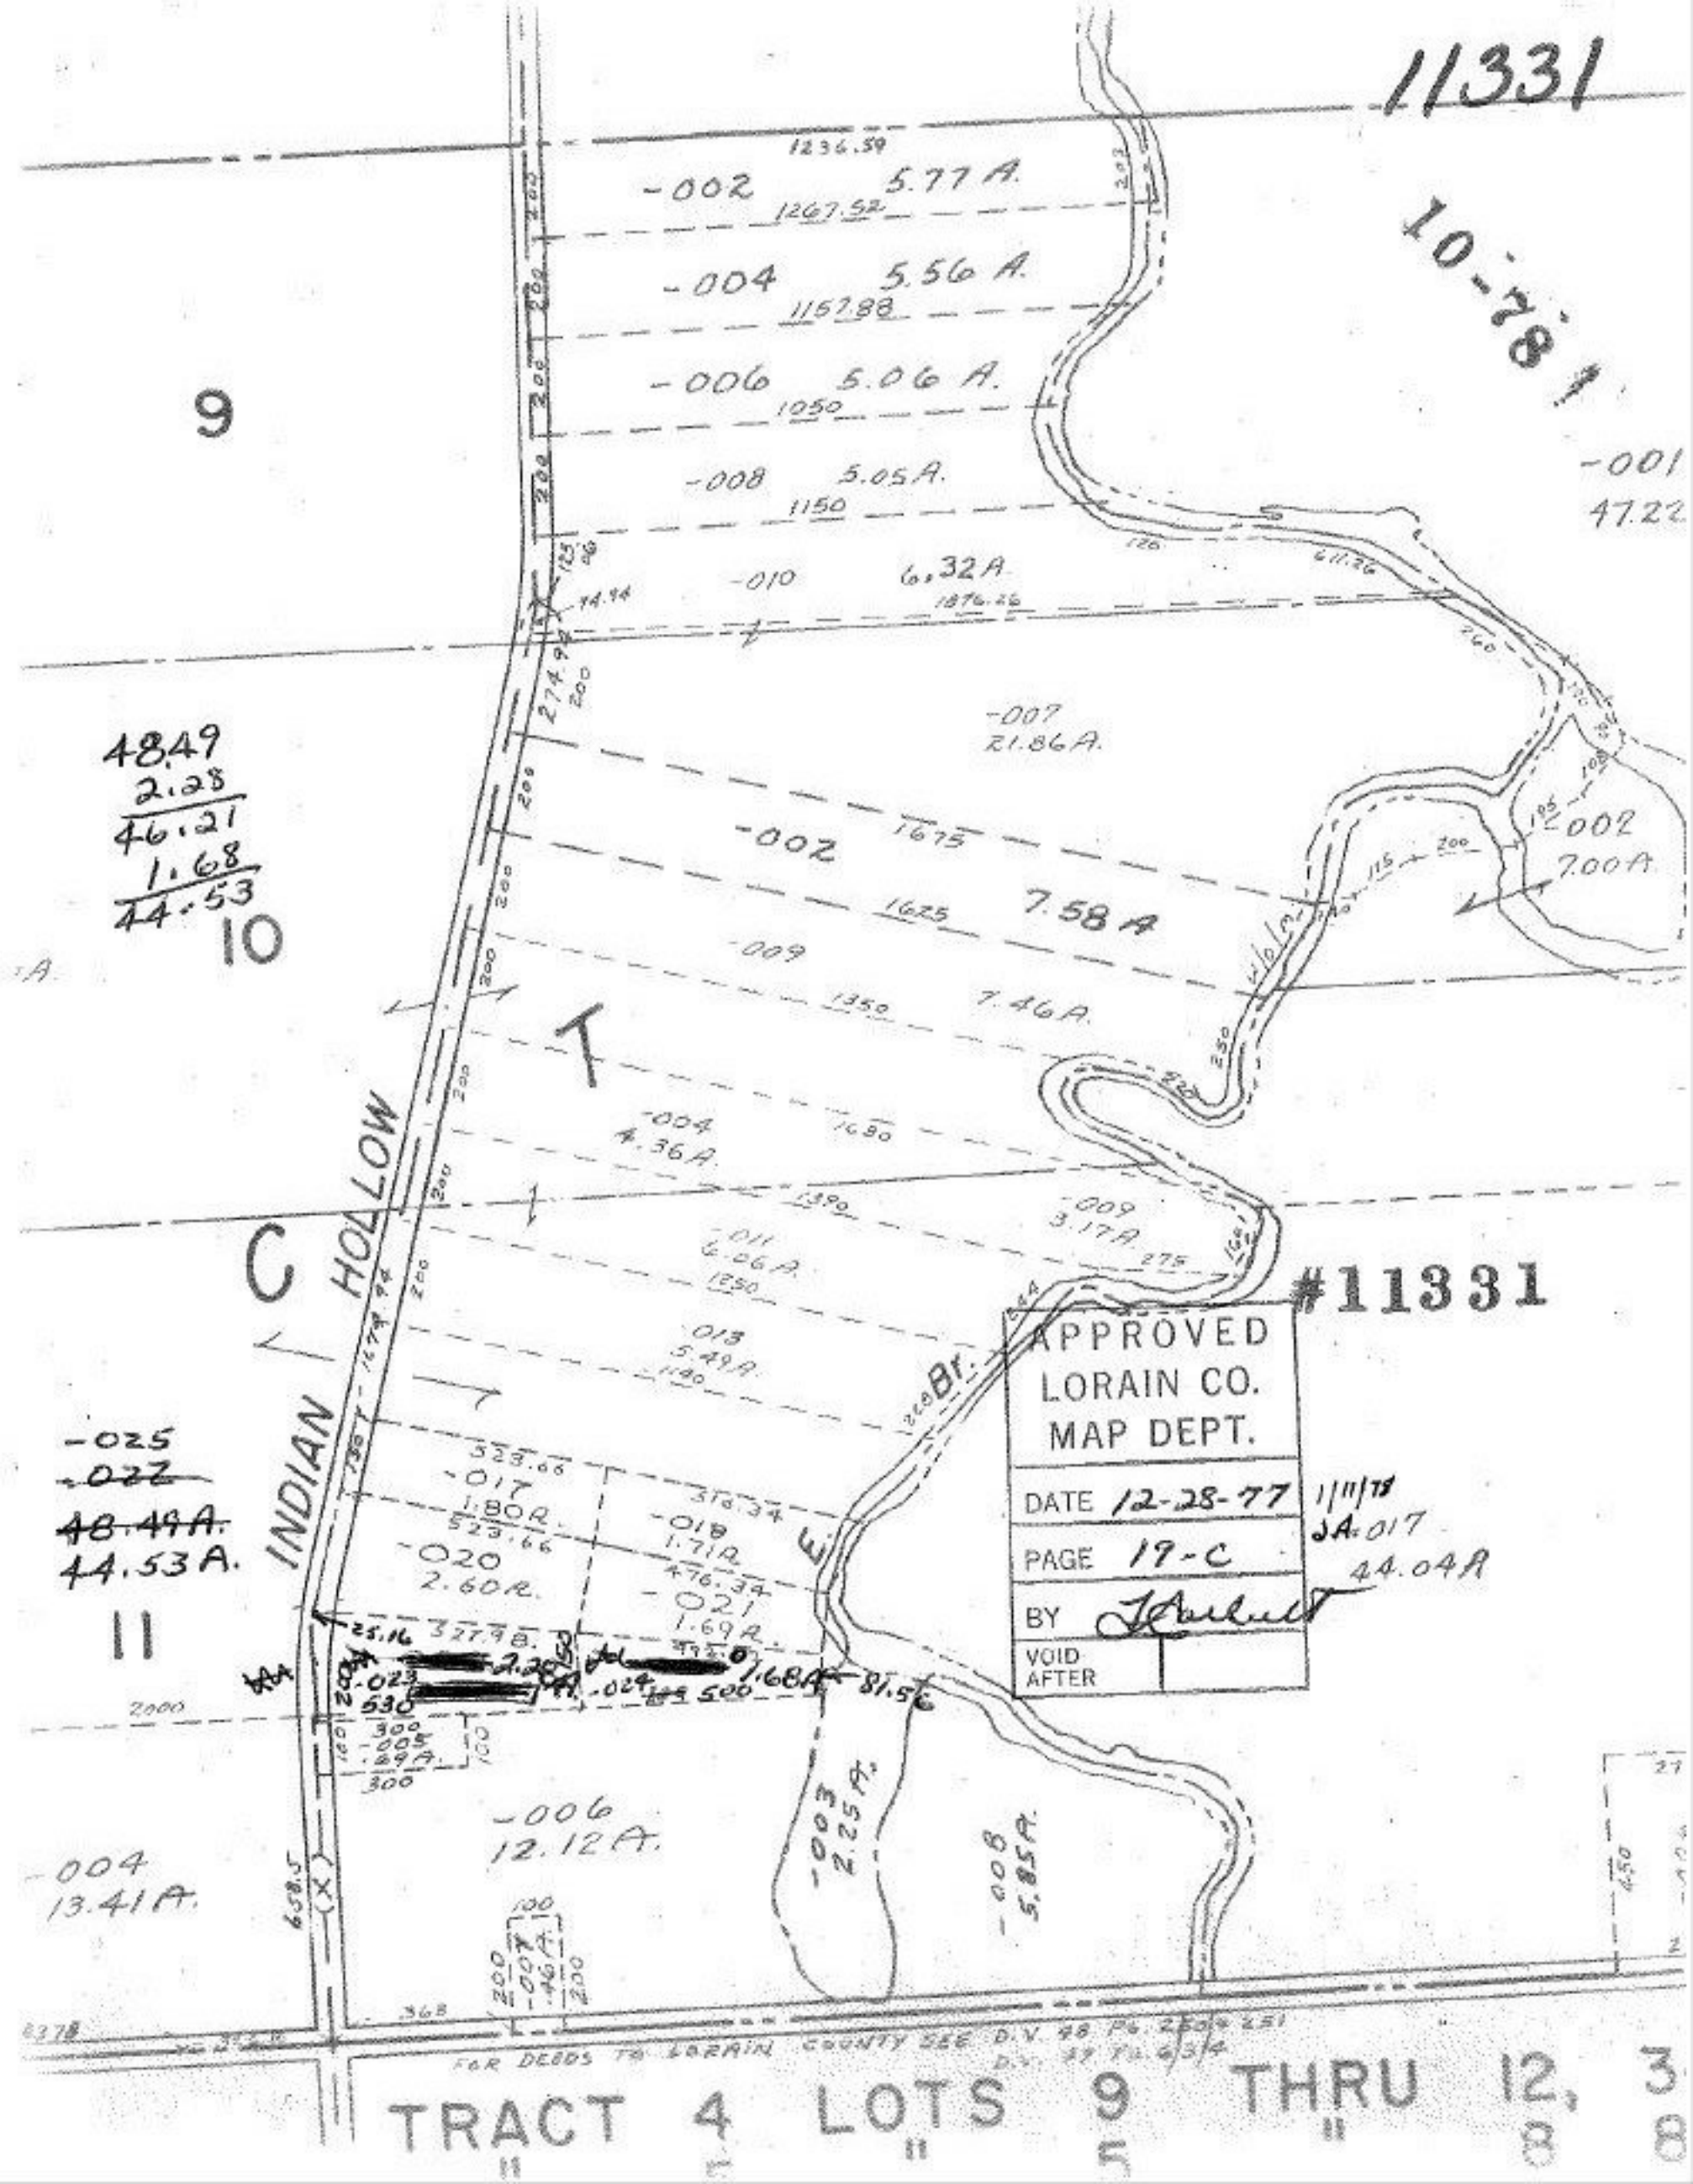
11331
10-78
9
10
11
INDIAN HOLLOW
-002 5.77 A.
-004 5.56 A.
-006 5.06 A.
-008 5.05 A.
-010 6.32 A.
-007 21.86 A.
-002 7.58 A
-009 7.46 A.
-004 4.36 A.
-011 6.06 A.
-013 5.49 A.
-009 3.17 A.
-001 47.22
-002 7.00 A.
48.49
2.28
46.21
1.68
44.53
-025
~~-022~~
~~48.49 A.~~
44.53 A.
-017 1.80 A.
-020 2.60 A.
-018 1.71 A.
-021 1.69 A.
-006 12.12 A.
-004 13.41 A.
-003 2.25 A.
-008 5.85 A.
-017 44.04 A
#11331
APPROVED
LORAIN CO.
MAP DEPT.
DATE 12-28-77
PAGE 19-C
BY
VOID AFTER
FOR DEEDS TO LORAIN COUNTY SEE D.V. 48 PG. 250 & 251
TRACT 4 LOTS 9 THRU 12, 3