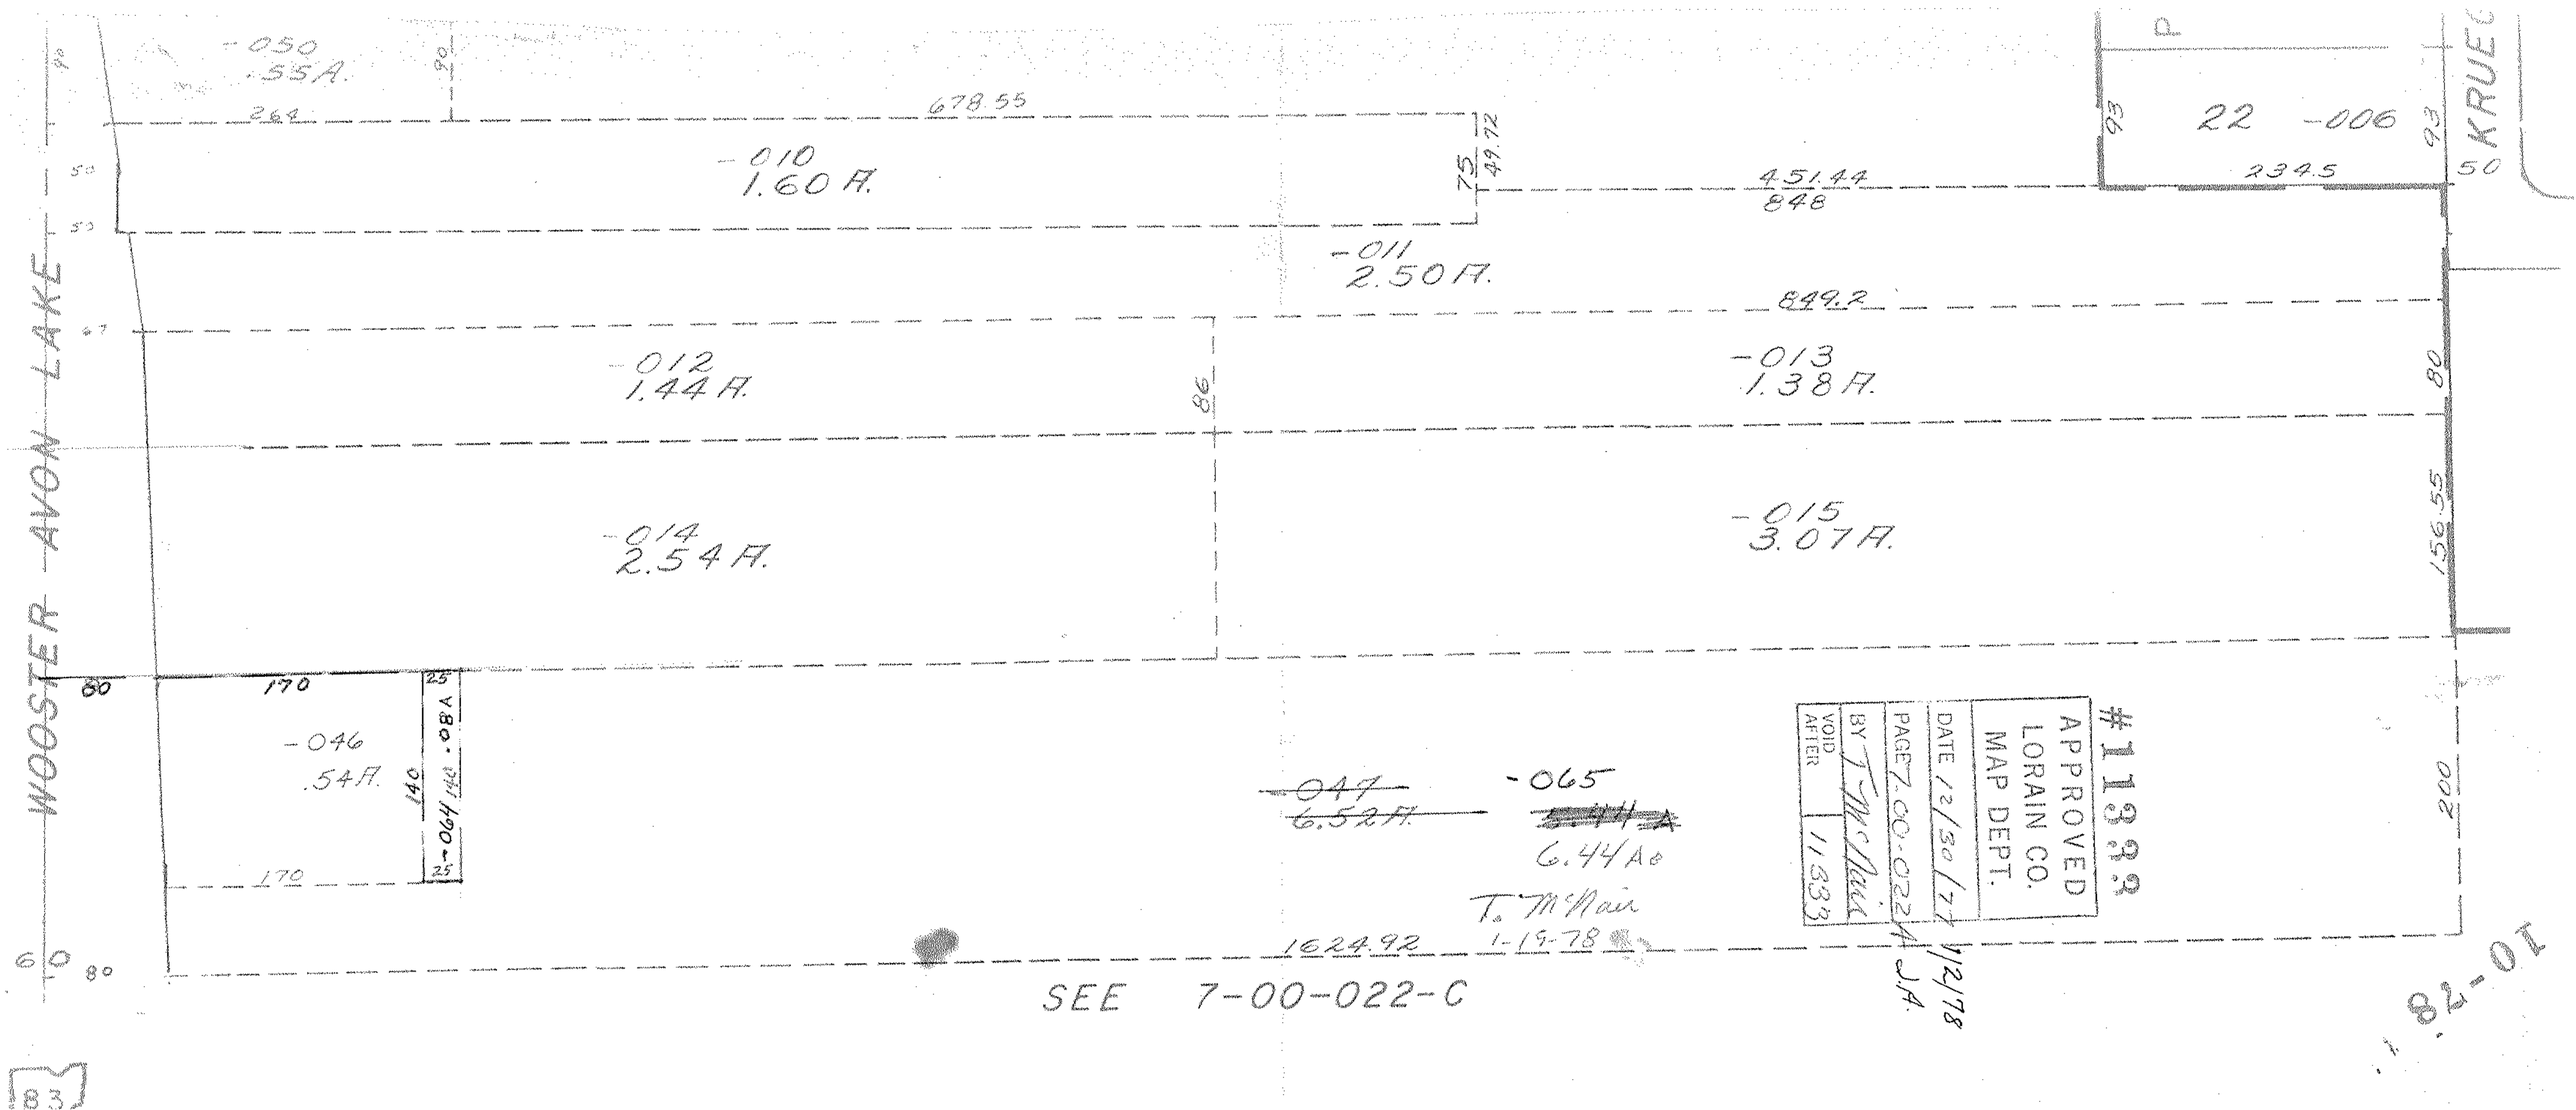
WOOSTER AVON LAKE
KRUE
-050
.55A.
264
678.55
-010
1.60A.
75
49.72
451.44
848
22 -006
234.5
93
50
-011
2.50A.
849.2
-012
1.44A.
-013
1.38A.
86
80
-014
2.54A.
-015
3.07A.
156.55
60
170
-046
.54A.
140
25
-064 .08A
170
-047
6.52A.
-065
6.44Ac
T. McNair
1-19-78
1624.92
200
APPROVED
LORAIN CO.
MAP DEPT.
DATE 12/30/77
PAGE 7-00-022
BY J. McNeil
VOID AFTER 11/333
1/12/78
J.A.
SEE 7-00-022-C
7-00-022
83