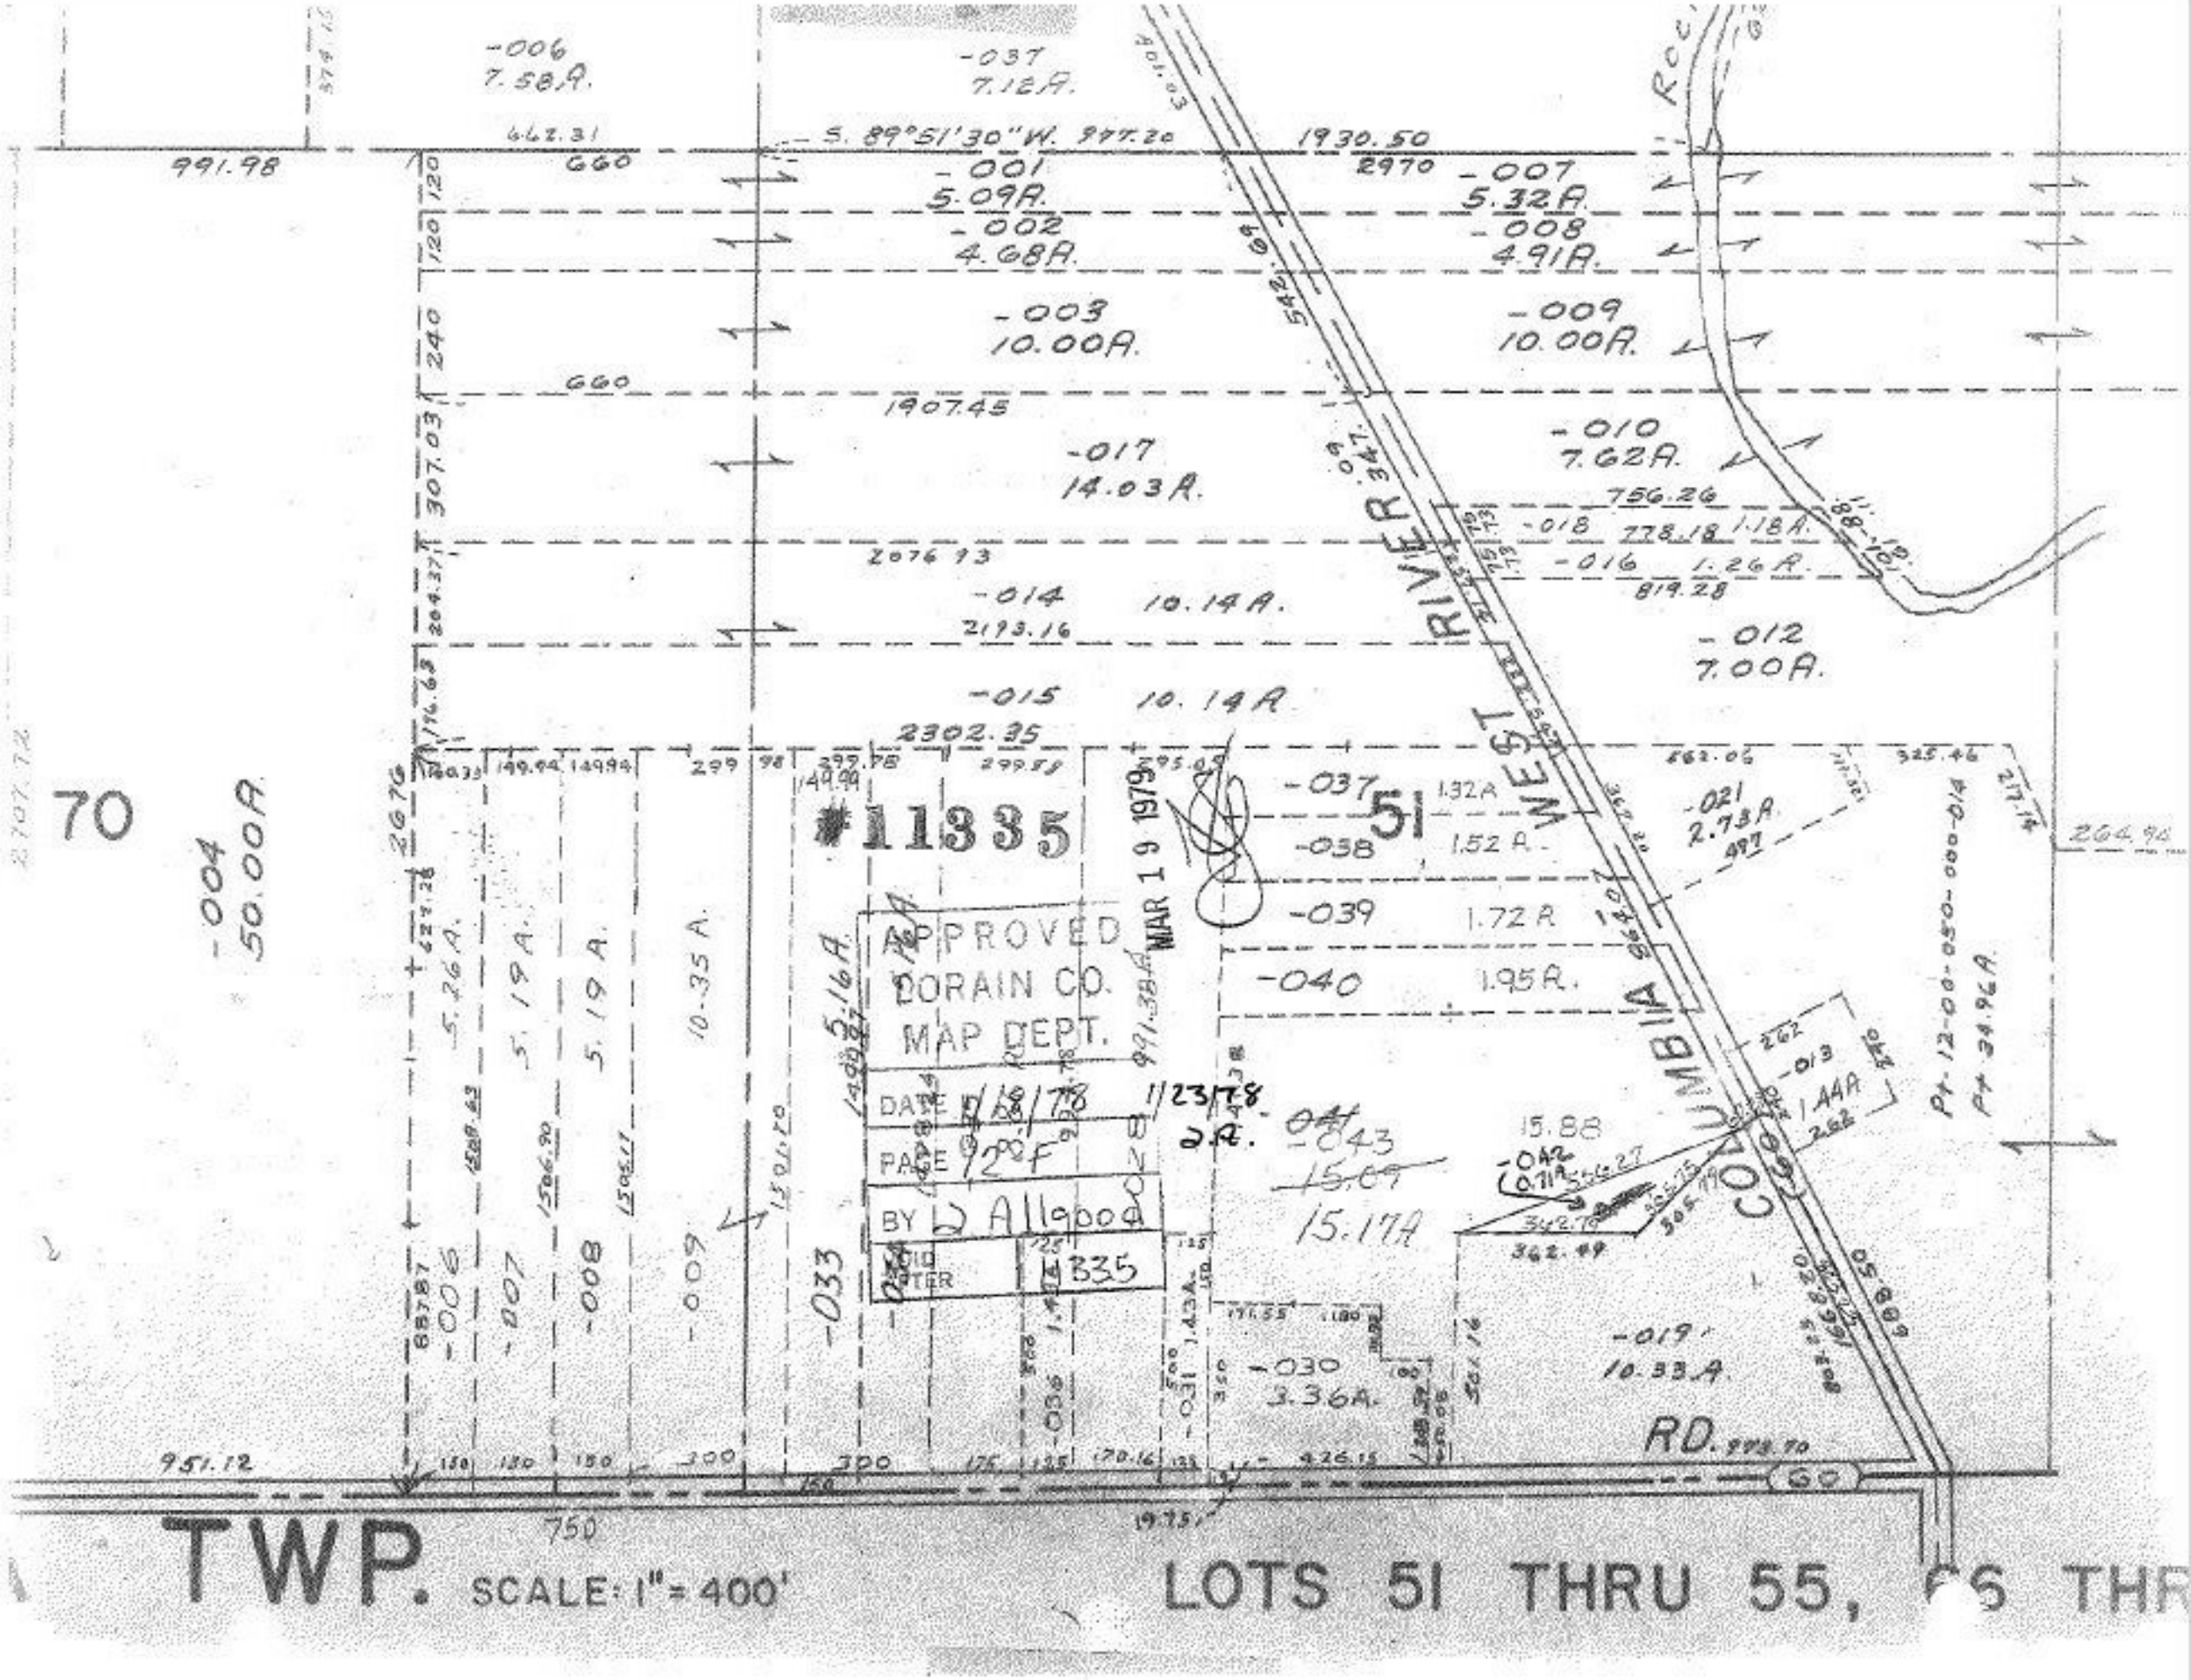

-006
7.58A.
-037
7.12A.
S. 89°51'30"W. 977.20
1930.50
2970
991.98
660
-001
5.09A.
-002
4.68A.
-003
10.00A.
-007
5.32A.
-008
4.91A.
-009
10.00A.
-010
7.62A.
1907.45
-017
14.03A.
756.26
-018
778.18
1.18A.
-016
1.26A.
819.28
2076.93
-014
10.14A.
2193.16
-012
7.00A.
-015
10.14A.
2302.35
70
-004
50.00A.
#11335
MAR 19 1979
51
-037
1.32A
-038
1.52A.
-039
1.72A
-040
1.95A.
-021
2.73A.
264.94
APPROVED
LORAIN CO.
MAP DEPT.
DATE 1/18/78
PAGE 12 F
BY L Allgood
LOTS 51 THRU 55, 56 THR
-043
15.17A
15.88
-019
10.33A.
-030
3.36A.
RD.
951.12
750
TWP.
SCALE: 1" = 400'