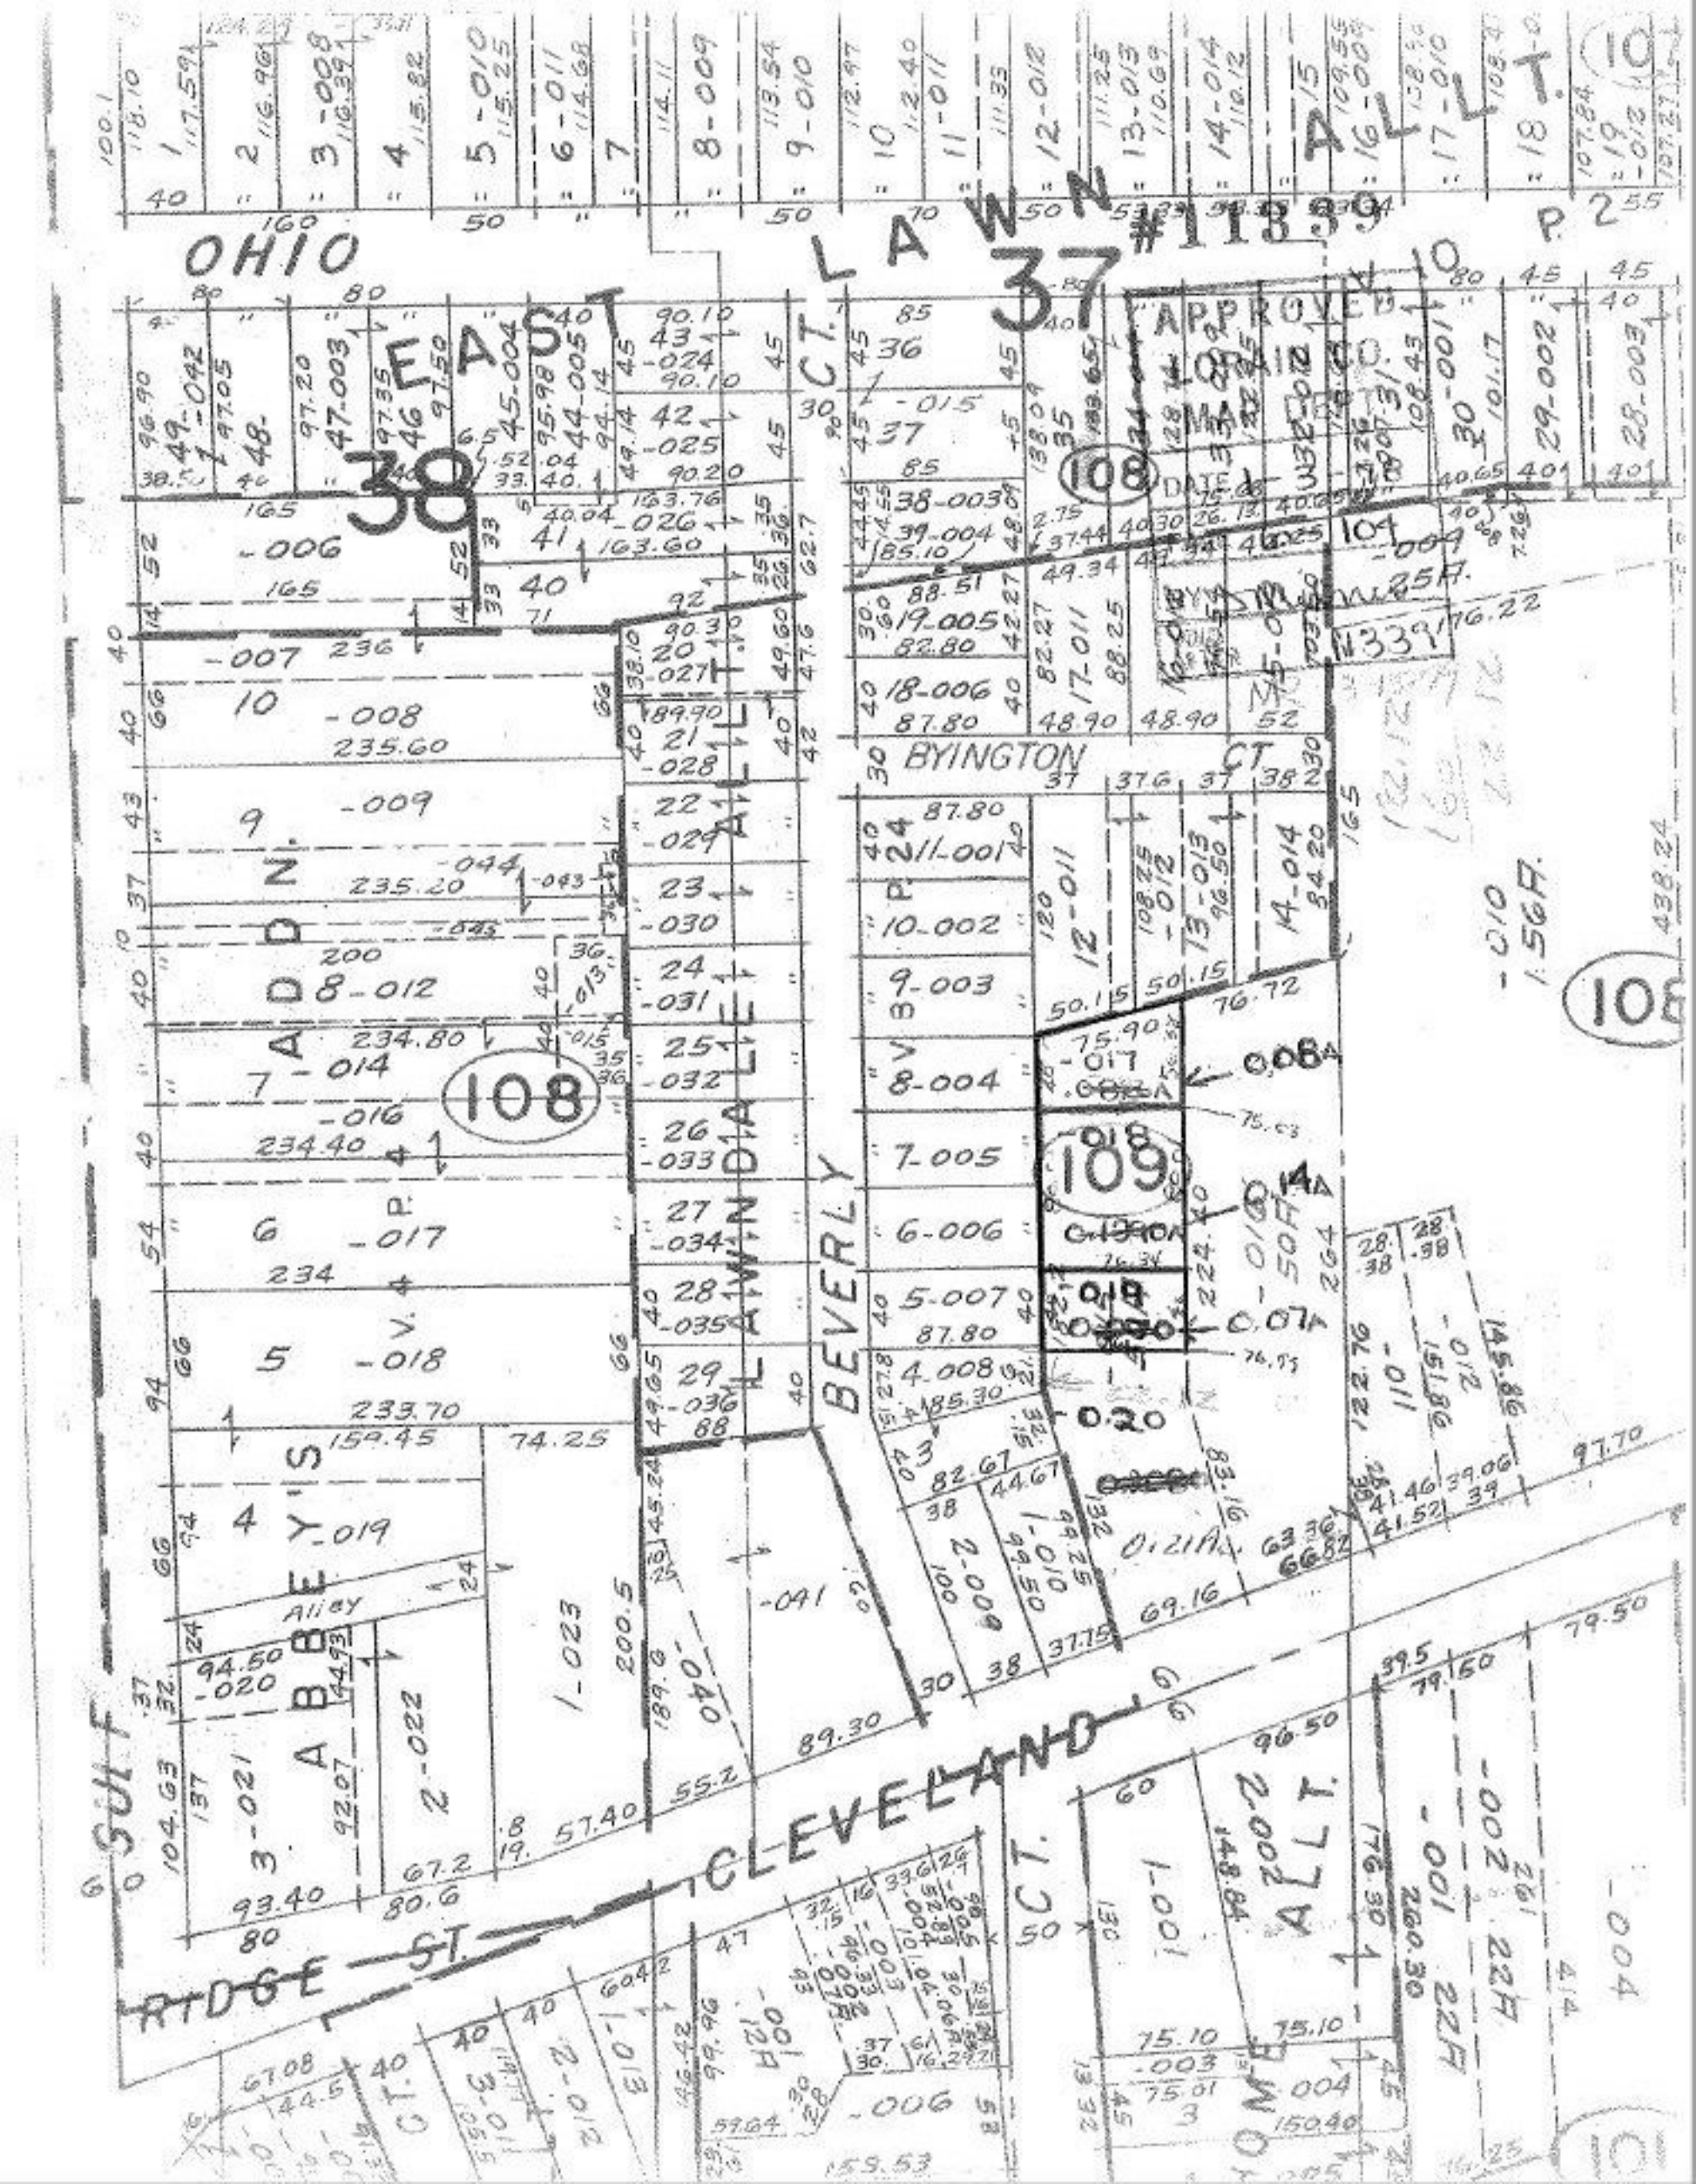

OHIO
EAST
LAWN
#11339
37
38
APPROVED
LORAIN CO.
MAP DEPT.
DATE
108
109
BYINGTON CT.
BEVERLY
LAWNDALE ALLT.
ADDN.
ABBEY'S
Alley
CLEVELAND
RIDGE ST.
SULF
CT.
ALLT.