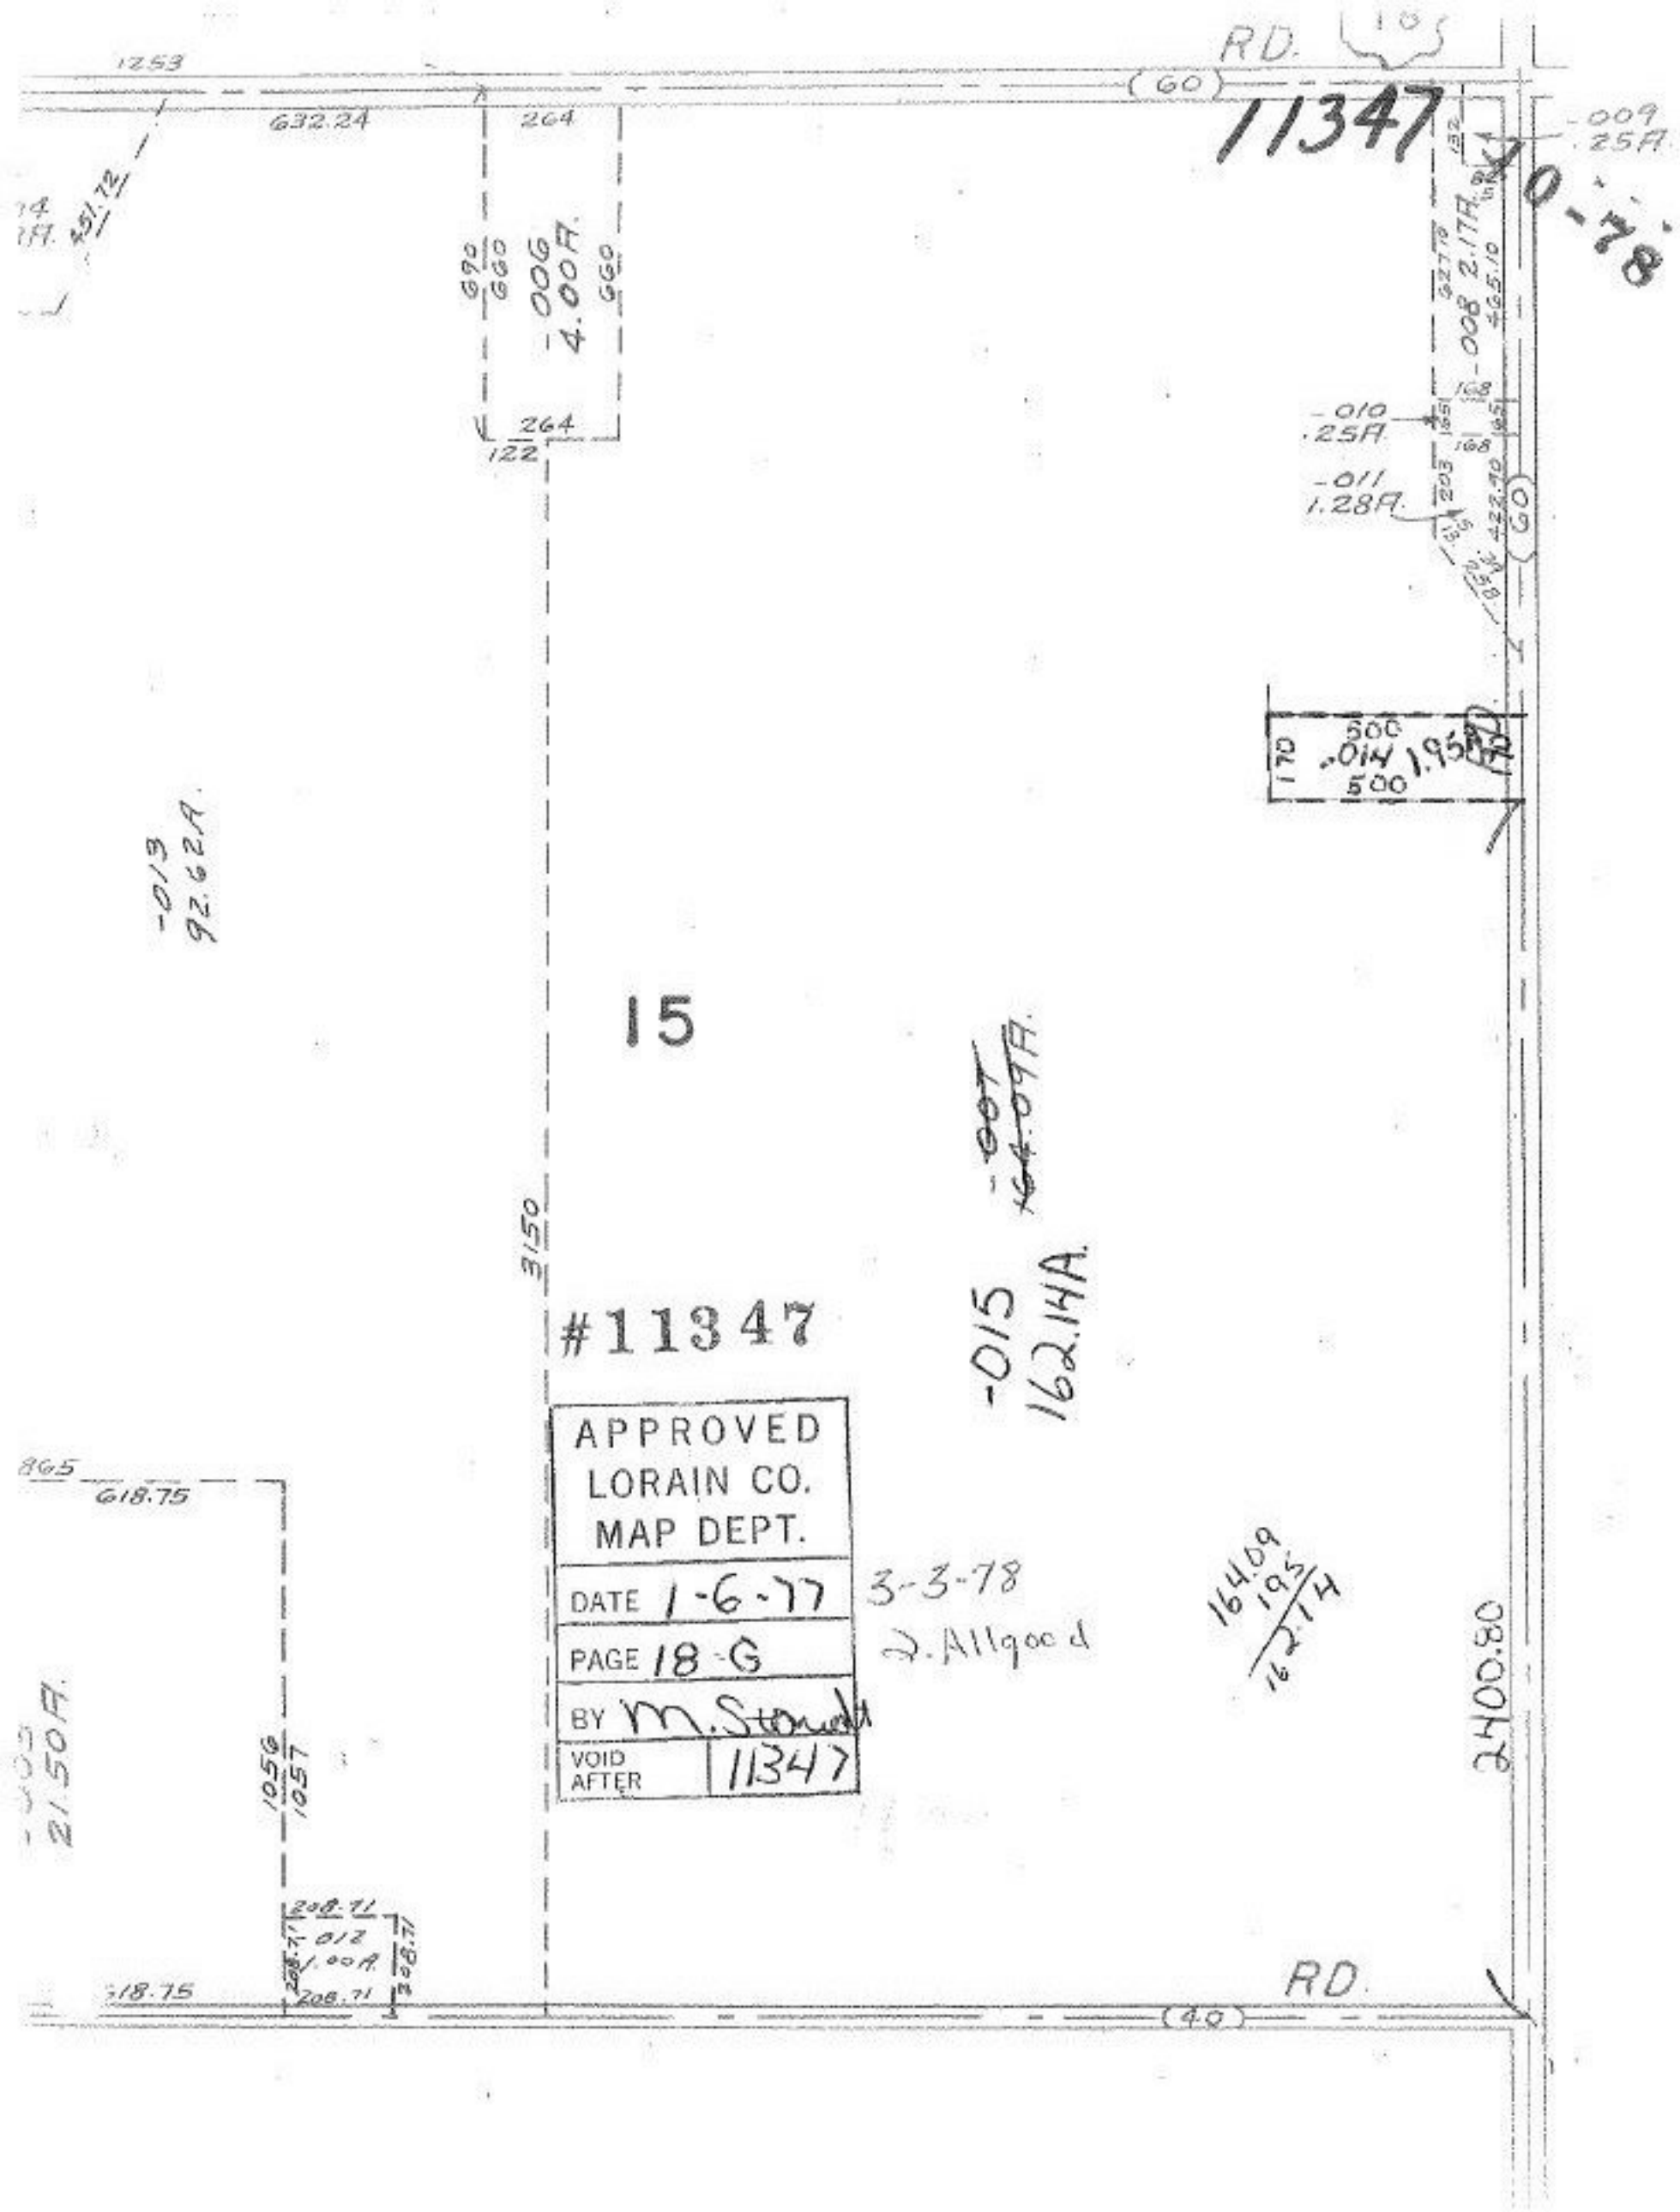

RD.
11347
10-78
1253
632.24
264
690
660
-006
4.00A.
660
264
122
-009
.25A.
-008 2.17A.
-010
.25A.
-011
1.28A.
500
-014 1.95A.
500
-013
92.62A.
15
3150
-015
162.14A.
#11347
APPROVED
LORAIN CO.
MAP DEPT.
DATE 1-6-77
PAGE 18-G
BY M. Stoneth
VOID AFTER 11347
3-3-78
2. Allgood
164.09
195
162.14
2400.80
865
618.75
1056
1057
21.50A.
208.71
-012
1.00A.
208.71
618.75
RD.