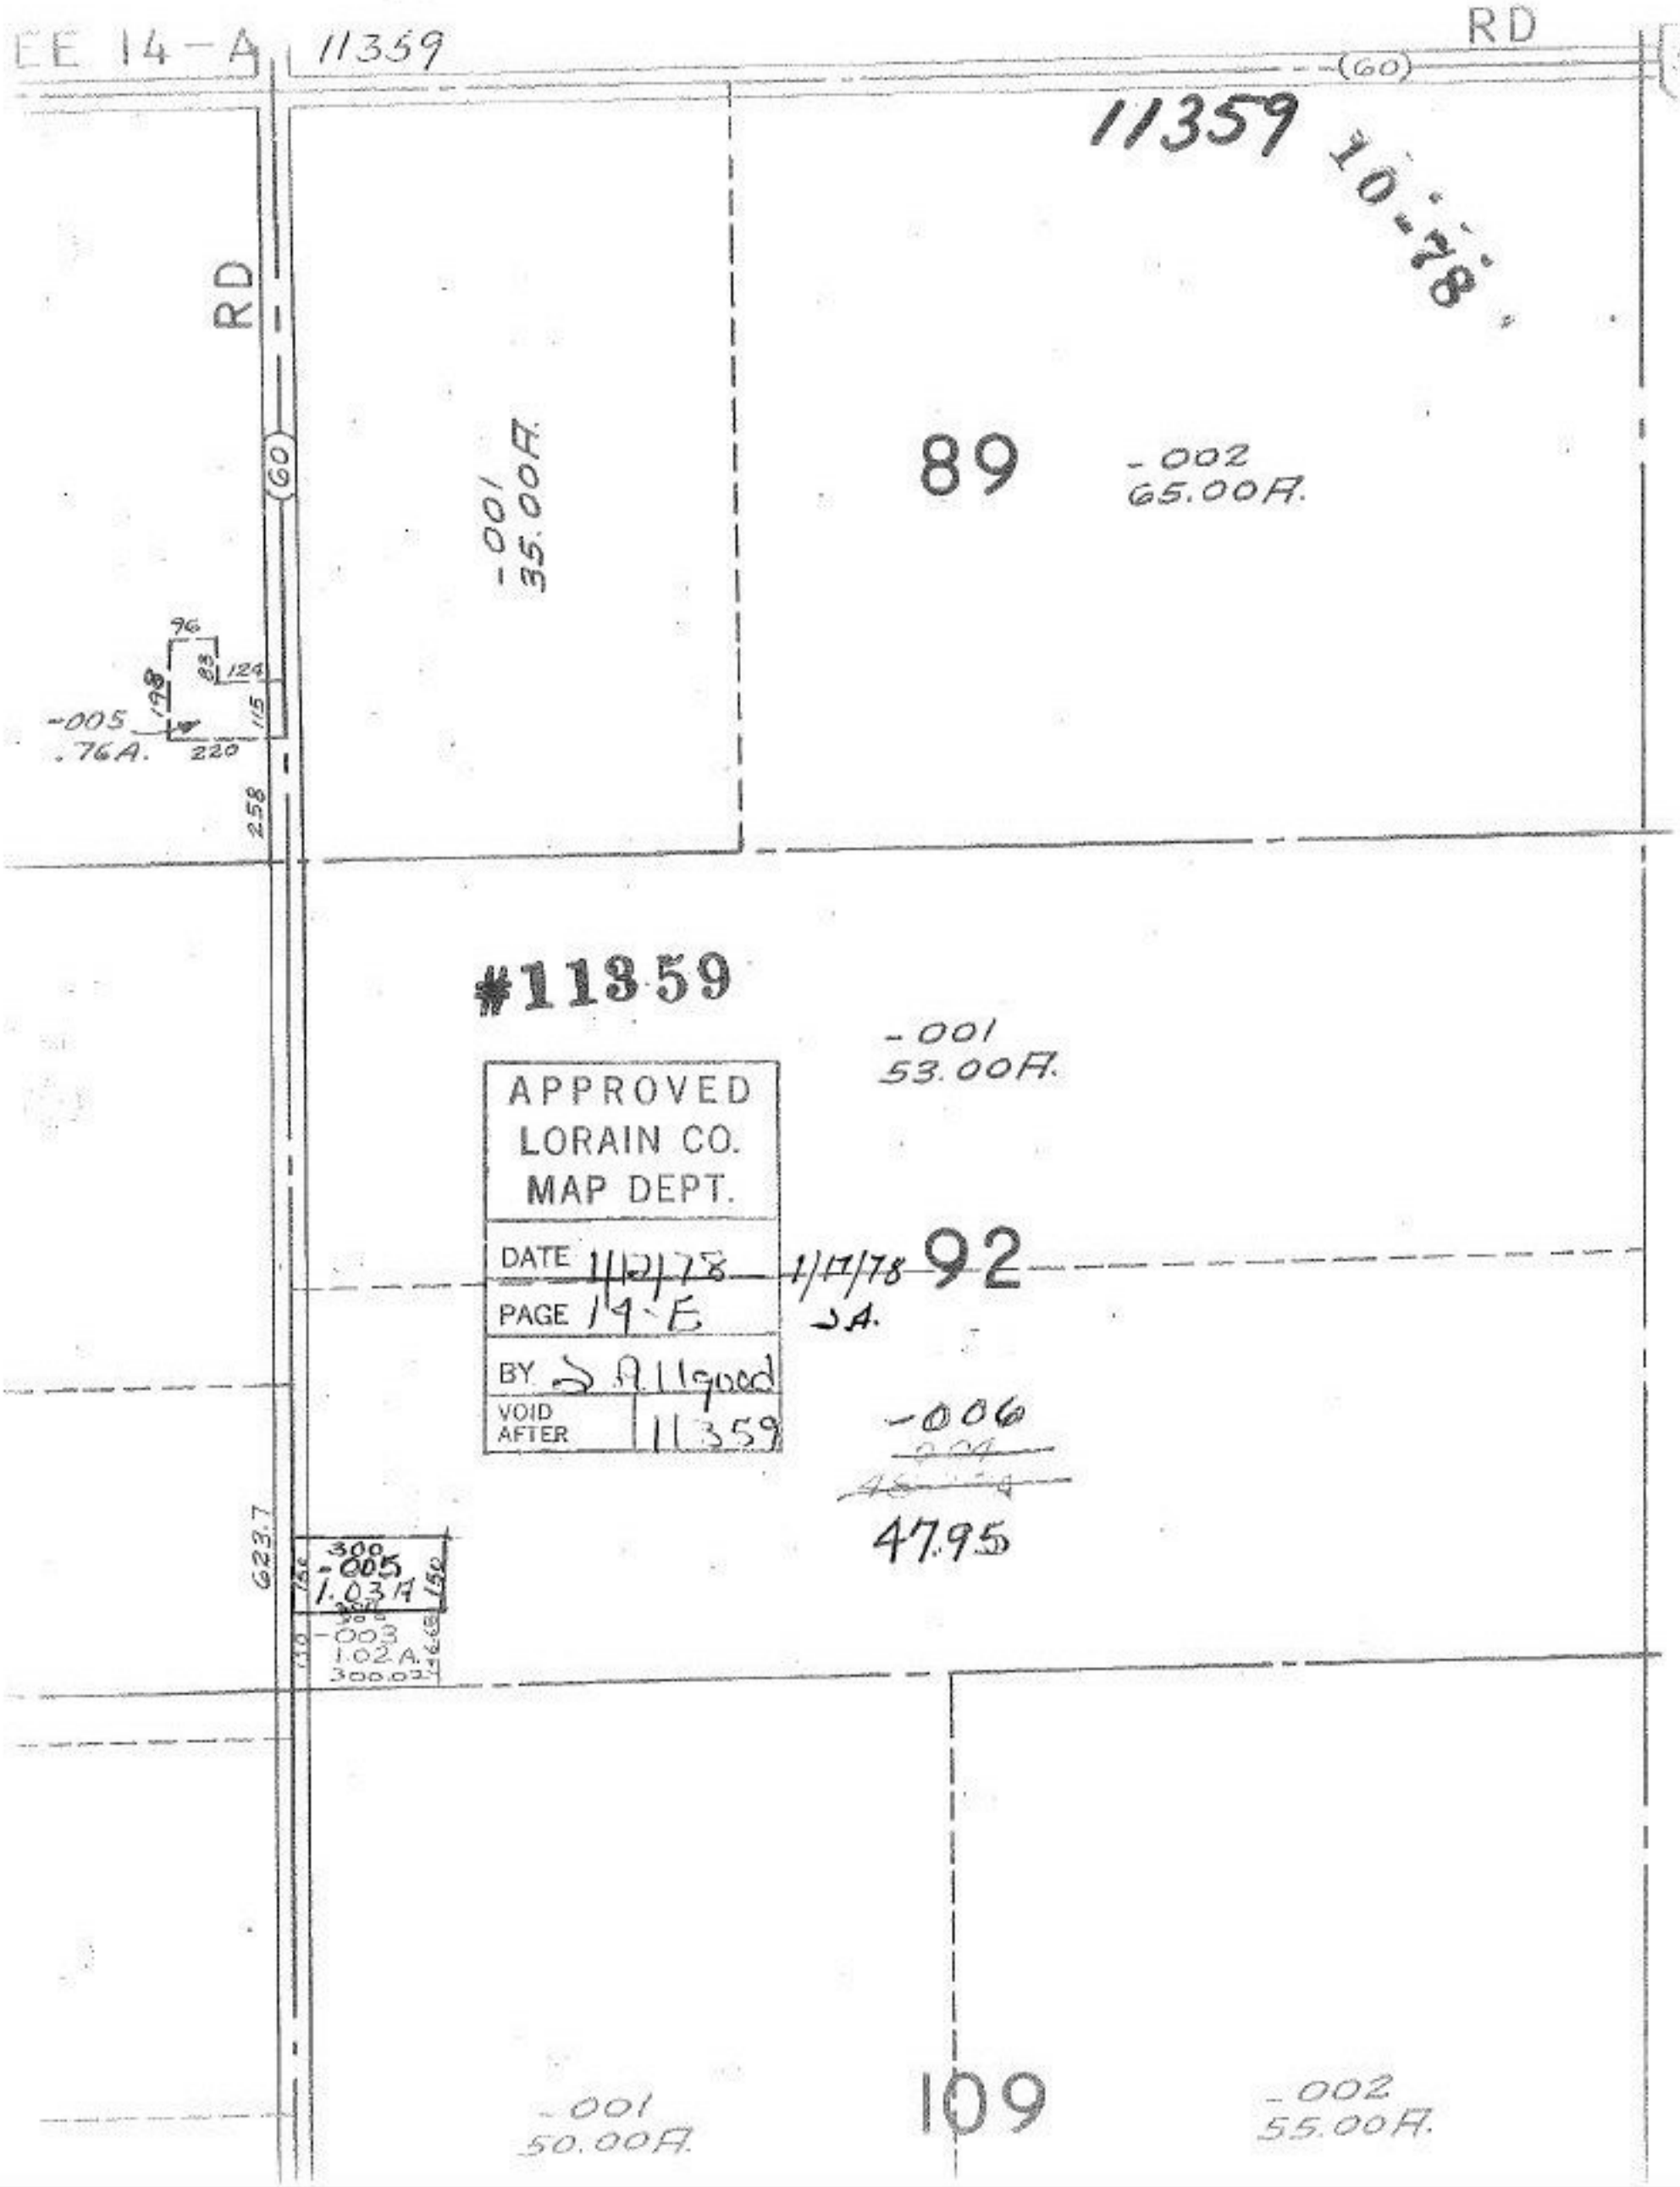
EE 14-A
11359
RD
(60)
11359
10-78
RD
(60)
-001
35.00A.
89
-002
65.00A.
96
83
124
198
115
-005
.76A.
220
258
#11359
-001
53.00A.
APPROVED
LORAIN CO.
MAP DEPT.
DATE 1/12/78
PAGE 14-E
BY S Allgood
VOID AFTER 11359
1/17/78
92
-006
47.95
623.7
300
-005
1.03A
150
-003
1.02A.
300.02
-001
50.00A.
109
-002
55.00A.