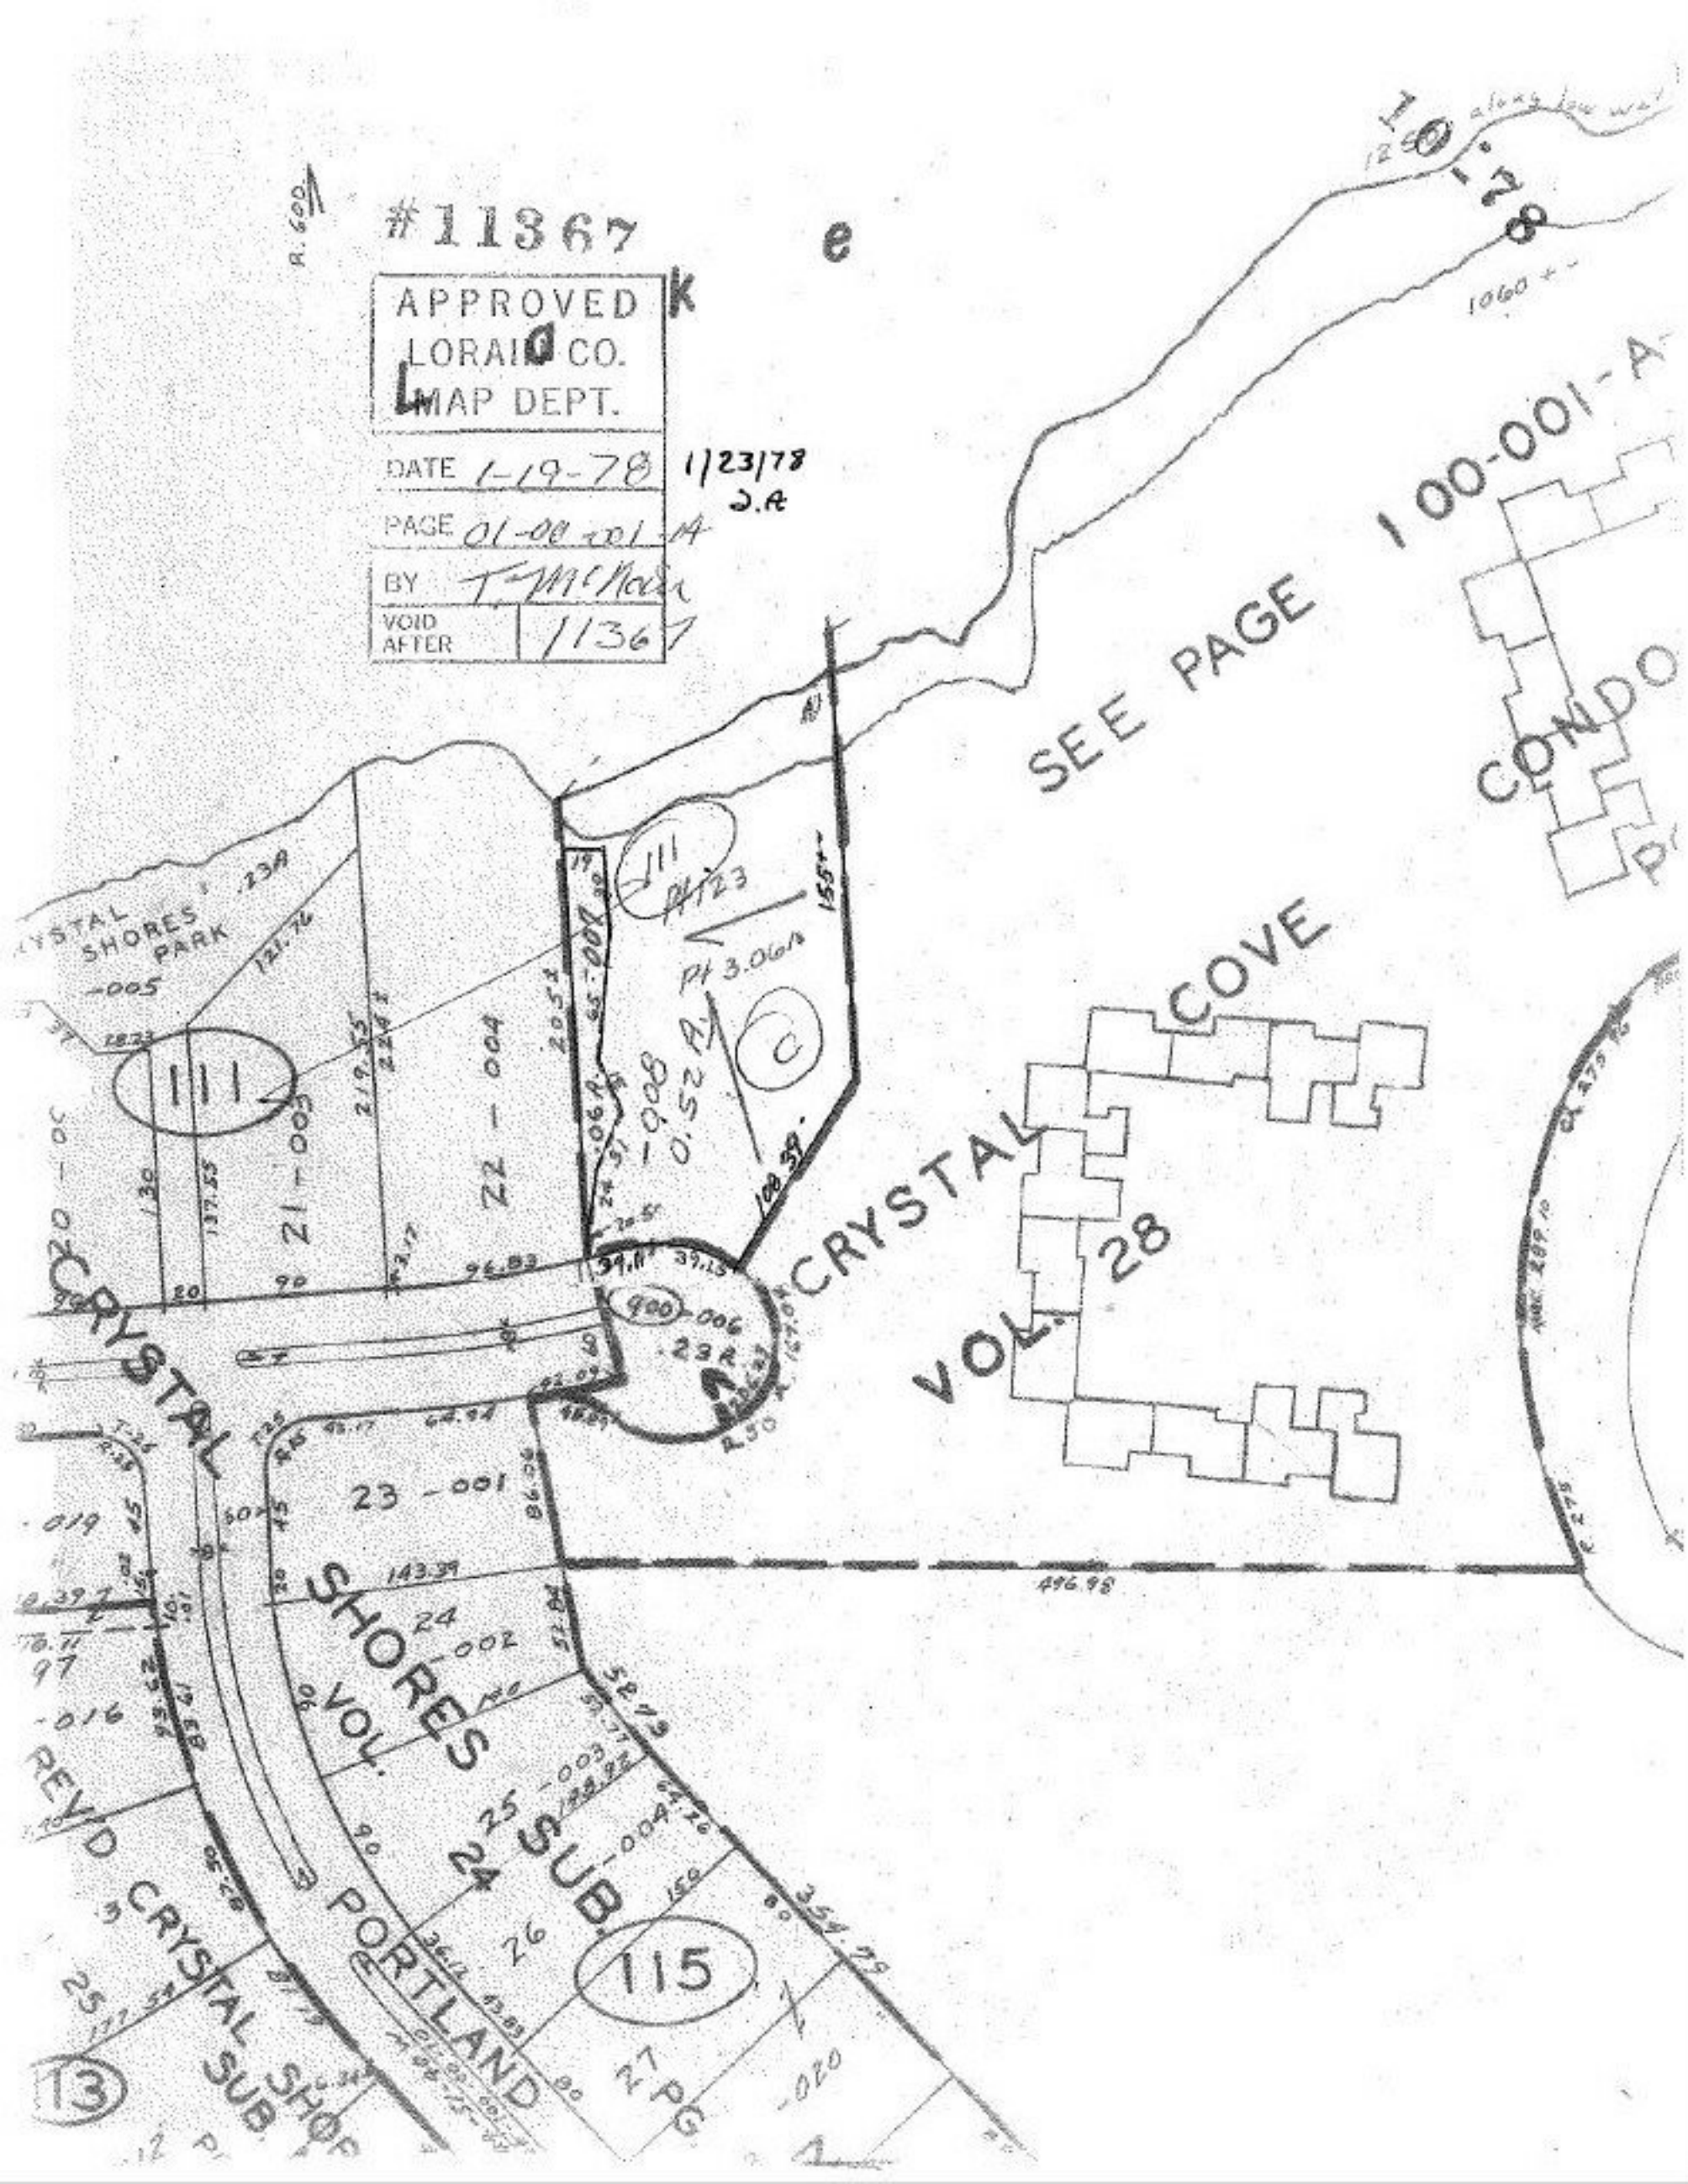
#11367
APPROVED
LORAIN CO.
MAP DEPT.
DATE 1-19-78
1/23/78
PAGE 01-00-001-A
BY
VOID AFTER 11367
SEE PAGE 100-001-A
CONDO
CRYSTAL COVE
VOL. 28
CRYSTAL SHORES PARK
CRYSTAL SHORES VOL. 24
PORTLAND SUB.
REV'D CRYSTAL SHORES SUB.
111
115
13