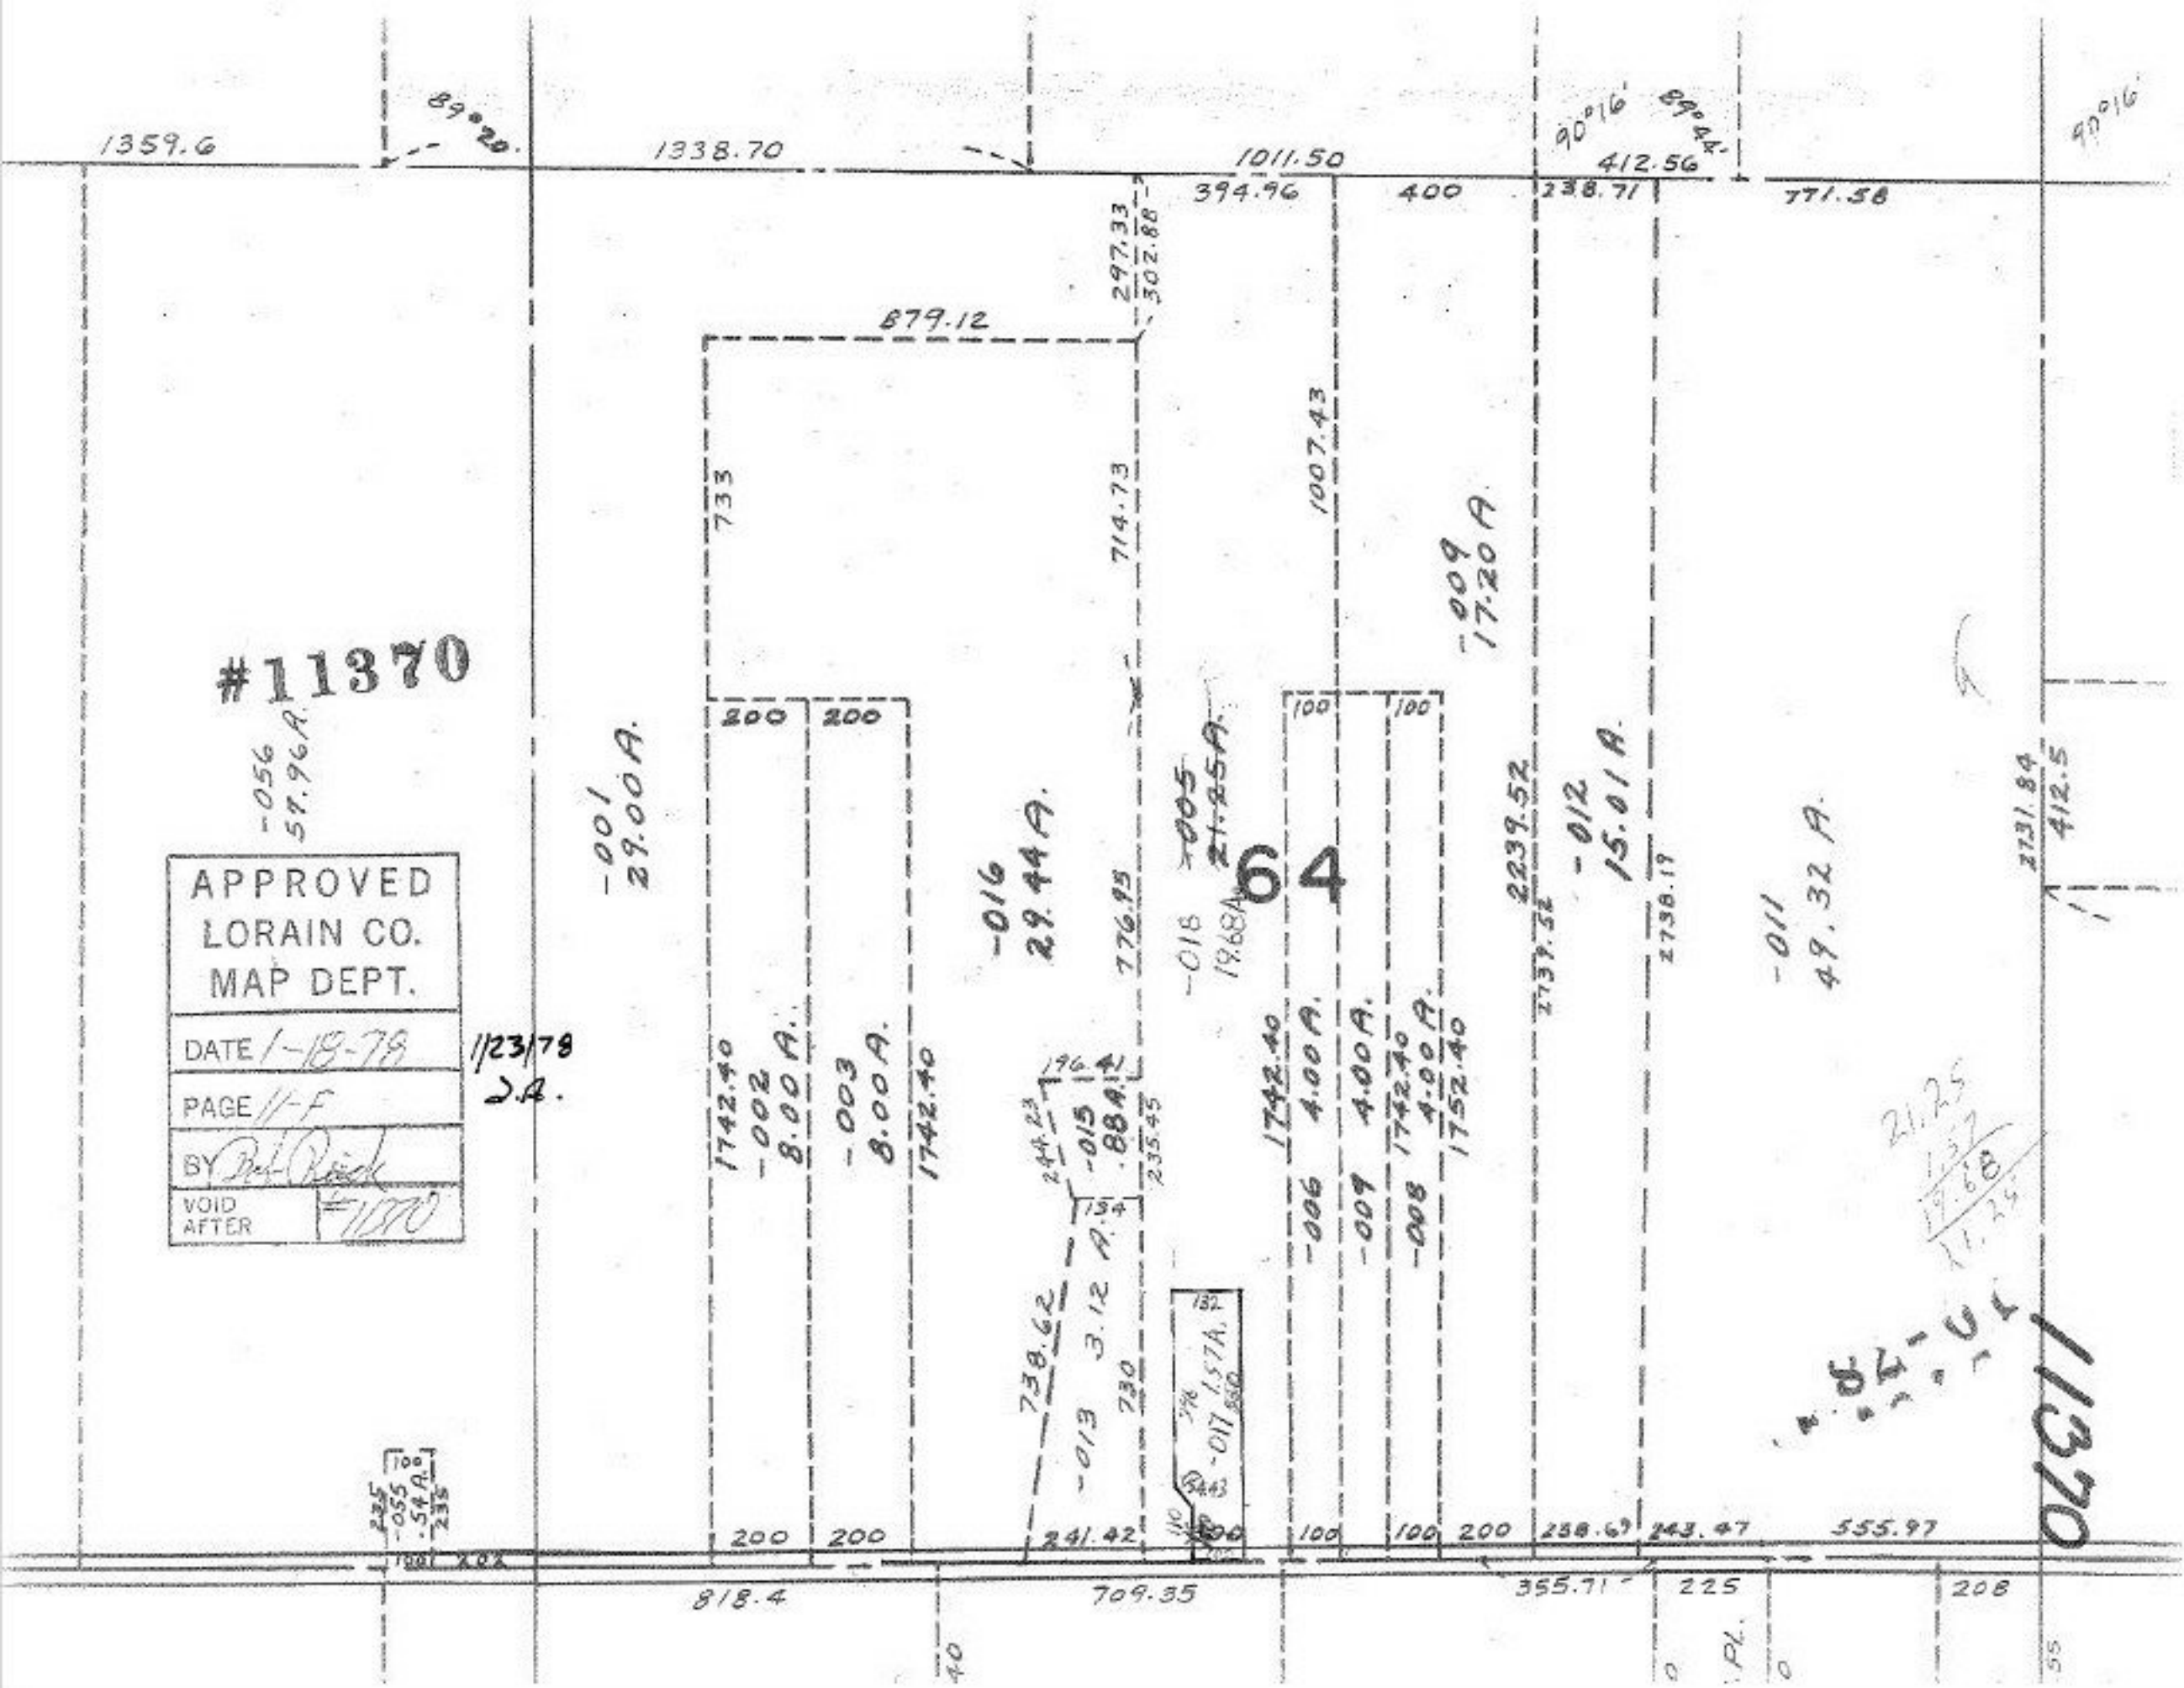

#11370
APPROVED
LORAIN CO.
MAP DEPT.
DATE 1-18-78
PAGE 11-F
BY
VOID AFTER #11370
1/23/78
2.A.
1359.6
1338.70
1011.50
394.96
400
412.56
238.71
771.58
879.12
297.33
302.88
733
714.73
1007.43
-009
17.20 A.
-056
57.96 A.
-001
29.00 A.
-016
29.44 A.
-005
21.25 A.
-018
19.68 A.
64
2239.52
-012
15.01 A.
-011
49.32 A.
2731.84
412.5
1742.40
-002
8.00 A.
-003
8.00 A.
1742.40
196.41
-015
.88 A.
235.45
1742.40
-006
4.00 A.
-009
4.00 A.
-008
4.00 A.
1752.40
738.62
-013
3.12 A.
730
-017
1.57 A.
200
200
100
100
241.42
100
100
200
238.69
243.47
555.97
818.4
709.35
355.71
225
208
11370