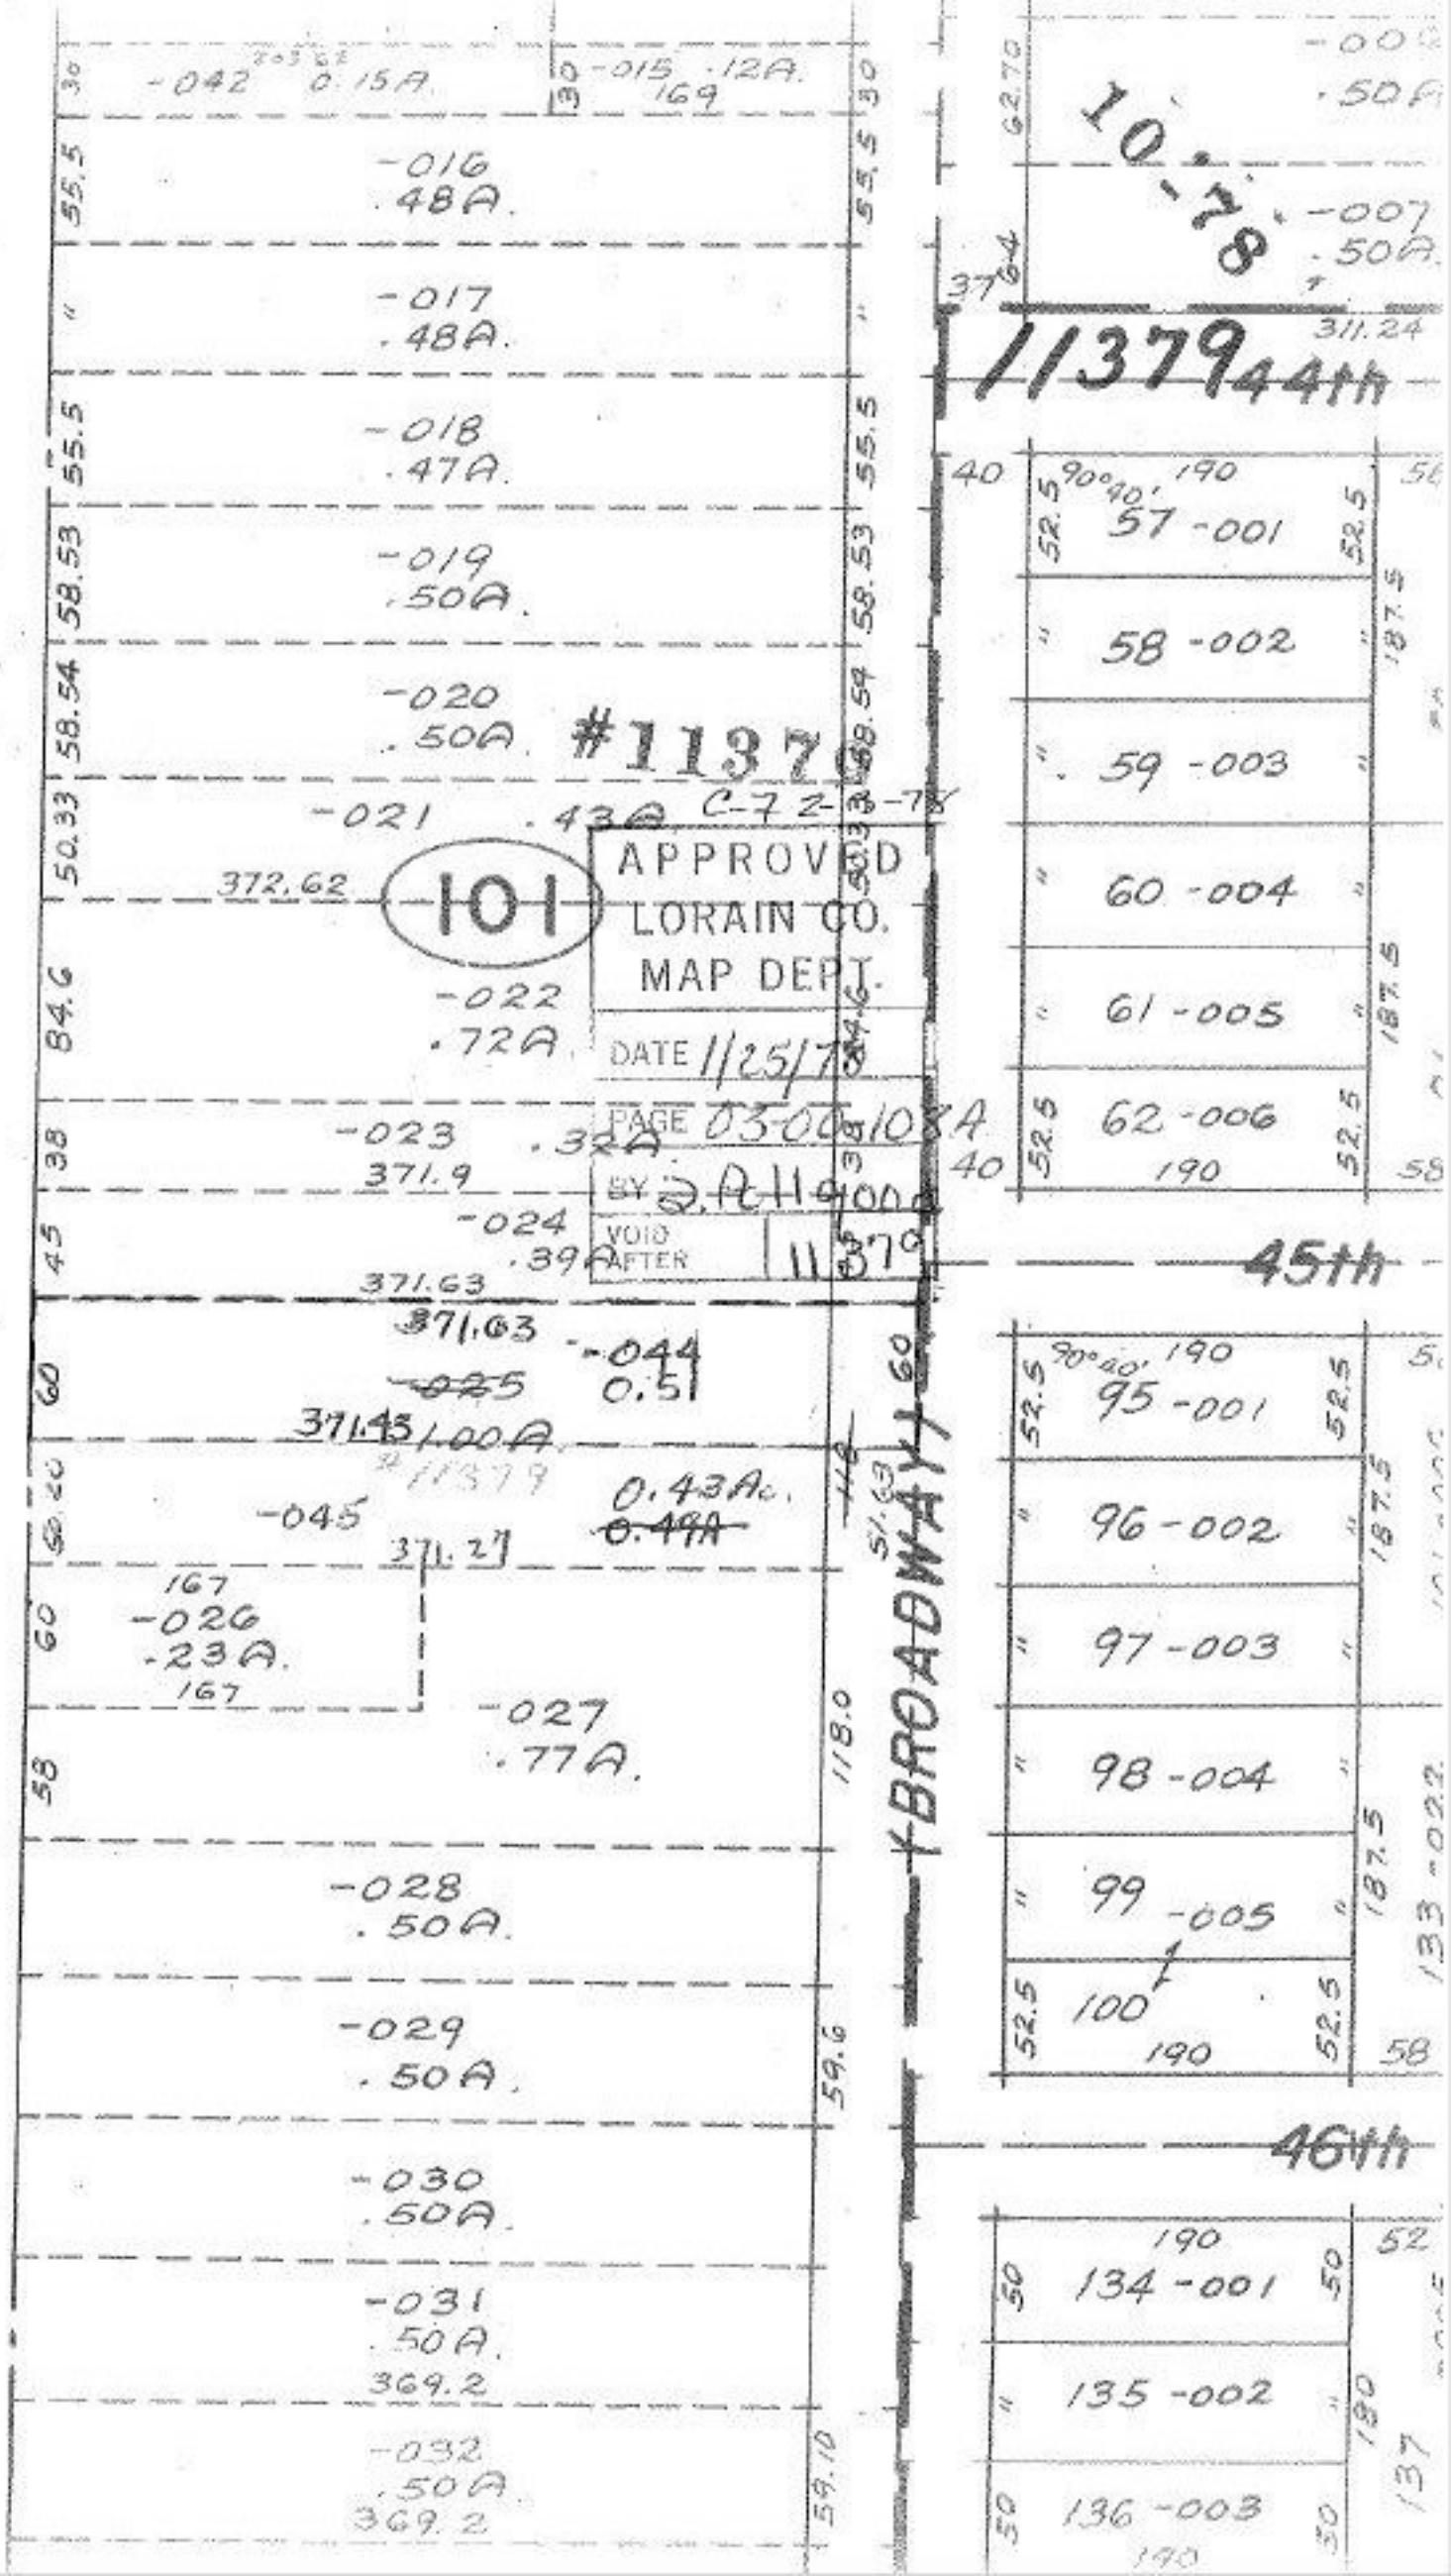

-042 0.15A
-015 .12A 169
-016 .48A
-017 .48A
-018 .47A
-019 .50A
-020 .50A
#11379
-021 .43A
C-7 2-3-78
372.62
101
APPROVED
LORAIN CO.
MAP DEPT.
DATE 1/25/78
PAGE 03-00-108A
BY
VOID AFTER 11379
-022 .72A
-023 .32A
371.9
-024 .39A
371.63
371.63
-044 0.51
-025
371.43 1.00A
#11379
-045
0.43Ac.
371.27
167
-026 .23A
167
-027 .77A
-028 .50A
-029 .50A
-030 .50A
-031 .50A
369.2
-032 .50A
369.2
BROADWAY
10-78
-007 .50A
311.24
11379 44th
57-001
58-002
59-003
60-004
61-005
62-006
190
45th
95-001
96-002
97-003
98-004
99-005
100
190
46th
134-001
135-002
136-003
190
SEE 2-01-003-N
#11379