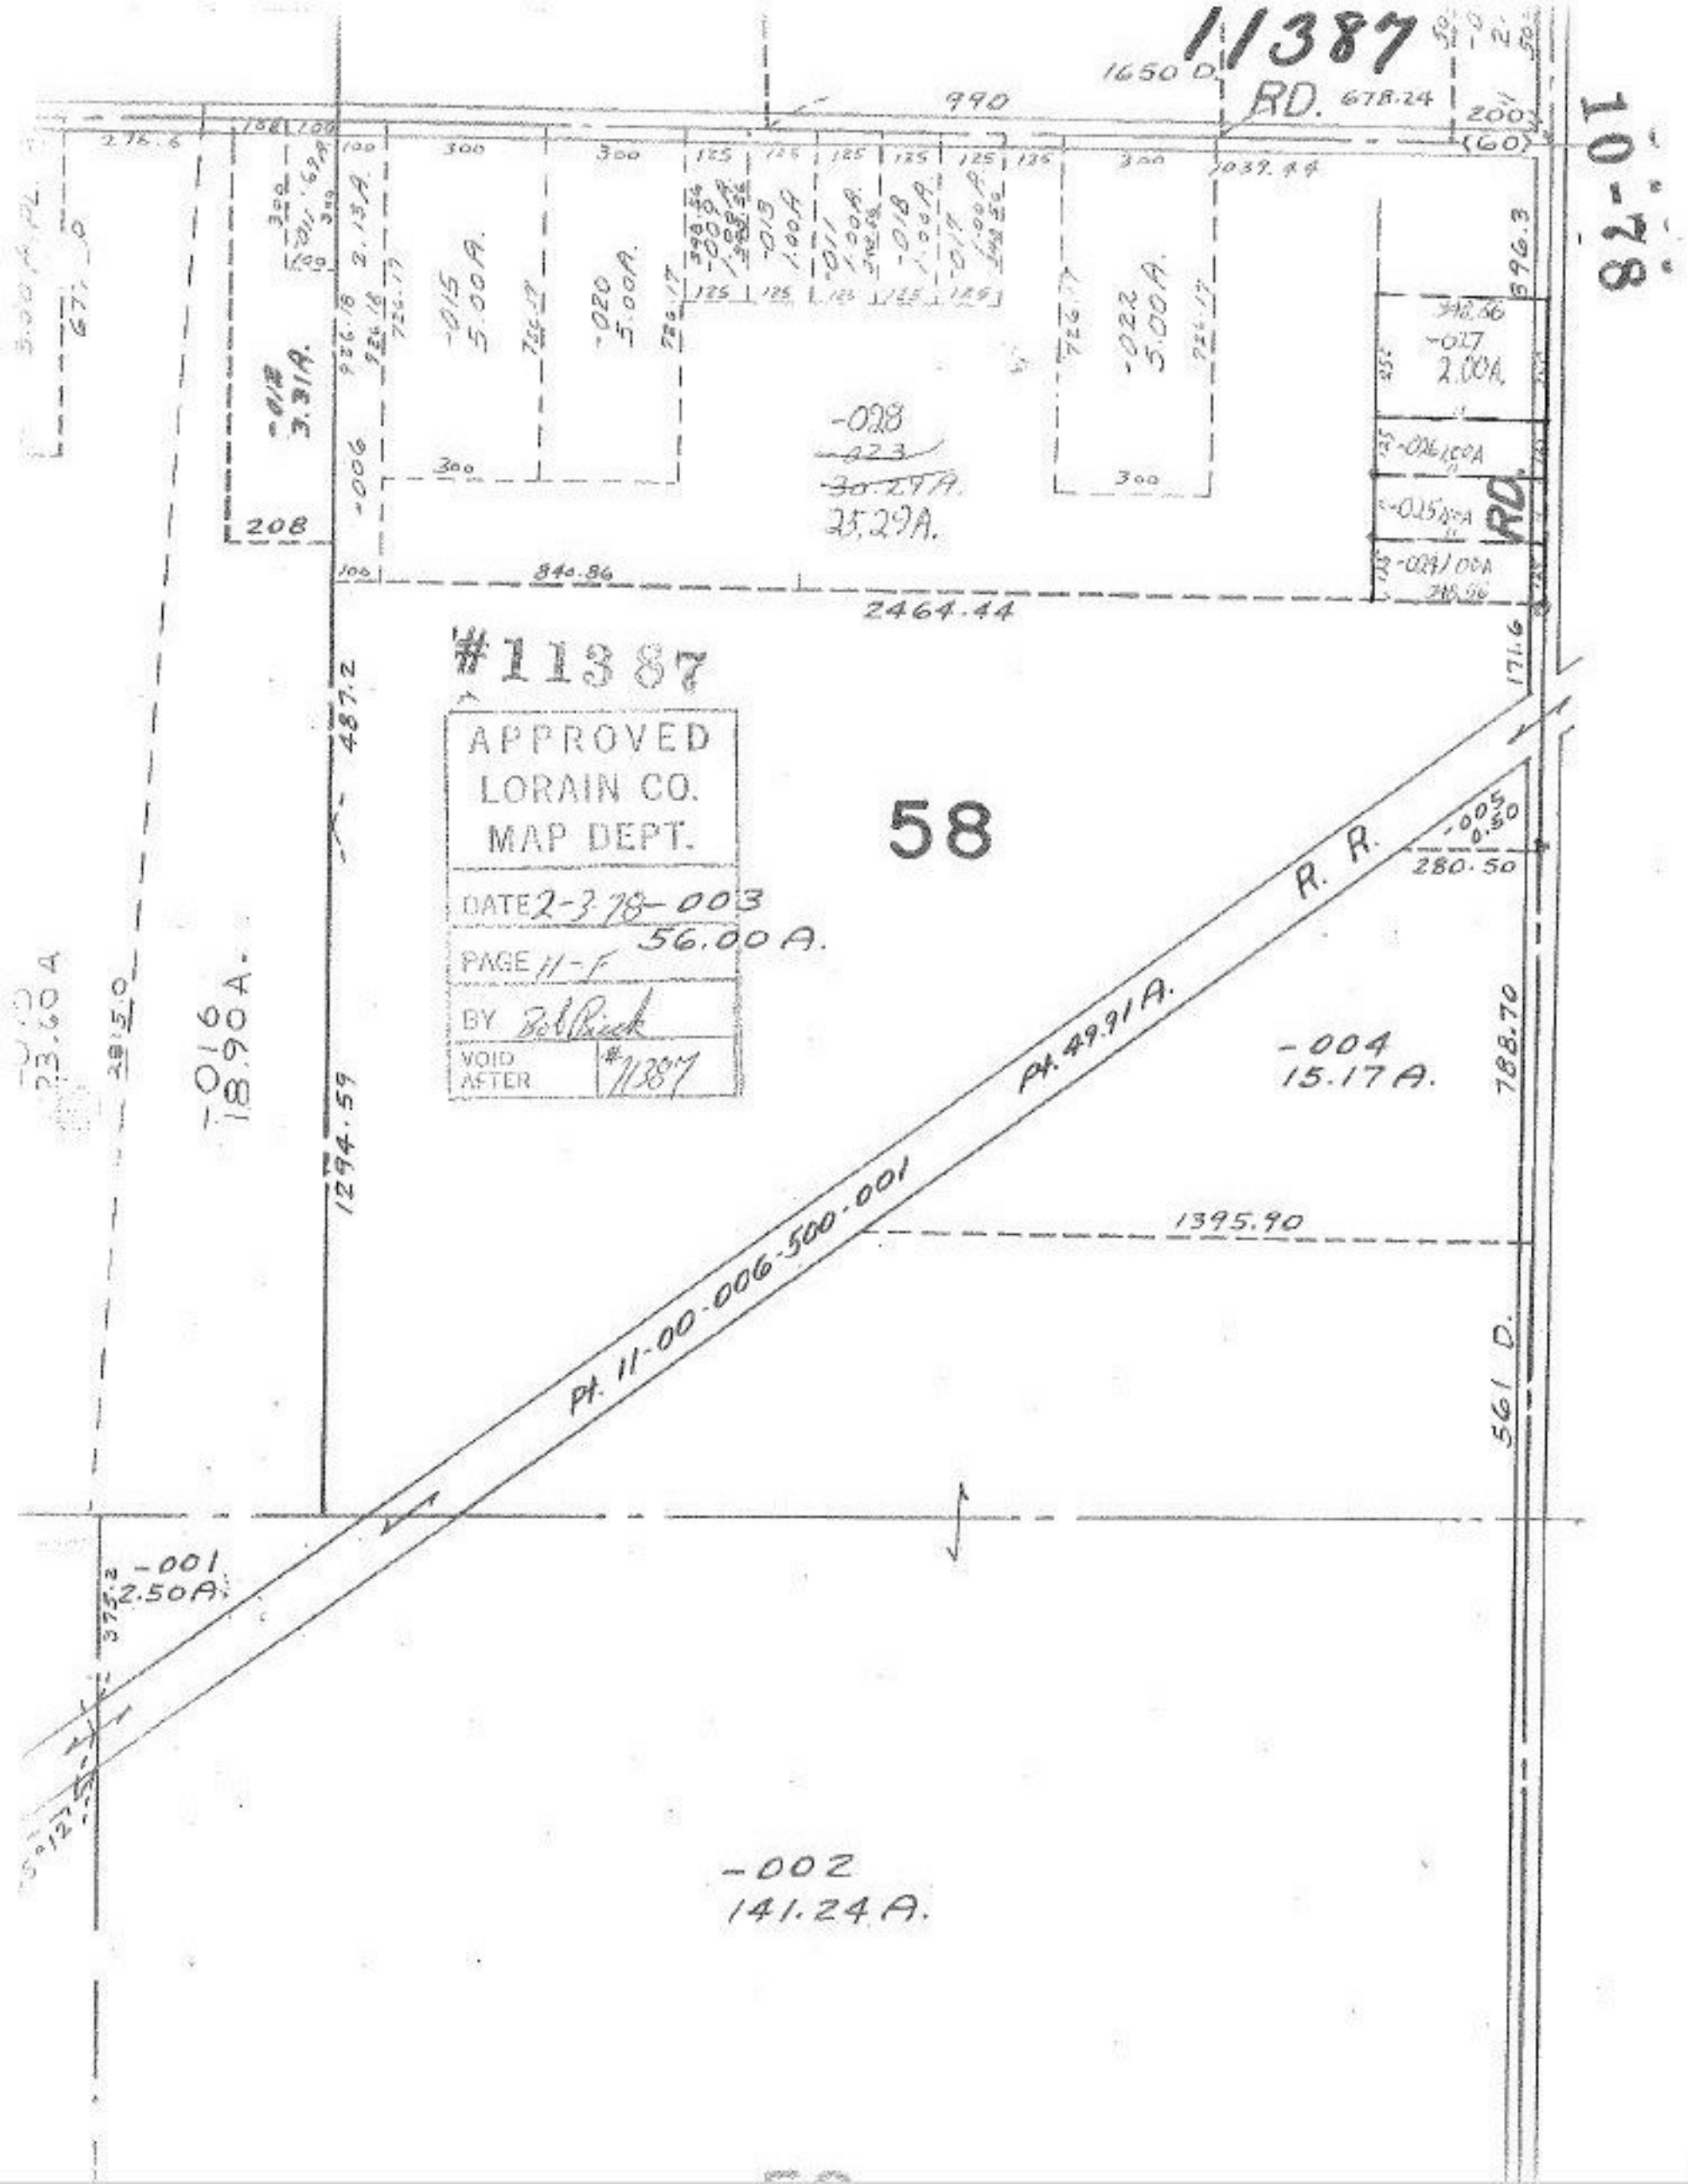
11387
10-78
1650 D.
RD.
678.24
990
200
(60)
1039.44
396.3
-012
3.31A.
-015
5.00A.
-020
5.00A.
-022
5.00A.
-028
-023
30.29A.
25.29A.
-027
2.00A.
-026 1.00A
-025 1.00A
-024 1.00A
208
840.86
2464.44
171.6
487.2
#11387
APPROVED
LORAIN CO.
MAP DEPT.
DATE 2-3-78-003
56.00 A.
PAGE 11-F
BY Bob Rieck
VOID AFTER #11387
58
R. R.
-005
0.50
280.50
Pt. 49.91 A.
-004
15.17 A.
788.70
-016
18.90 A.
1294.59
1395.90
Pt. 11-00-006-500-001
561 D.
-001
2.50A.
-002
141.24 A.