11390

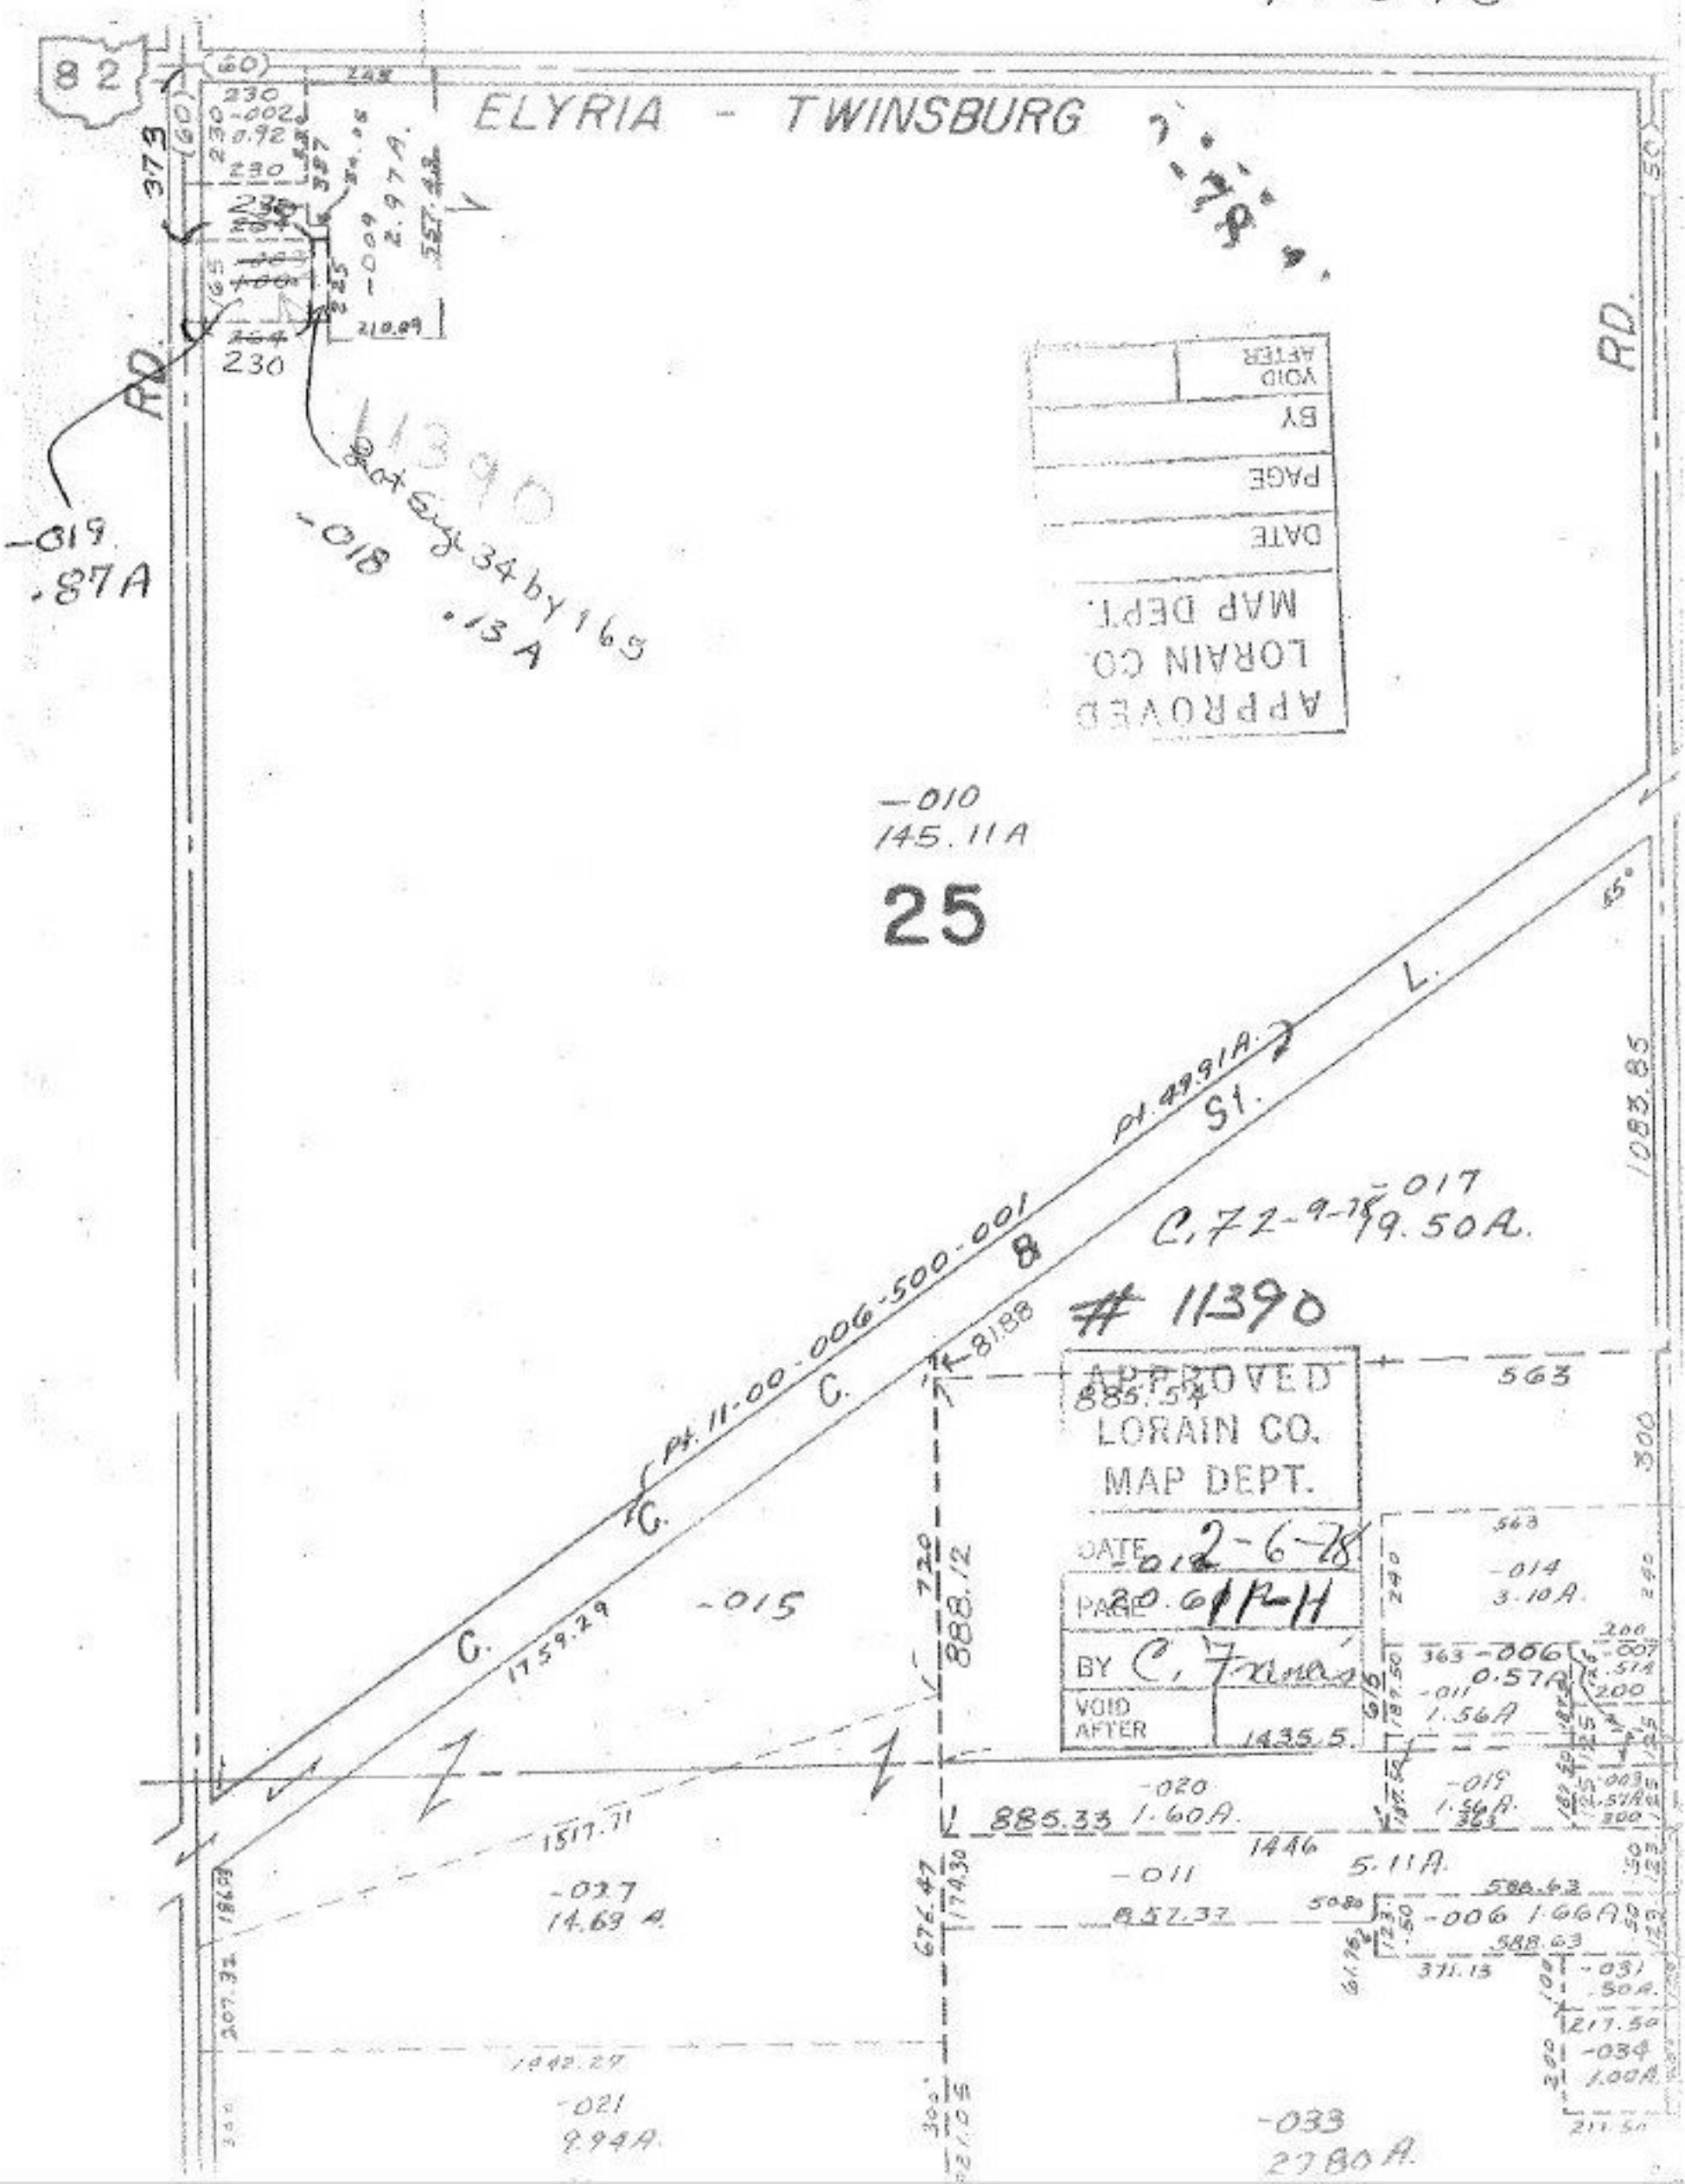

82
ELYRIA - TWINSBURG
RD.
RD.
-019
.87A
-018
.13A
11390
Got Sig 34 by 169
APPROVED
LORAIN CO.
MAP DEPT.
DATE
PAGE
BY
VOID AFTER
-010
145.11A
25
Pt. 49.91A.
St.
L.
C.
B
C.
C.
Pt. 11-00-006-500-001
C. 72-9-78
-017
19.50A.
11390
APPROVED
LORAIN CO.
MAP DEPT.
DATE 2-6-78
PAGE 20.61 R-H
BY C. Francis
VOID AFTER
1435.5
-015
1759.29
888.12
885.54
563
-014
3.10A.
-006
0.57A
-011
1.56A
-020
1.60A.
885.33
1446
5.11A.
-019
1.56A.
-011
857.37
-006 1.66A
-027
14.69 A.
1517.71
-021
9.94A.
-033
27.80 A.
-034
1.00A.
-031
.50A.
1083.85