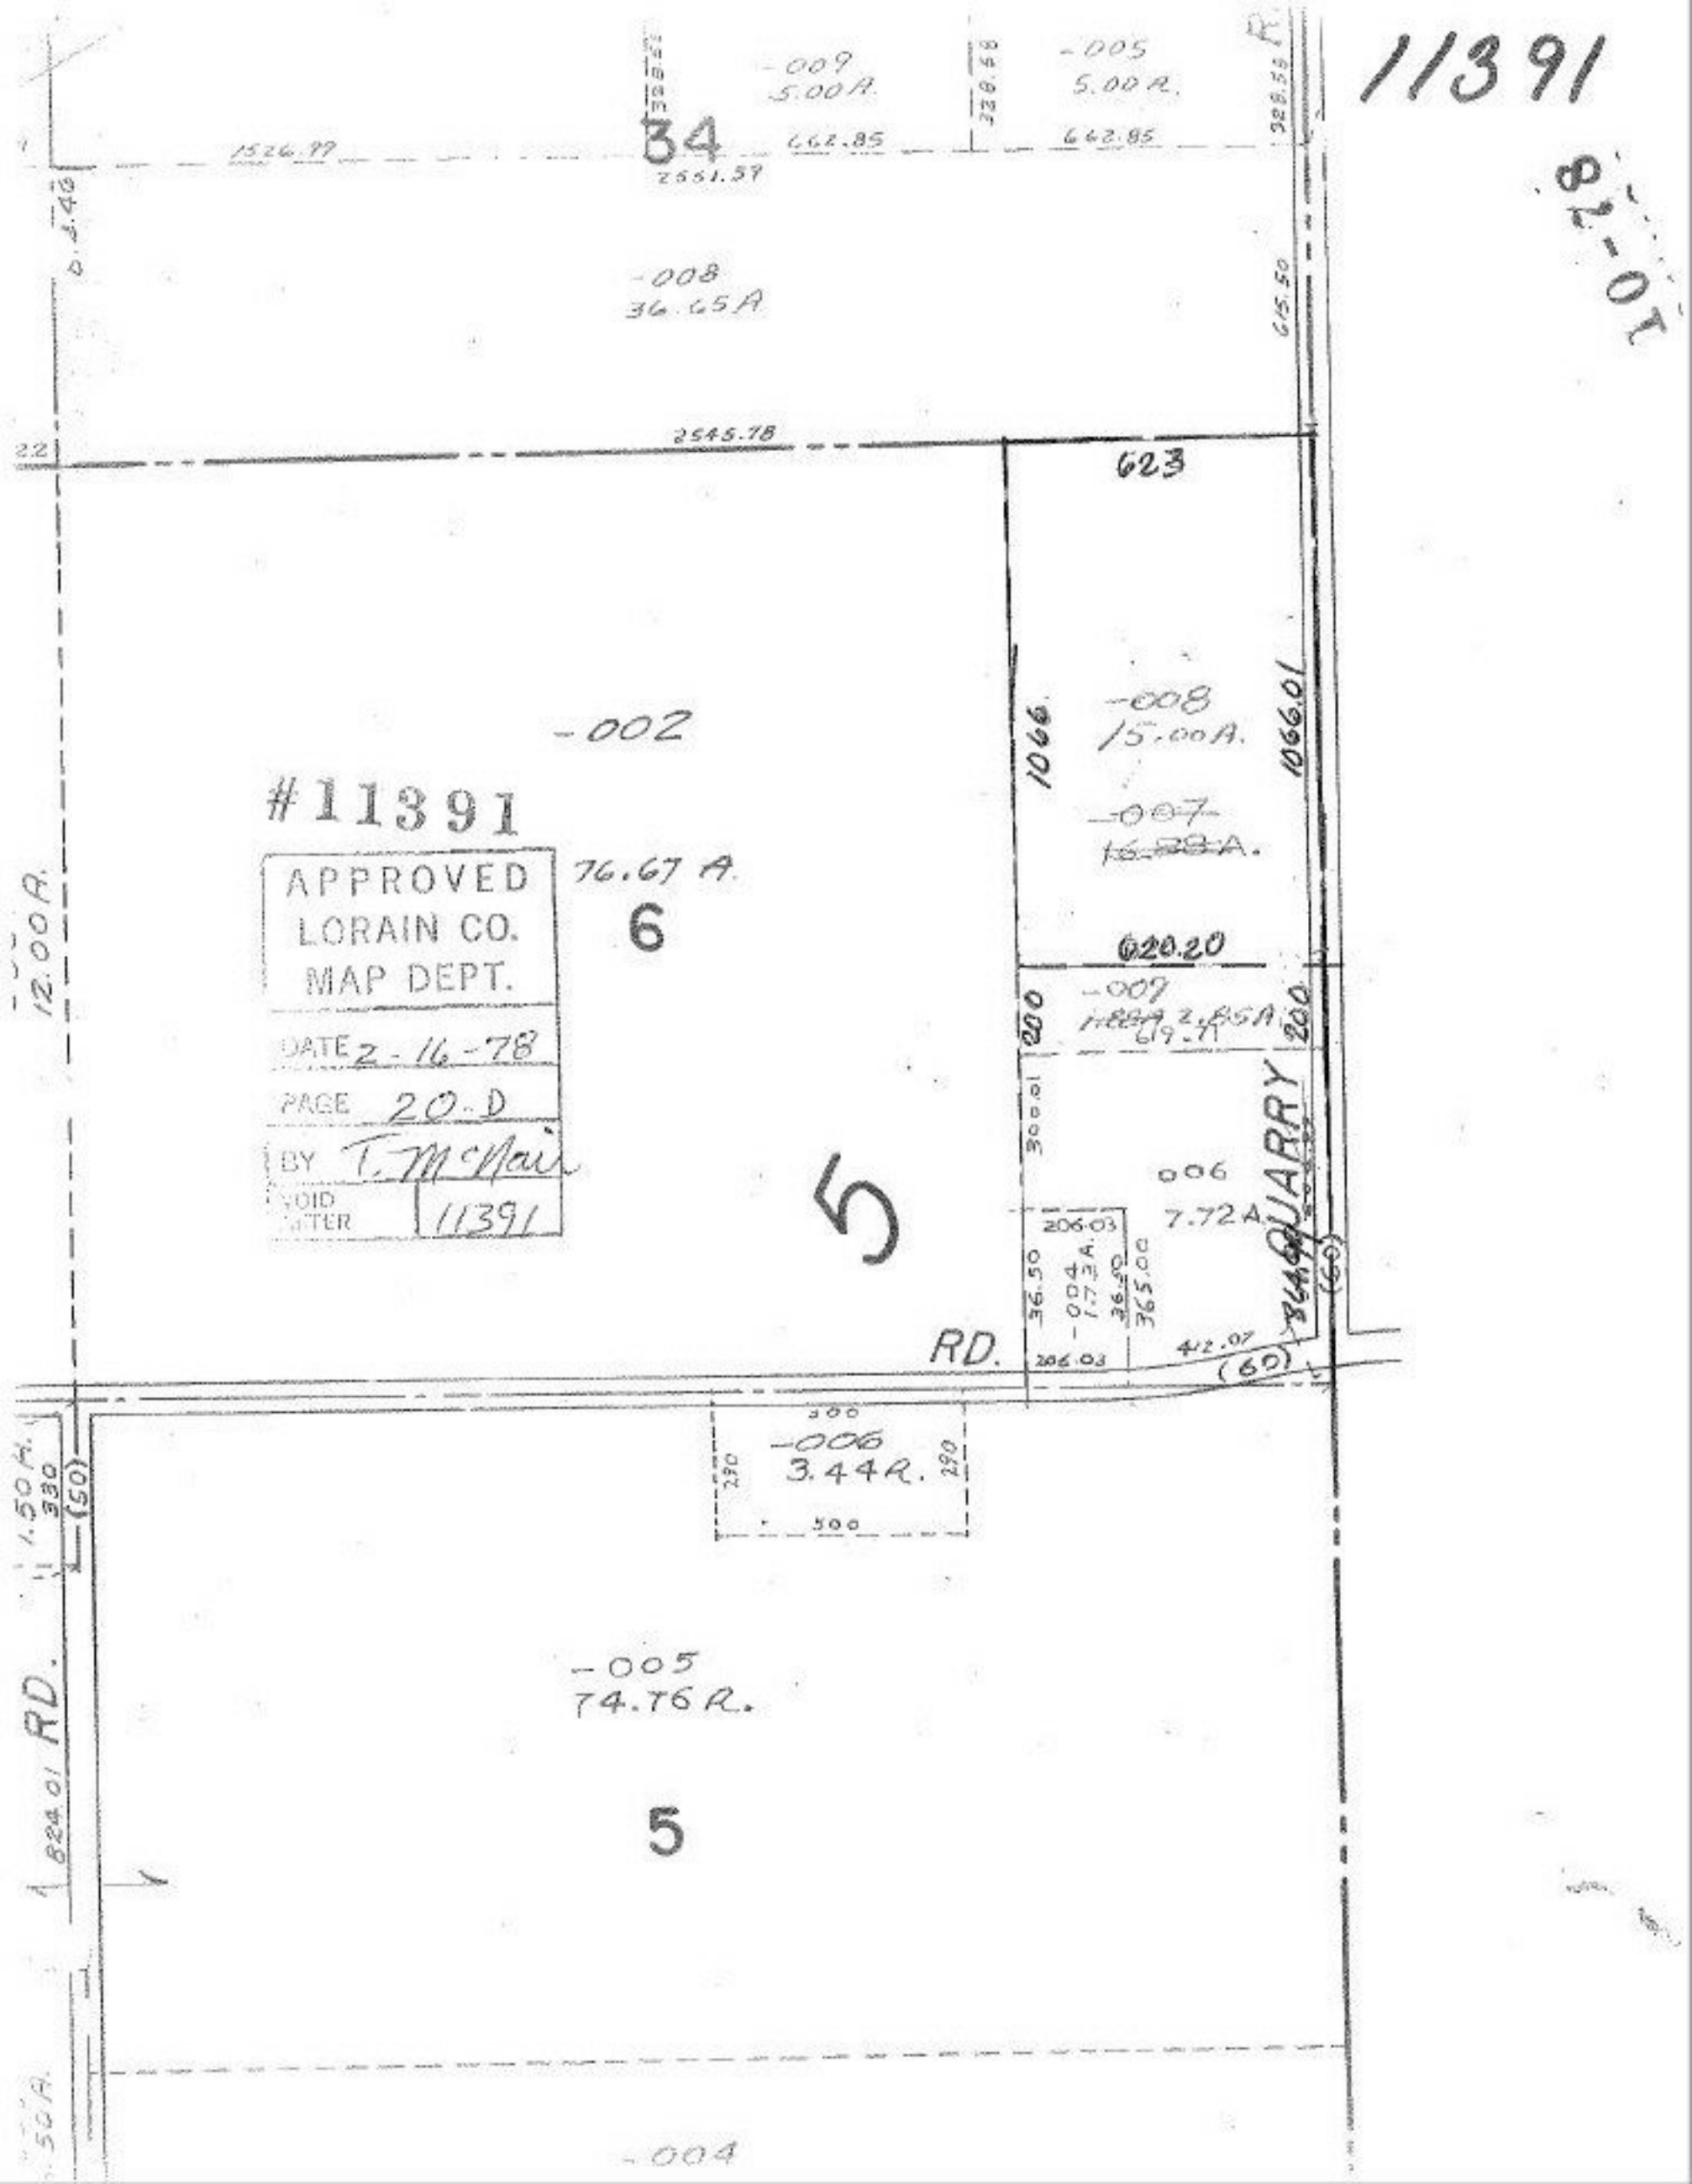
11391
10-78
-009
5.00A.
-005
5.00A.
34
1526.99
662.85
662.85
2551.57
-008
36.65A
2545.78
623
-002
#11391
APPROVED
LORAIN CO.
MAP DEPT.
DATE 2-16-78
PAGE 20-D
BY T. McNair
VOID
LETTER 11391
76.67 A.
6
12.00A.
1066
-008
15.00A.
1066.01
-007
620.20
200
-009
2.85A
619.71
200
300.01
5
006
7.72A.
QUARRY
206.03
36.50
-004
1.73A.
36.50
365.00
RD.
206.03
412.07
(60)
300
-006
3.44A.
290
290
500
1.50A.
330
(50)
-005
74.76A.
RD.
824.01
5
-004