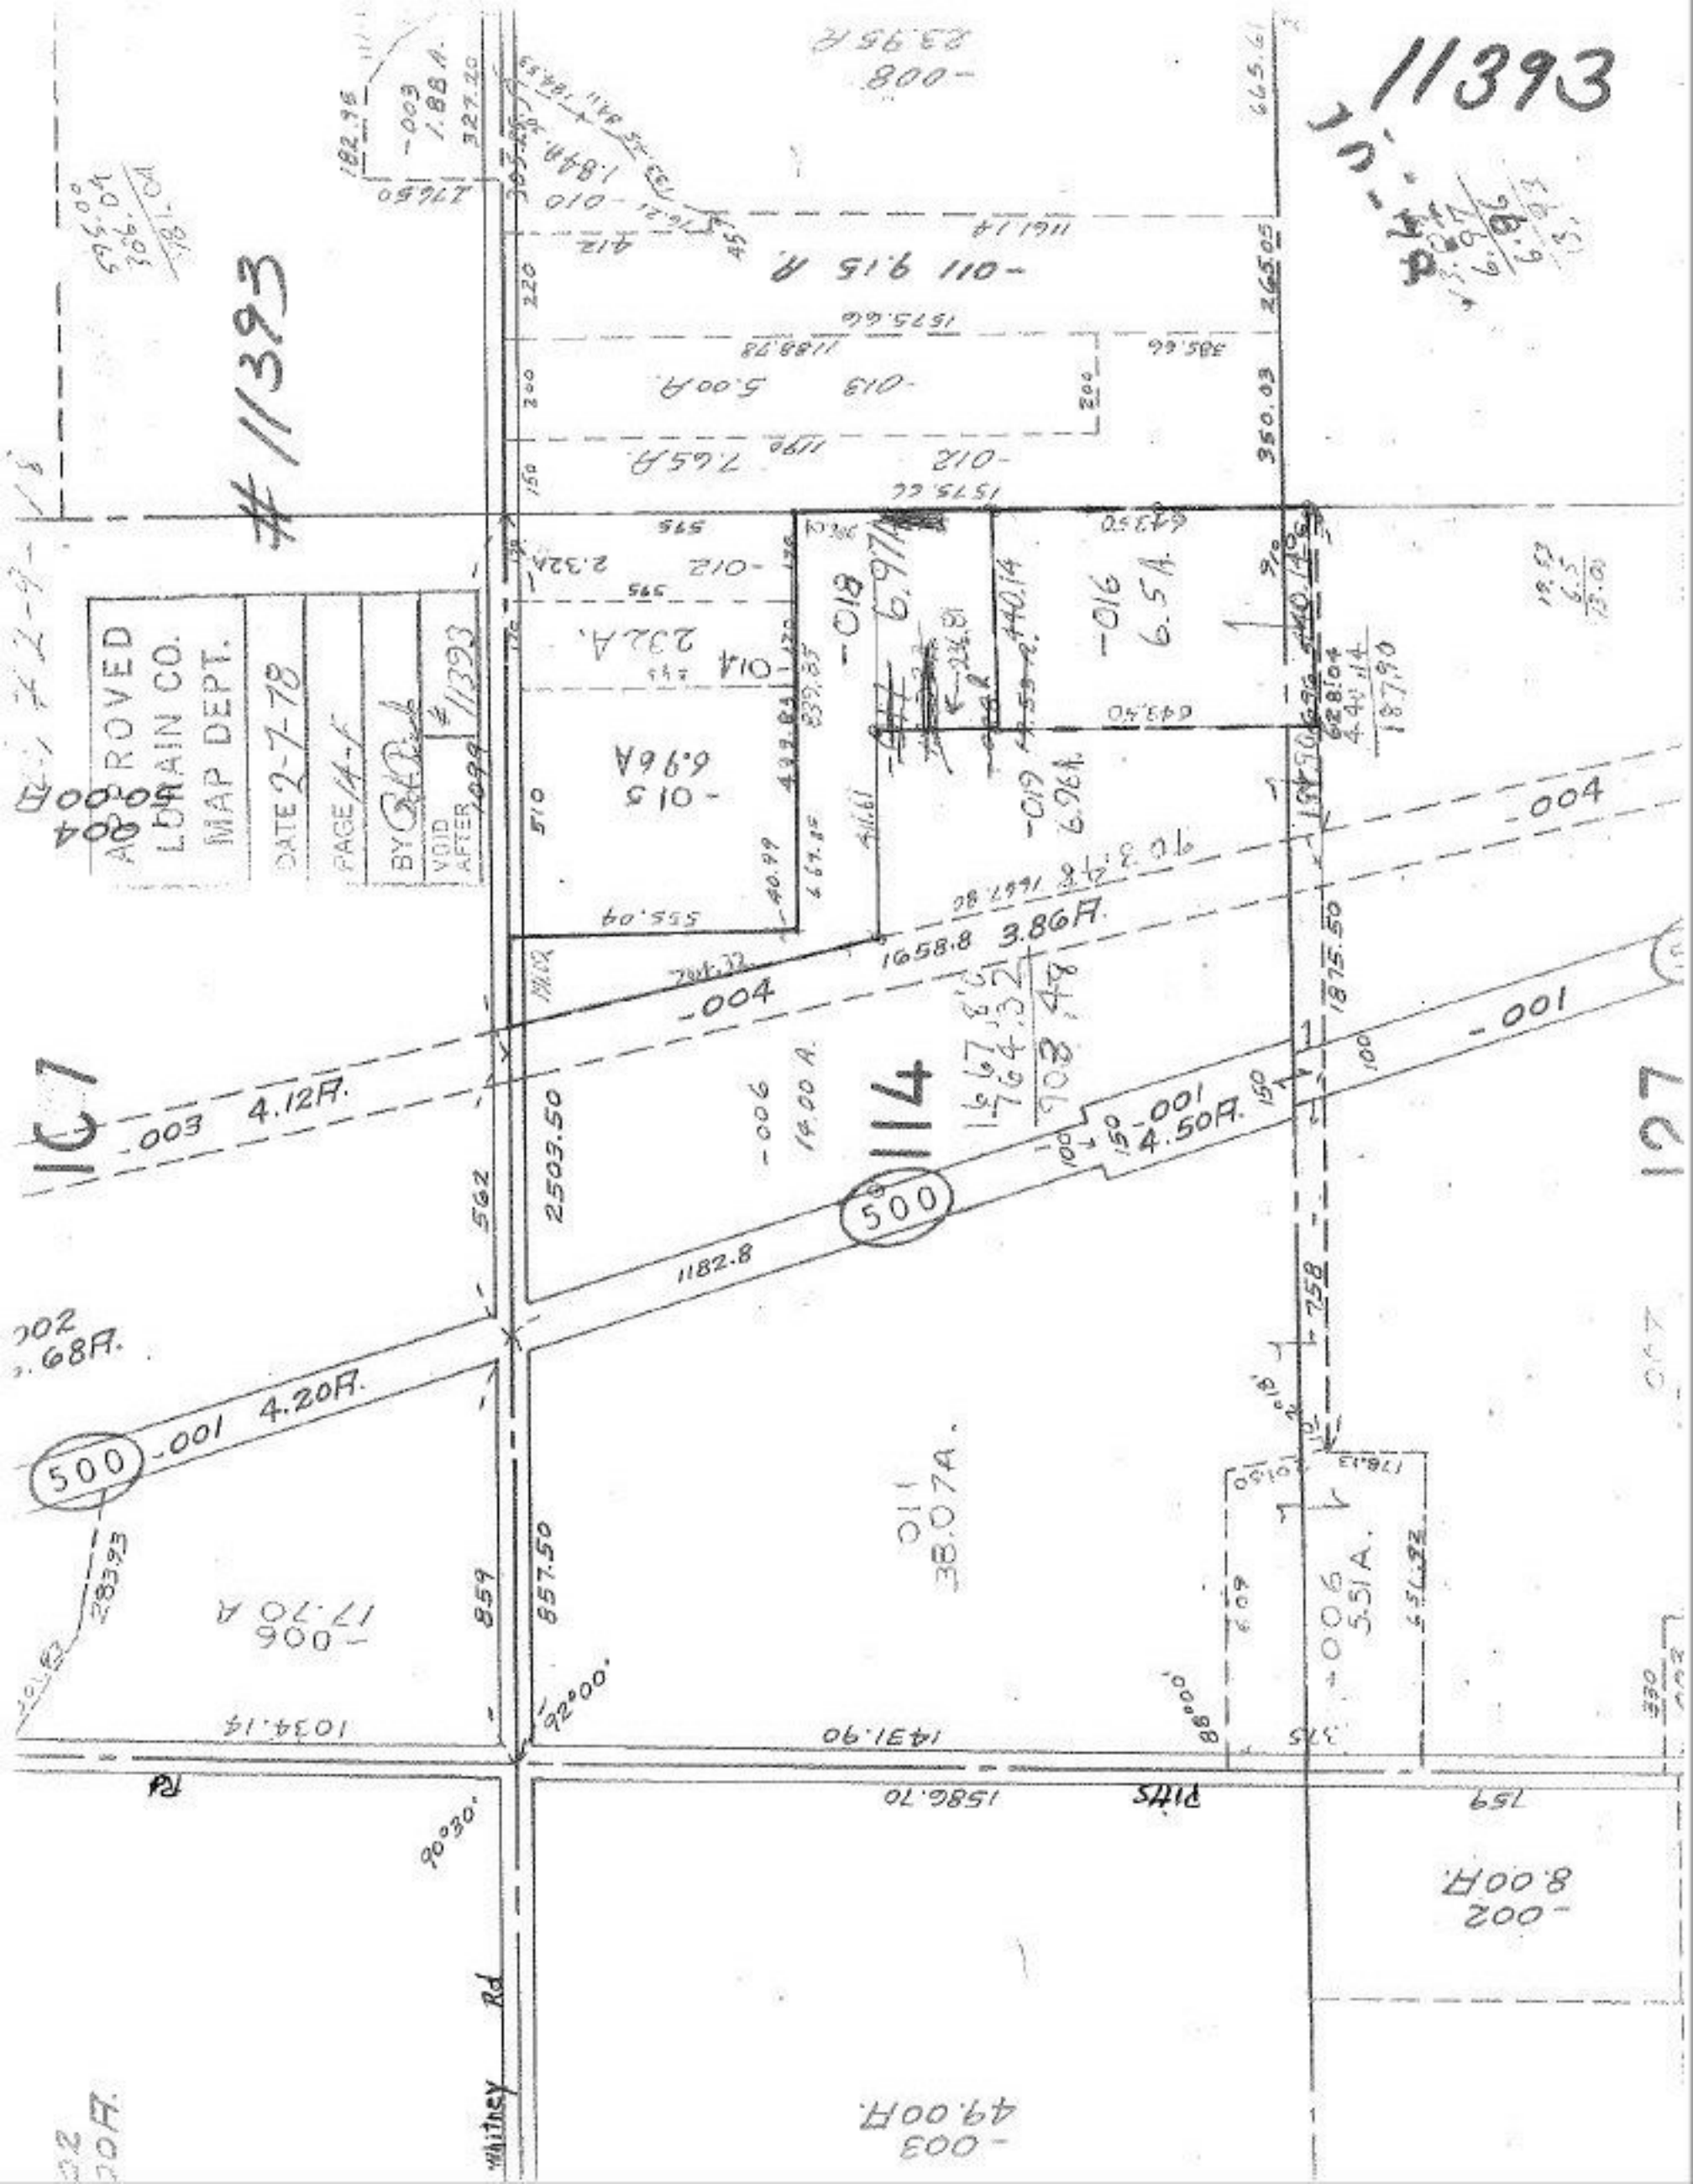
11393
#11393
APPROVED
LORAIN CO.
MAP DEPT.
DATE 2-7-78
PAGE 14-F
BY
VOID AFTER
#11393
-008
23.95 A
-011 9.15 A
-013 5.00 A
-012 7.65 A
-014 2.32 A
-015 6.96 A
-016 6.5 A
-018 6.97 A
-019 6.96 A
-004
-001
-003 4.12 A
-001 4.50 A
-001 4.20 A
-006 17.70 A
-006 5.51 A
-002 8.00 A
-003 49.00 A
-006 14.00 A
-004
1658.8 3.86 A
1182.8
500
1034.14
1431.90
1586.70
Whitney Rd
Pitts
Rd
92°00'
90°30'
88°00'
1875.50
2503.50
857.50
1875.50
1575.66
1188.78
1190
1161.14
1575.66
1