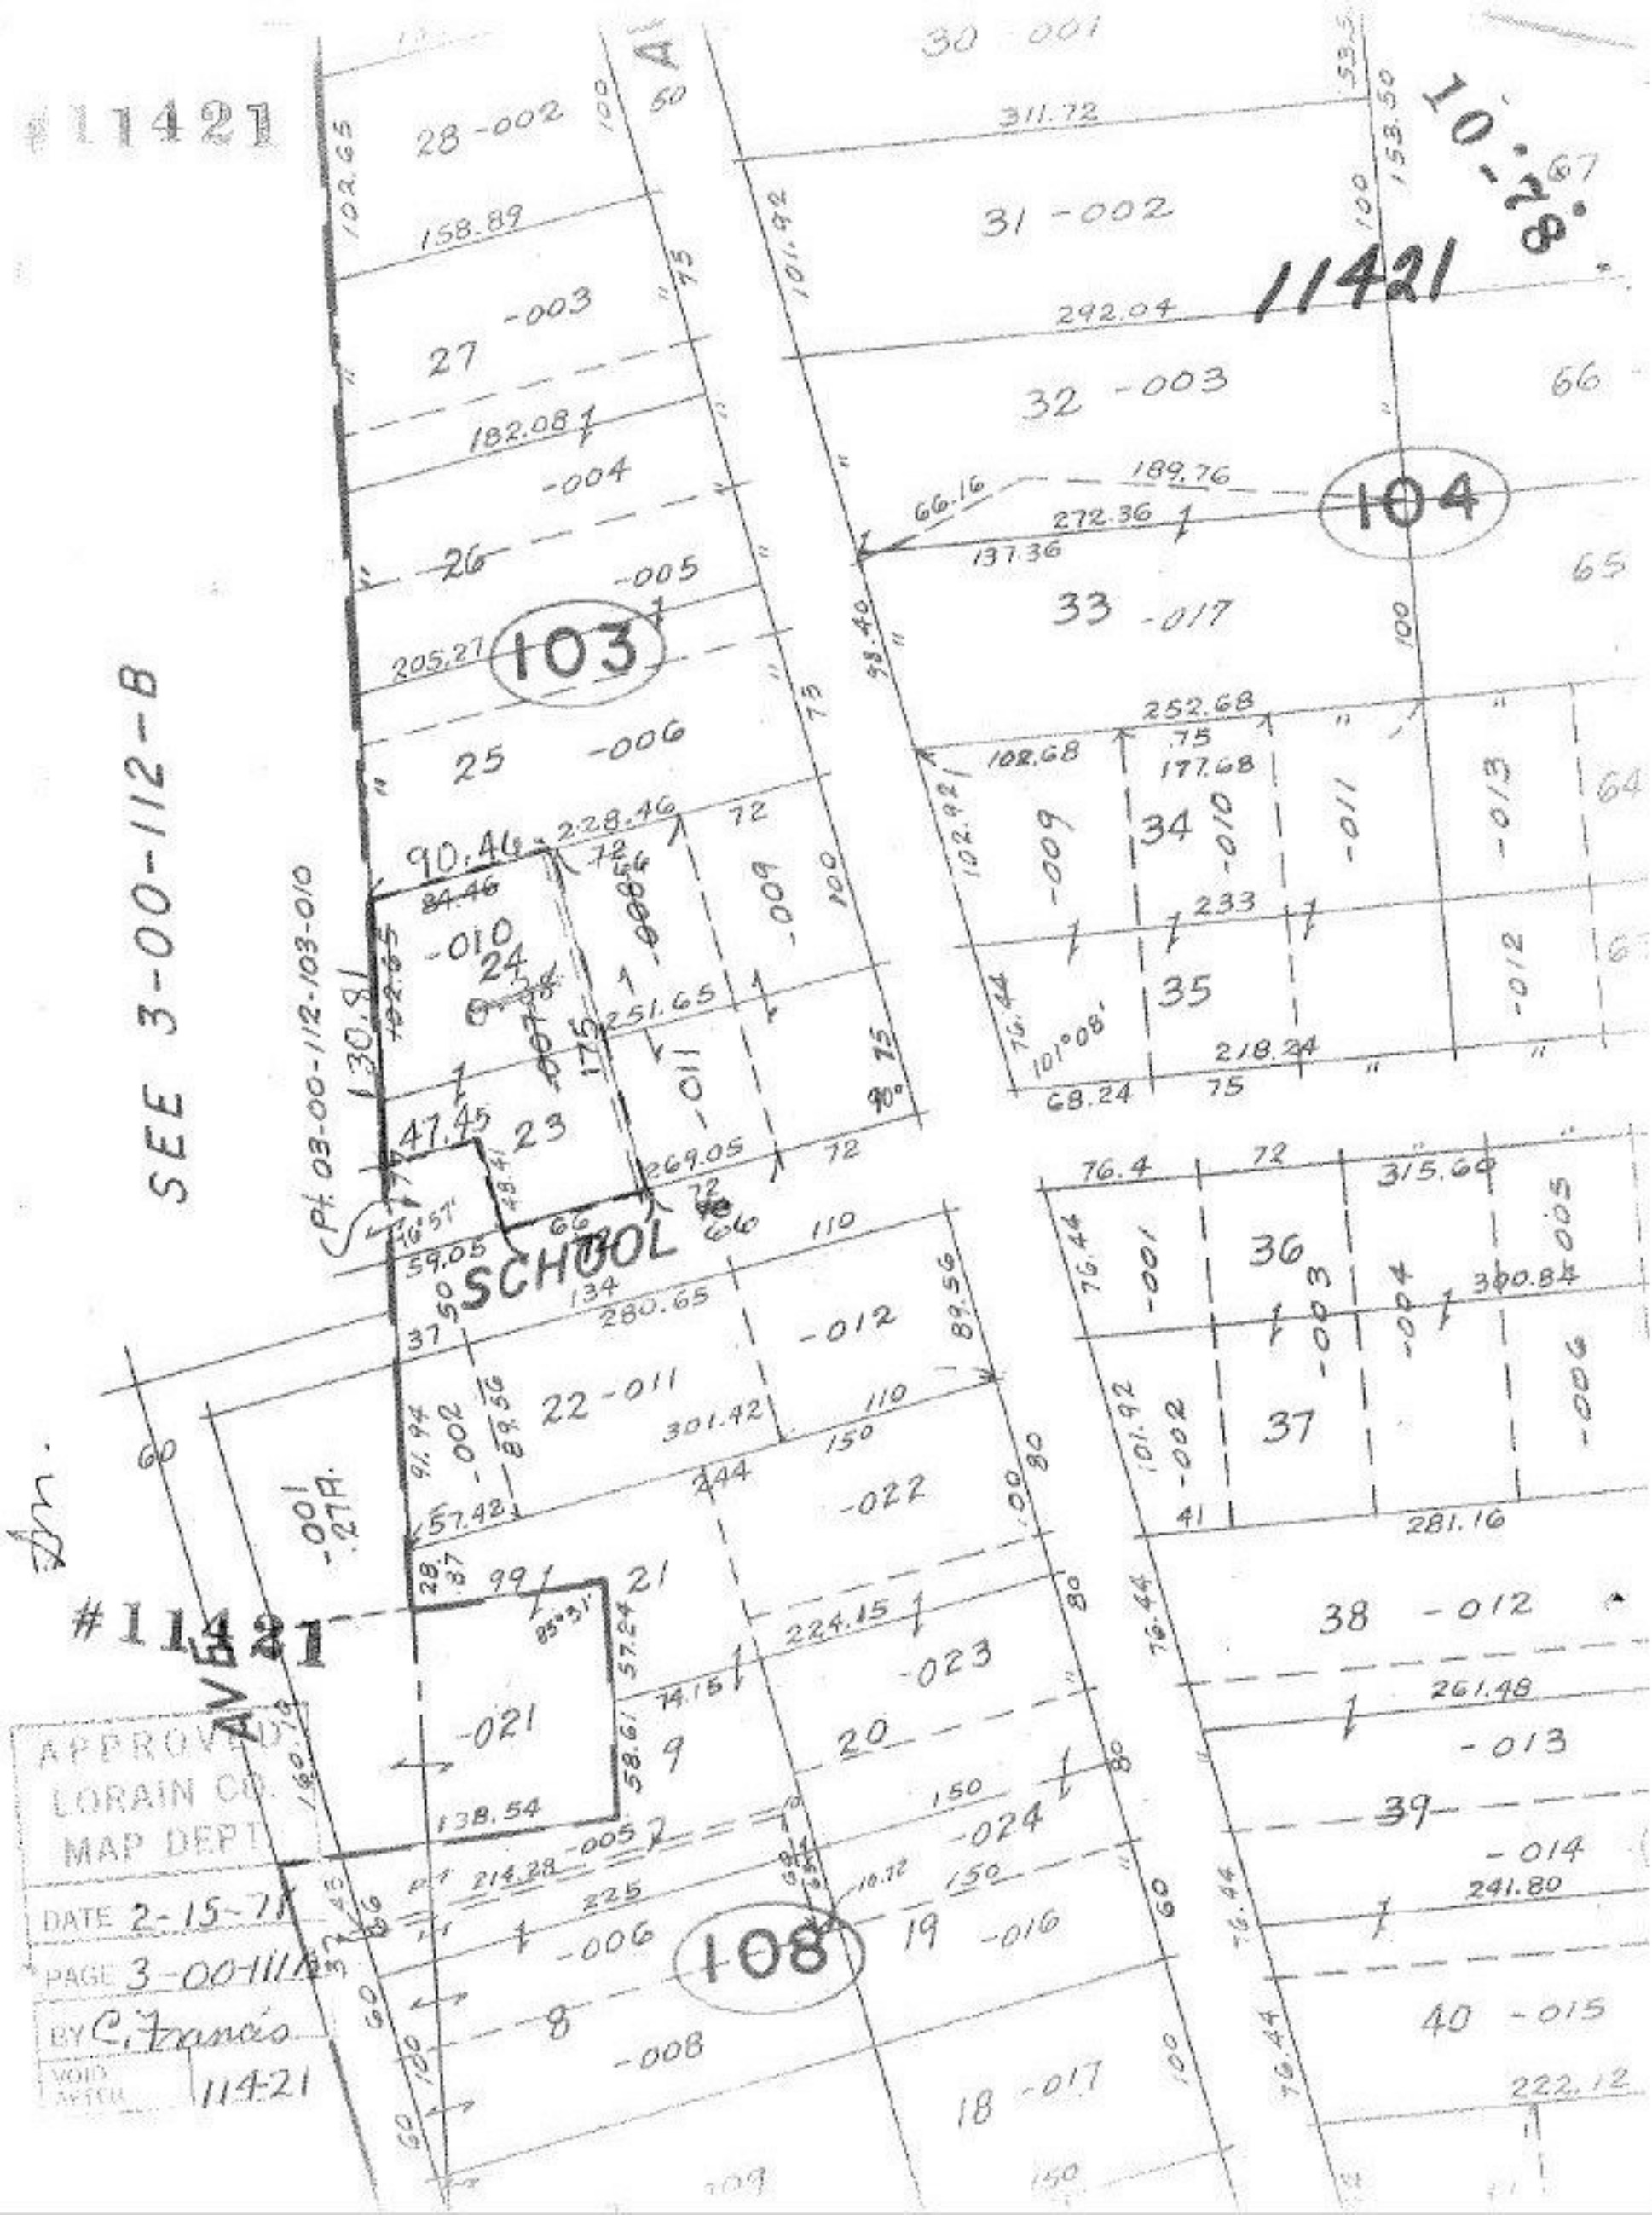

#11421
10-78
11421
SEE 3-00-112-B
Pt. 03-00-112-103-010
SCHOOL
AVE
103
104
108
#11421
APPROVED
LORAIN CO.
MAP DEPT.
DATE 2-15-71
PAGE 3-00-111A
BY C. Francis
VOID AFTER 11421