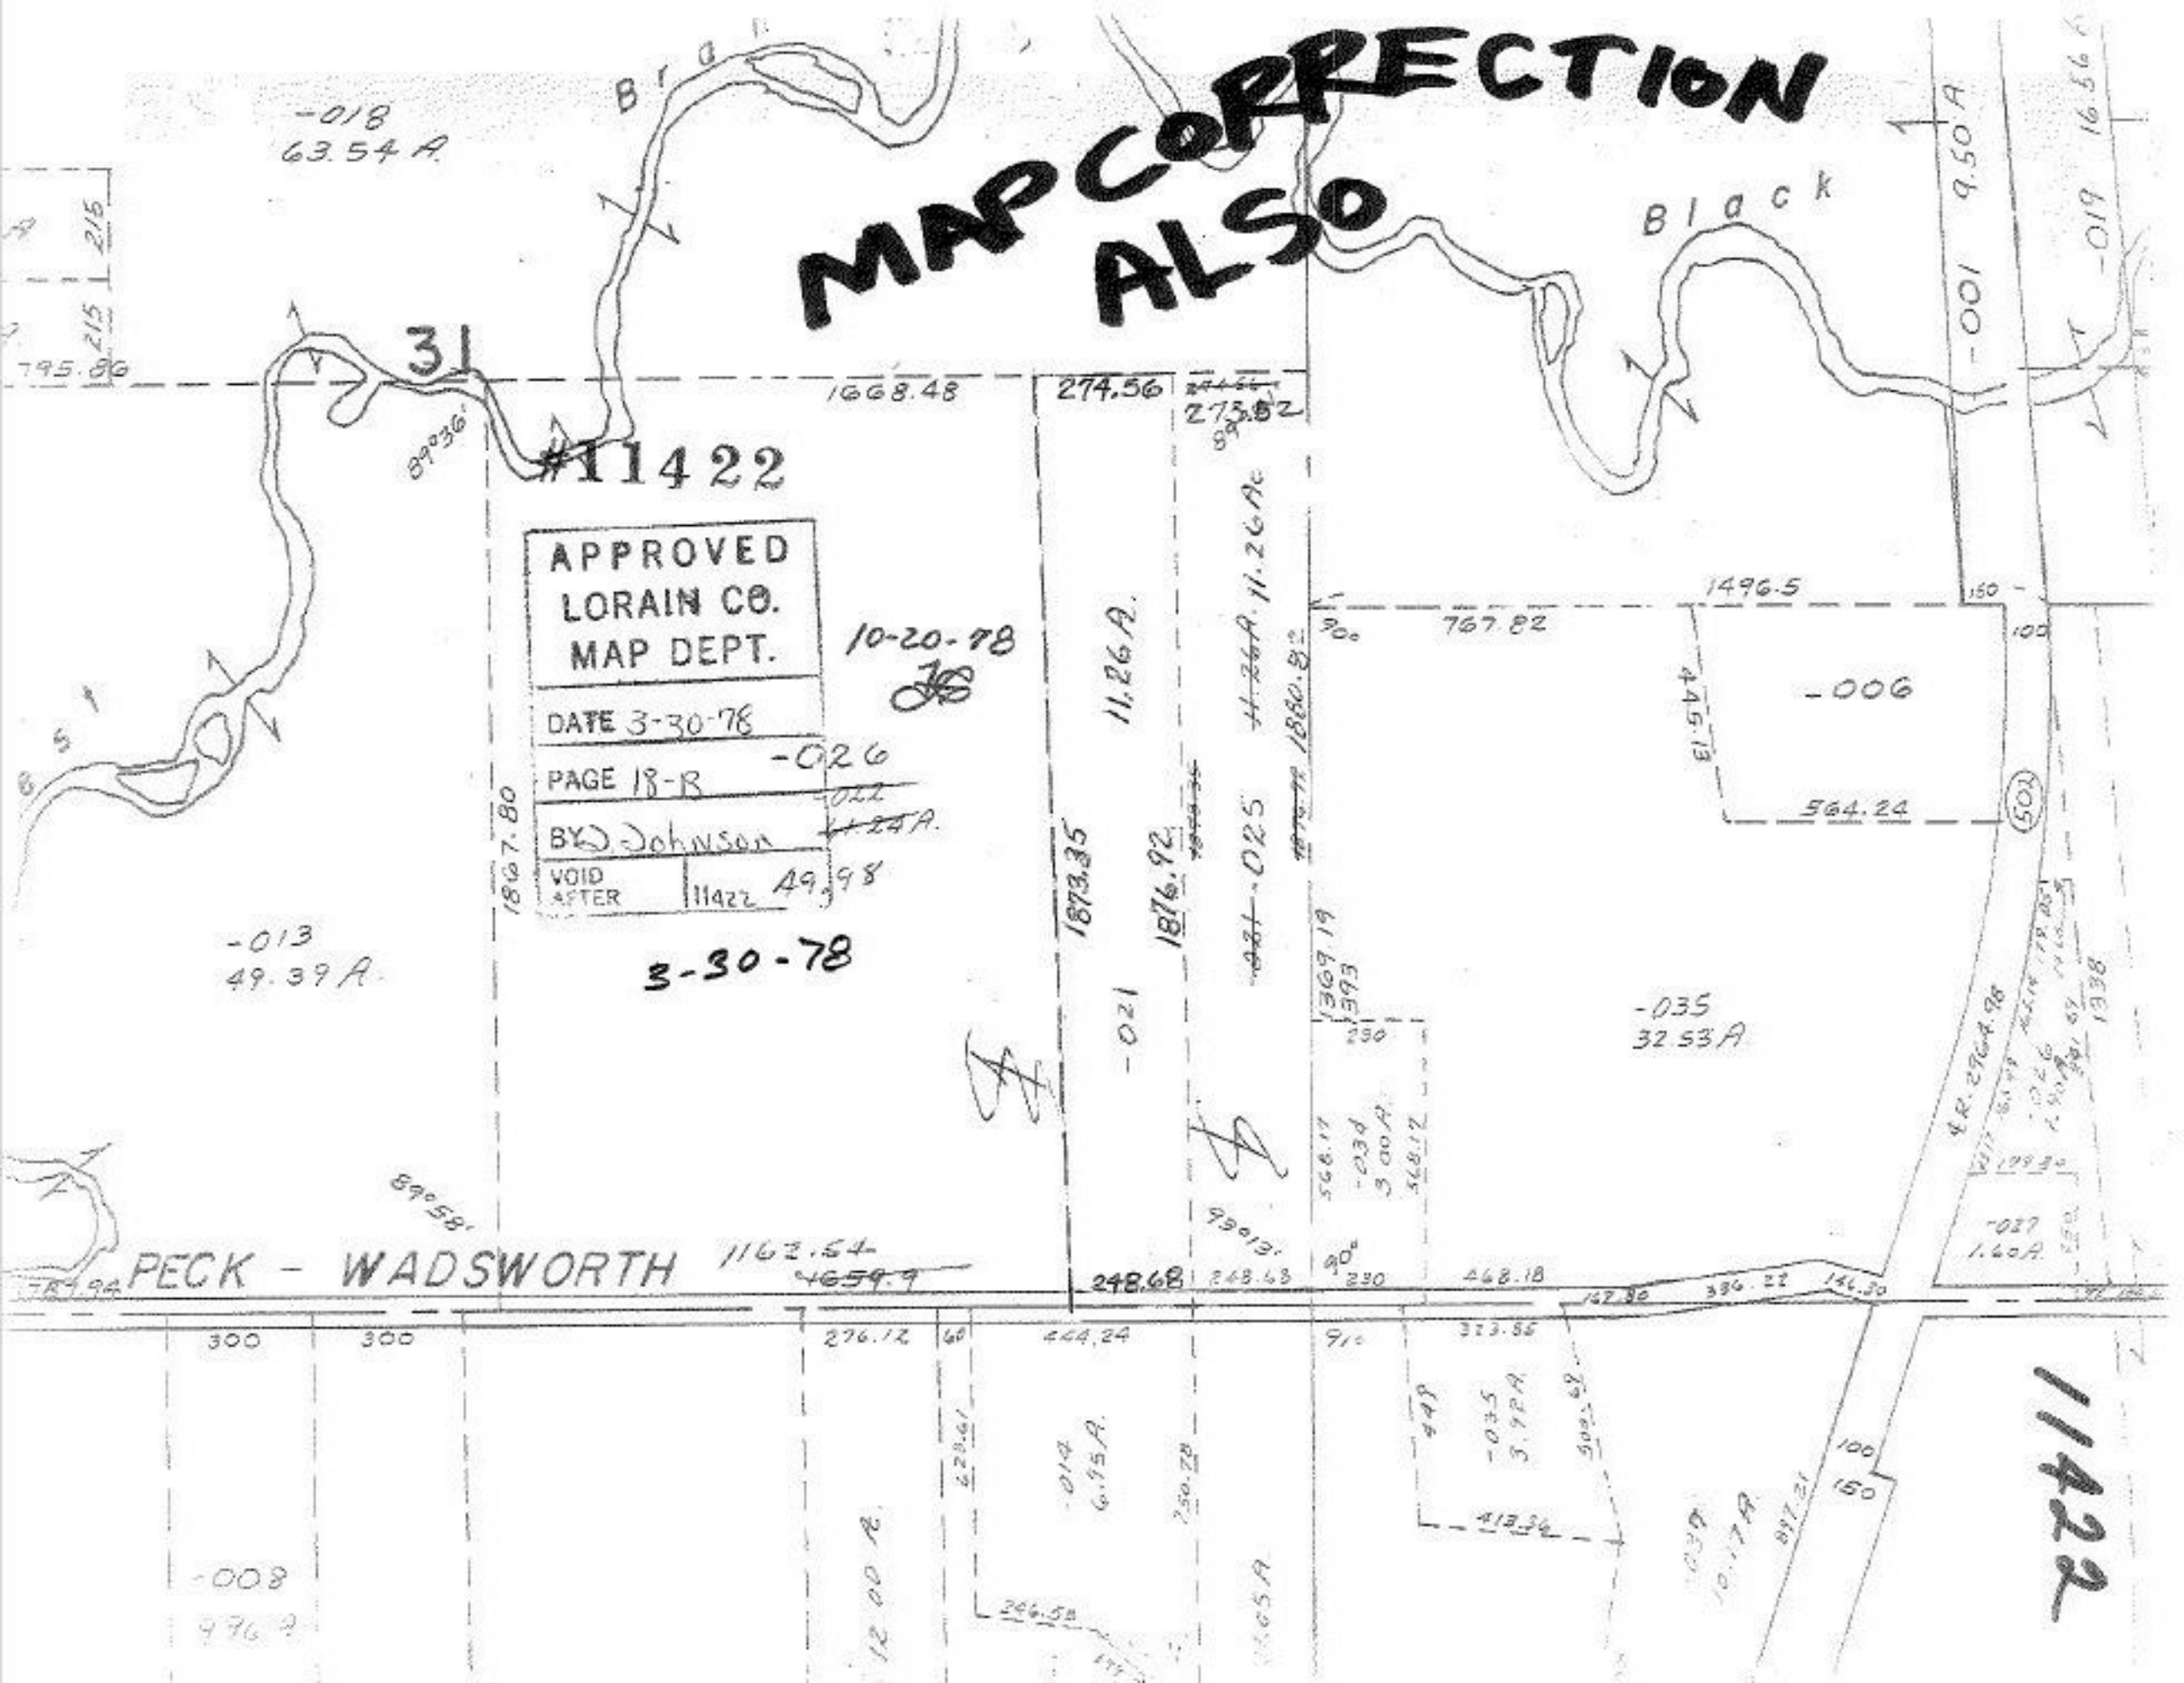
MAP CORRECTION ALSO
#11422
APPROVED
LORAIN CO.
MAP DEPT.
DATE 3-30-78
PAGE 18-B
BY D. Johnson
VOID AFTER 11422
10-20-78
3-30-78
PECK - WADSWORTH
Black
-018
63.54 A.
-013
49.39 A.
-026
-022
-021
-025
-006
-035
32.53 A
-001
-019
-008
-027
1.60 A.
11.26 A.
11.26 Ac
1873.35
1876.92
1880.82
1496.5
767.82
564.24
1668.48
274.56
273.52
1867.80
1162.54
1659.9
248.68
248.68
468.18
276.12
444.24
323.85
413.36
1338
11422