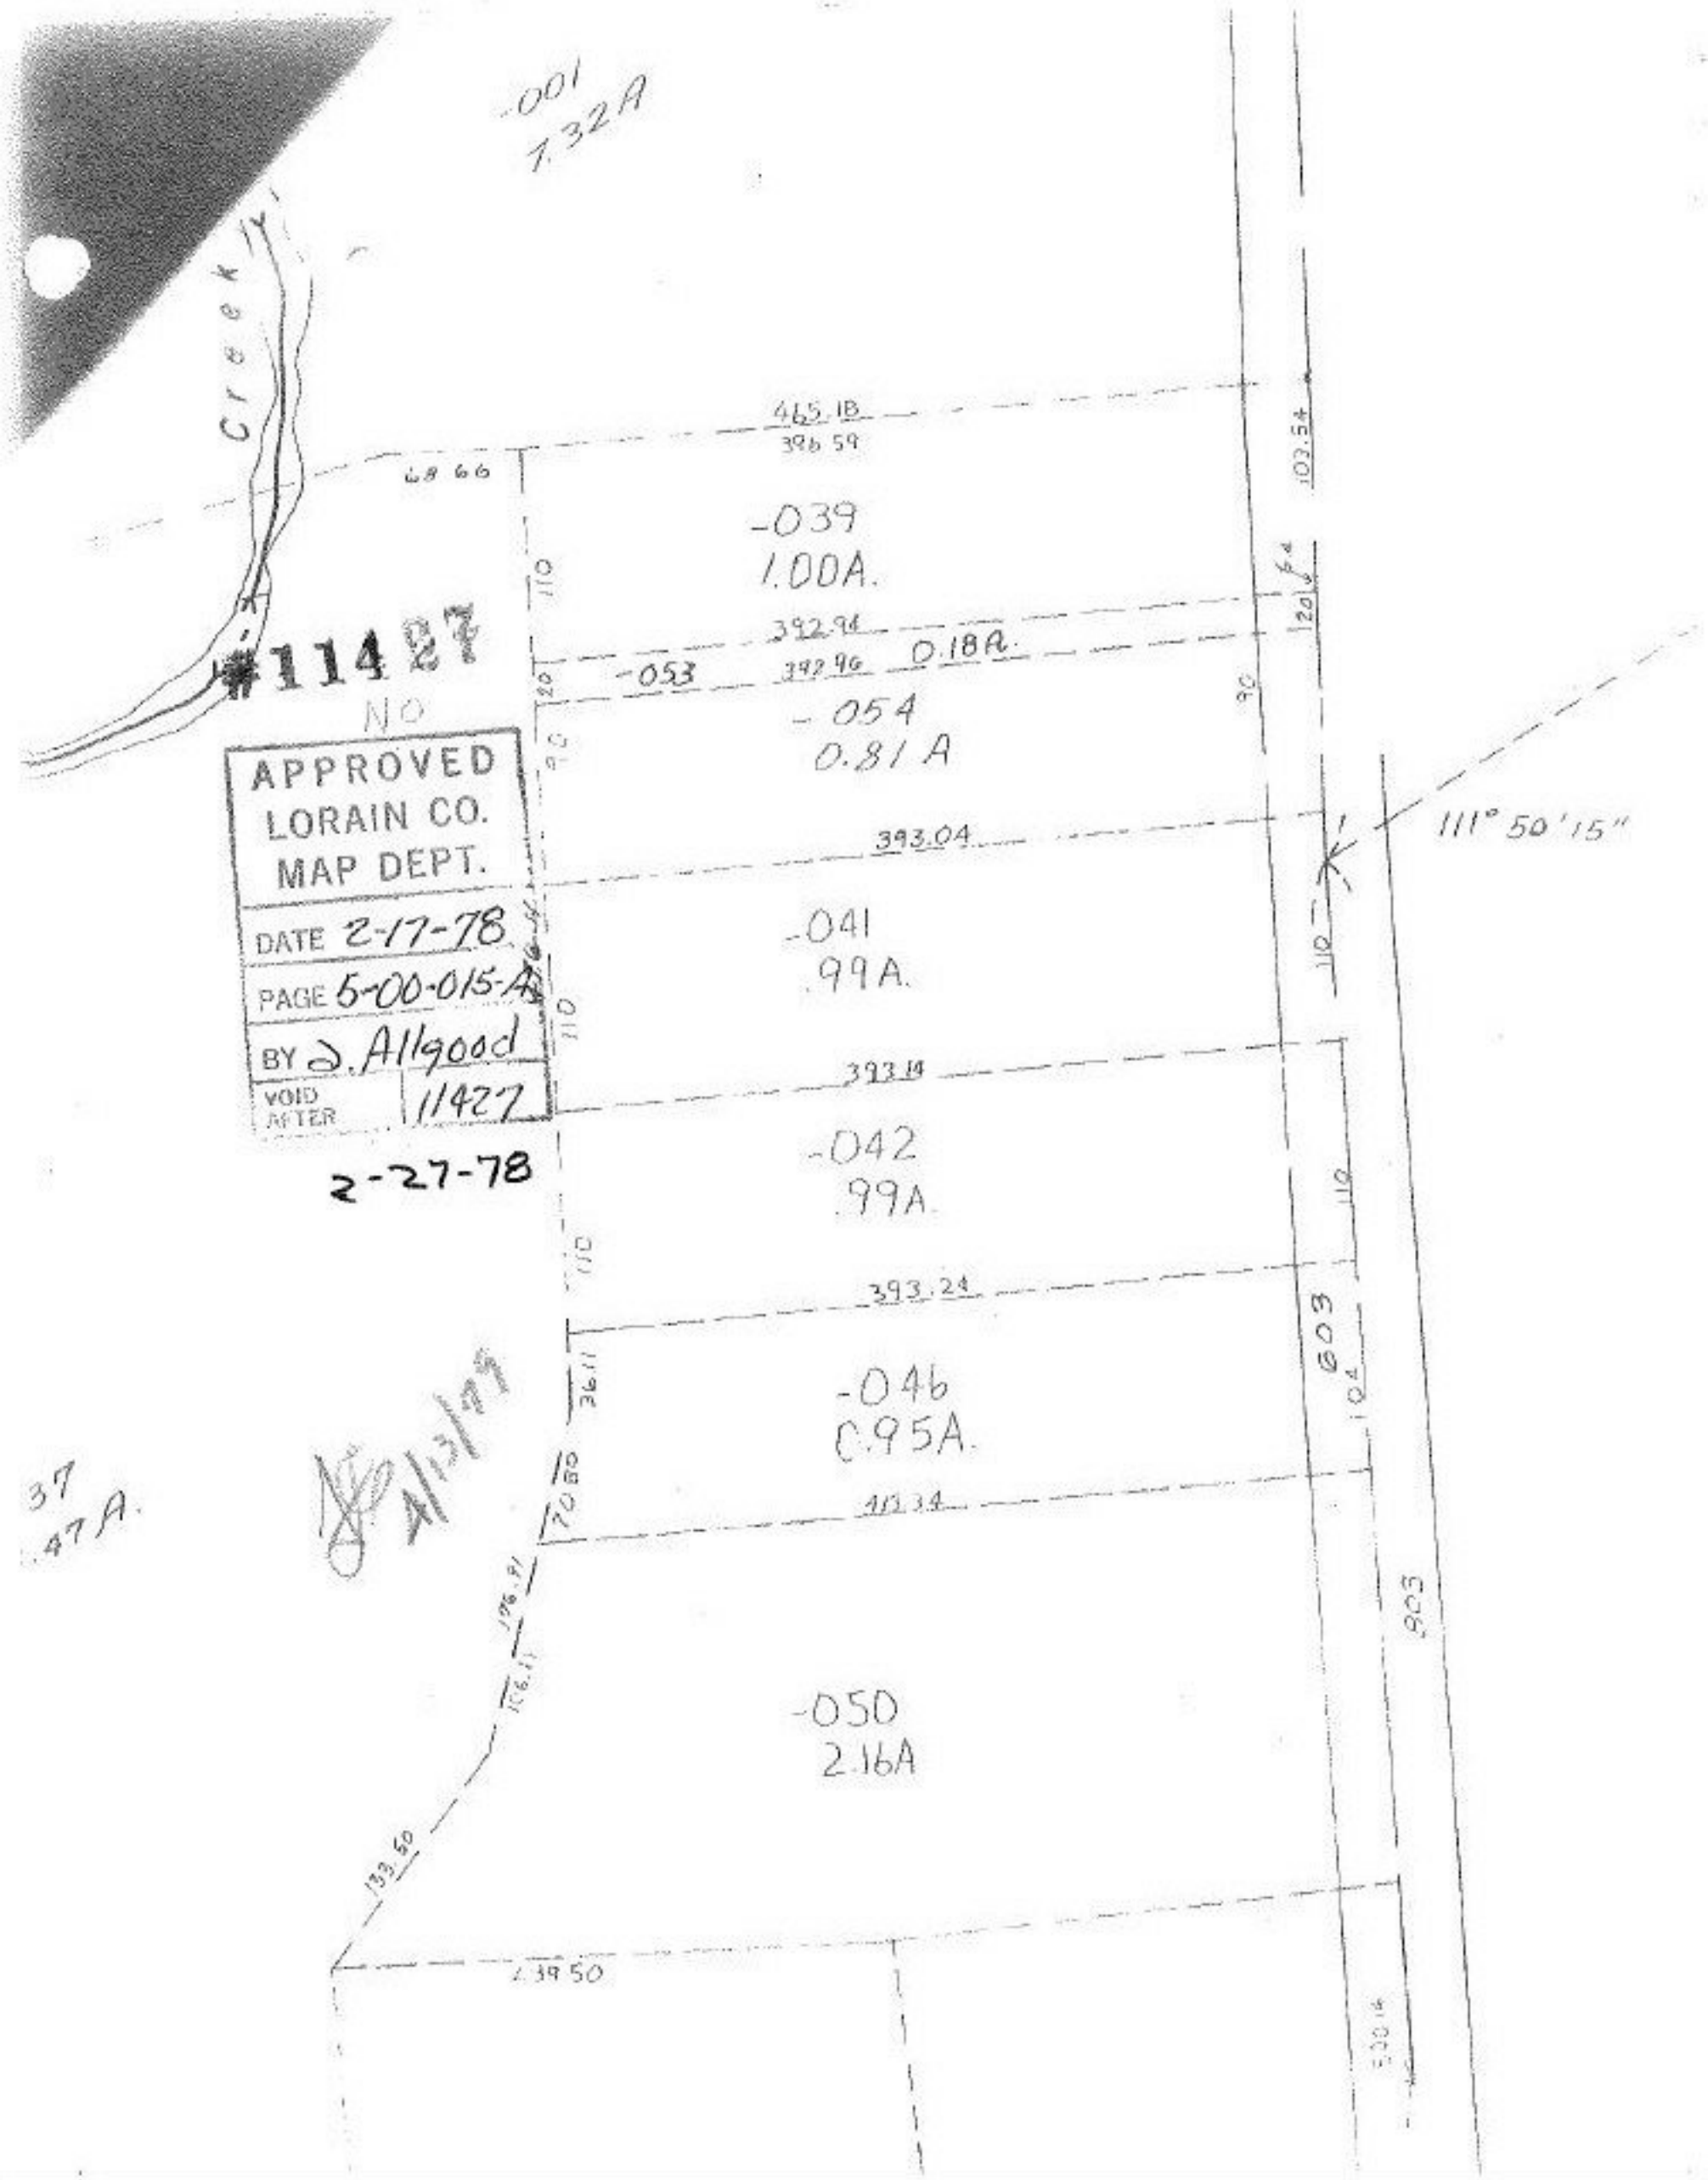

-001
7.32A
Creek
465.18
396.59
68.66
-039
1.00A.
392.94
-053
392.96
0.18A.
-054
0.81 A
393.04
111° 50' 15"
-041
.99A.
393.14
-042
.99A.
393.24
-046
0.95A.
413.34
-050
2.16A
133.50
439.50
103.54
603
903
#11427
NO
APPROVED
LORAIN CO.
MAP DEPT.
DATE 2-17-78
PAGE 5-00-015-A
BY J. Allgood
VOID AFTER 11427
2-27-78
4/13/79
37
.47A.