#11430

#11430

APPROVED
LORAIN CO.
MAP DEPT.

DATE 2-22-78

PAGE 11-F South

BY T. McNair
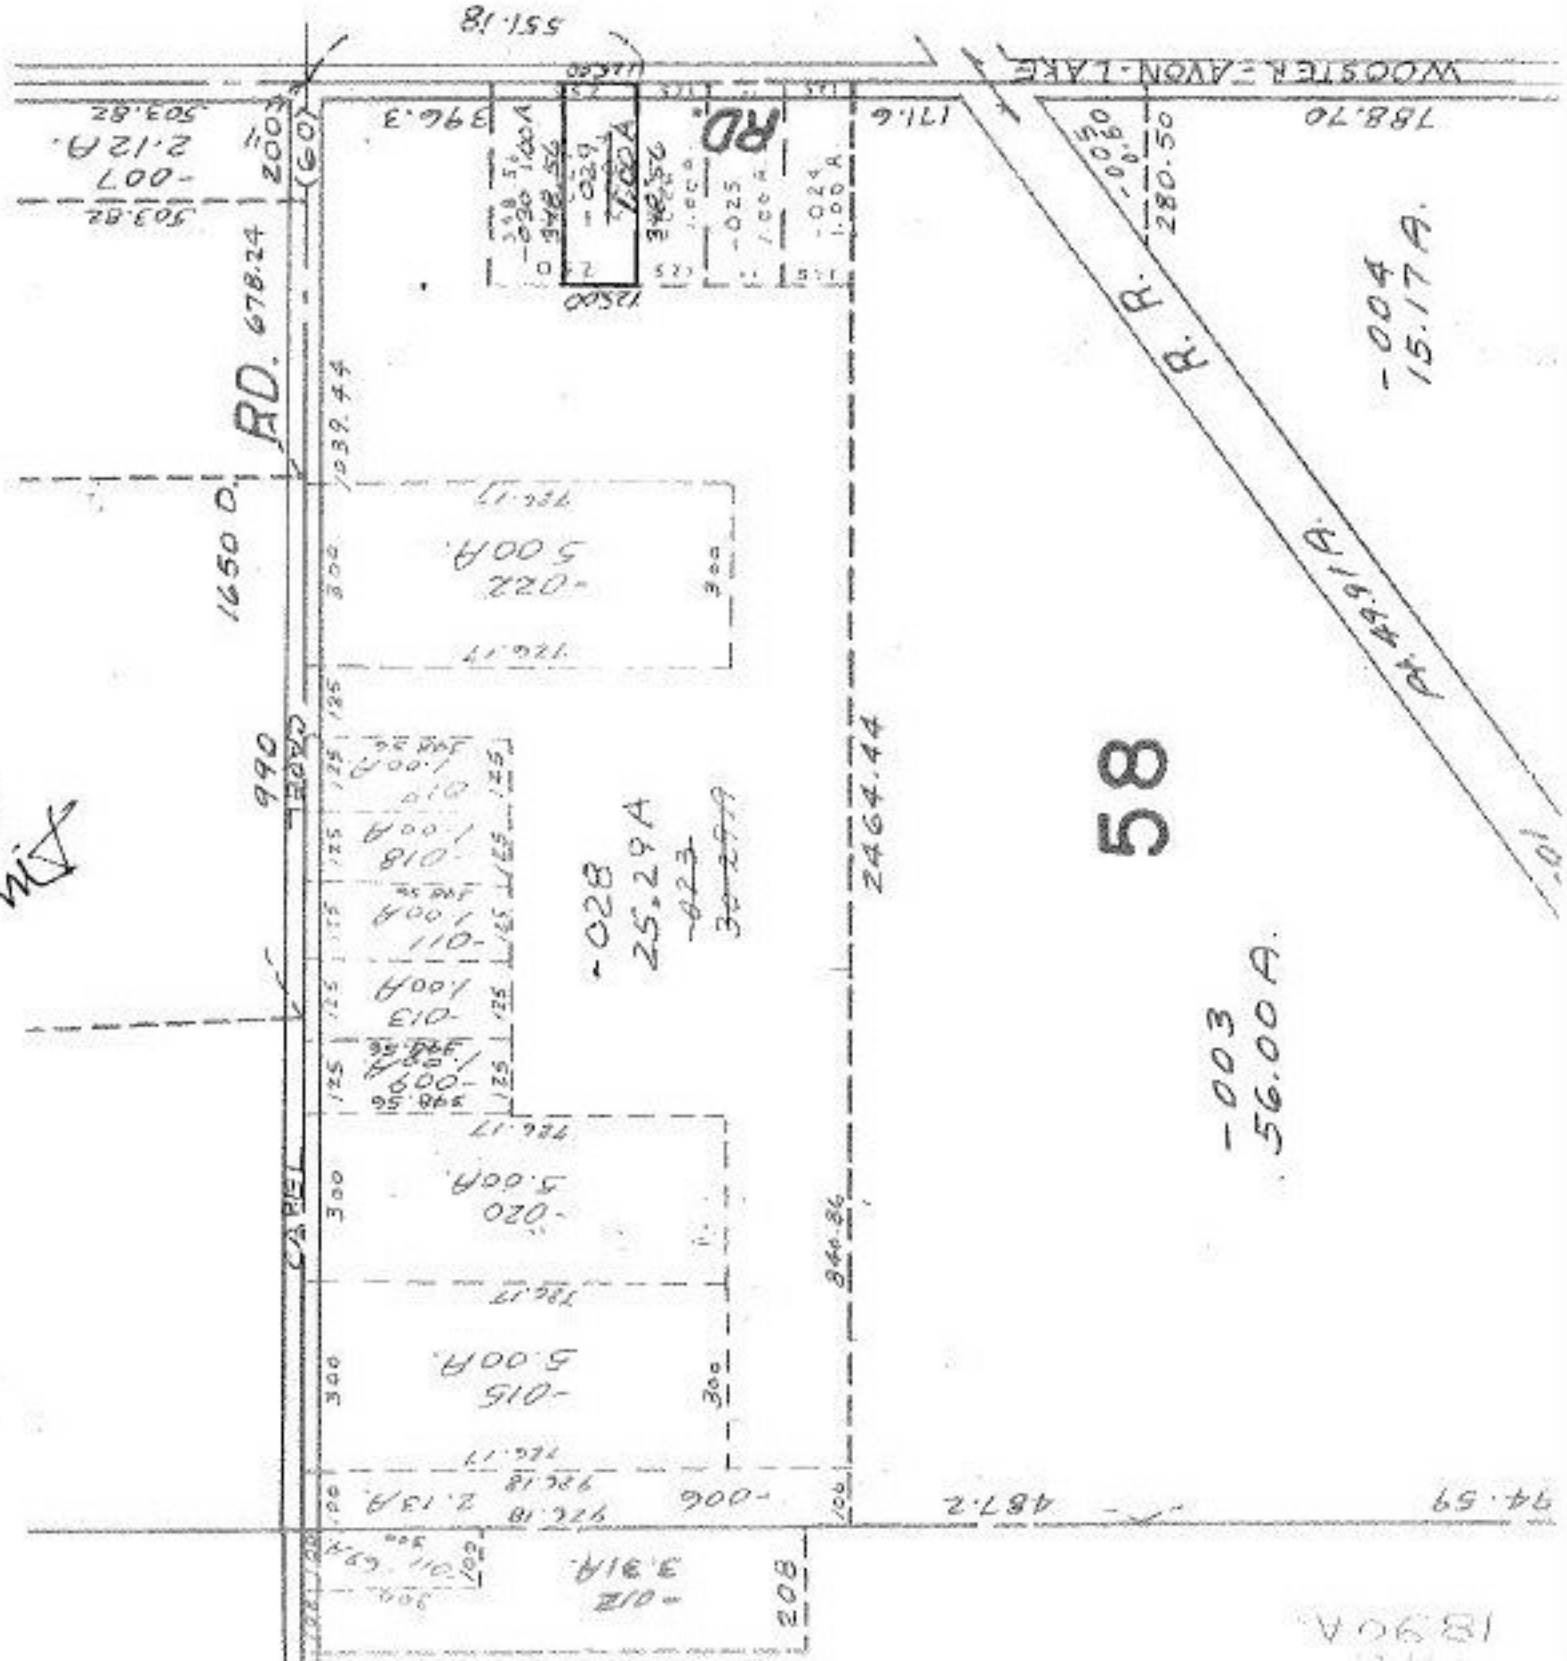
VOID AFTER 11430