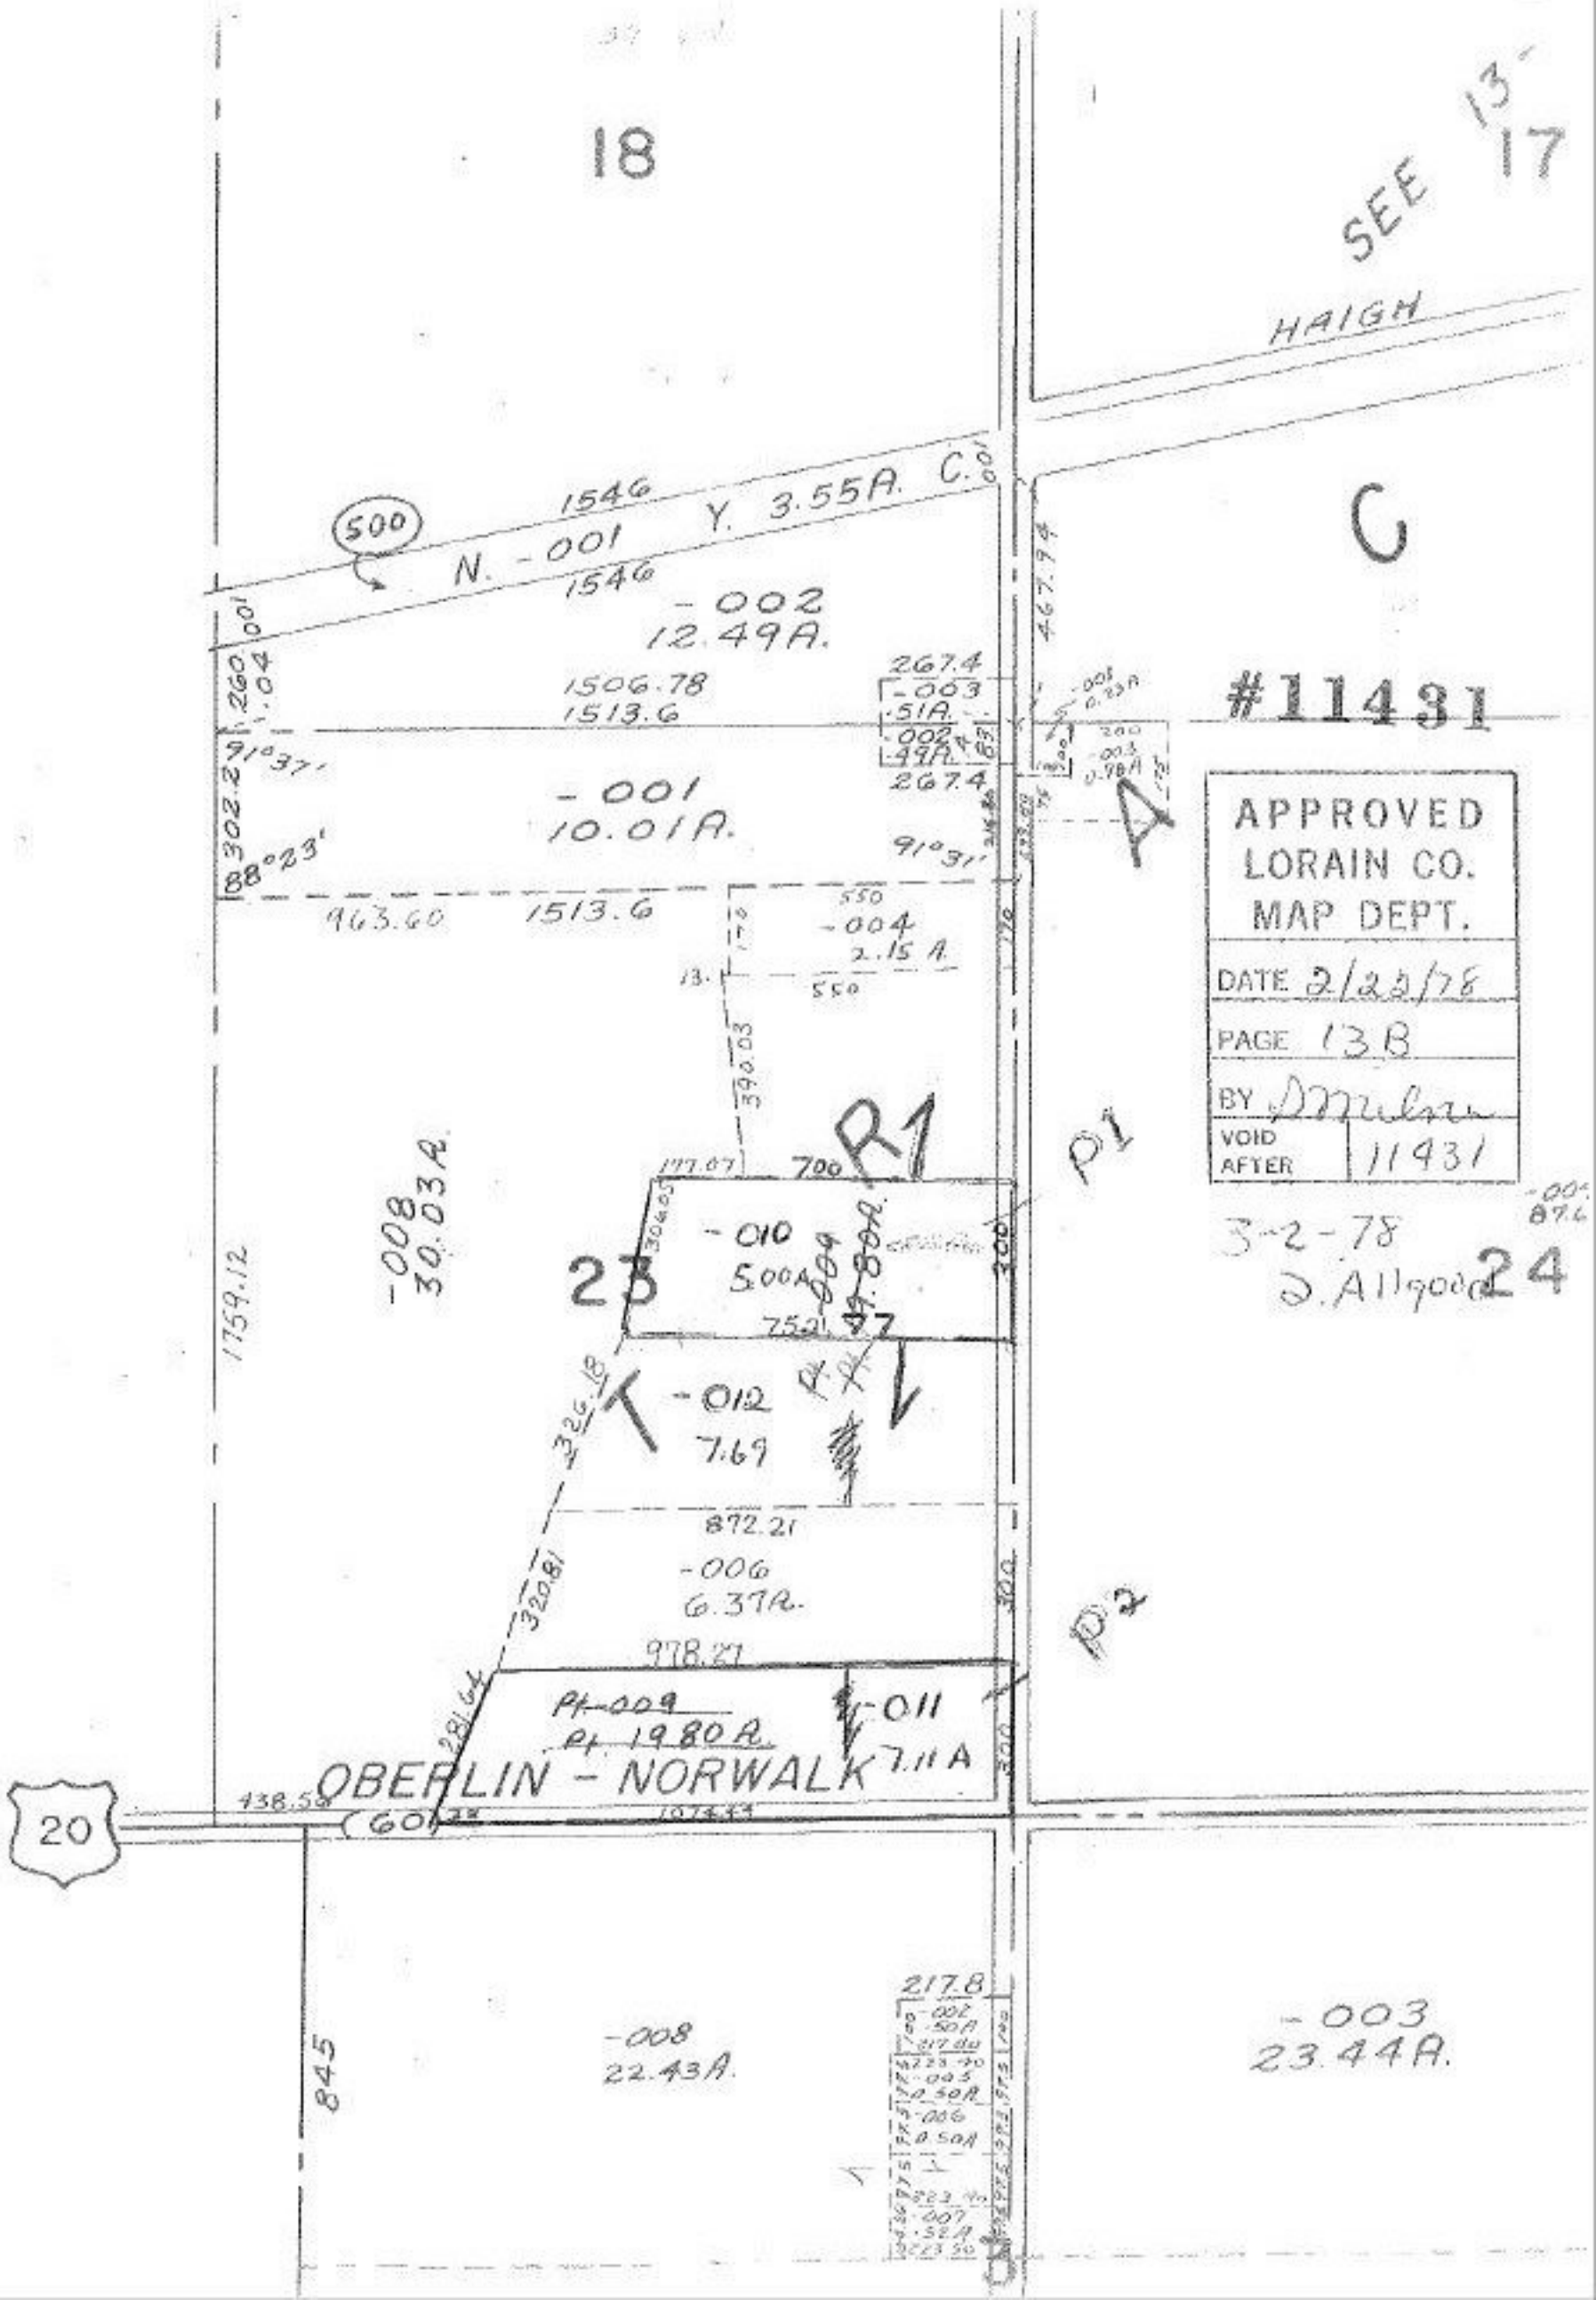
18
SEE 13-17
HAIGH
C
#11431
APPROVED
LORAIN CO.
MAP DEPT.
DATE 2/22/78
PAGE 13B
BY
VOID AFTER 11431
3-2-78
D. Allgood
24
23
R1
P1
P2
N. -001 Y. 3.55A. C.
-002
12.49A.
-001
10.01A.
-004
2.15 A
-008
30.03A
-010
5.00A
-012
7.69
-006
6.37A.
Pt-009
Pt 19.80 A.
-011
7.11 A
OBERLIN - NORWALK
20
-008
22.43A.
-003
23.44A.
1546
1506.78
1513.6
963.60
1759.12
845
872.21
978.27
217.8
467.94