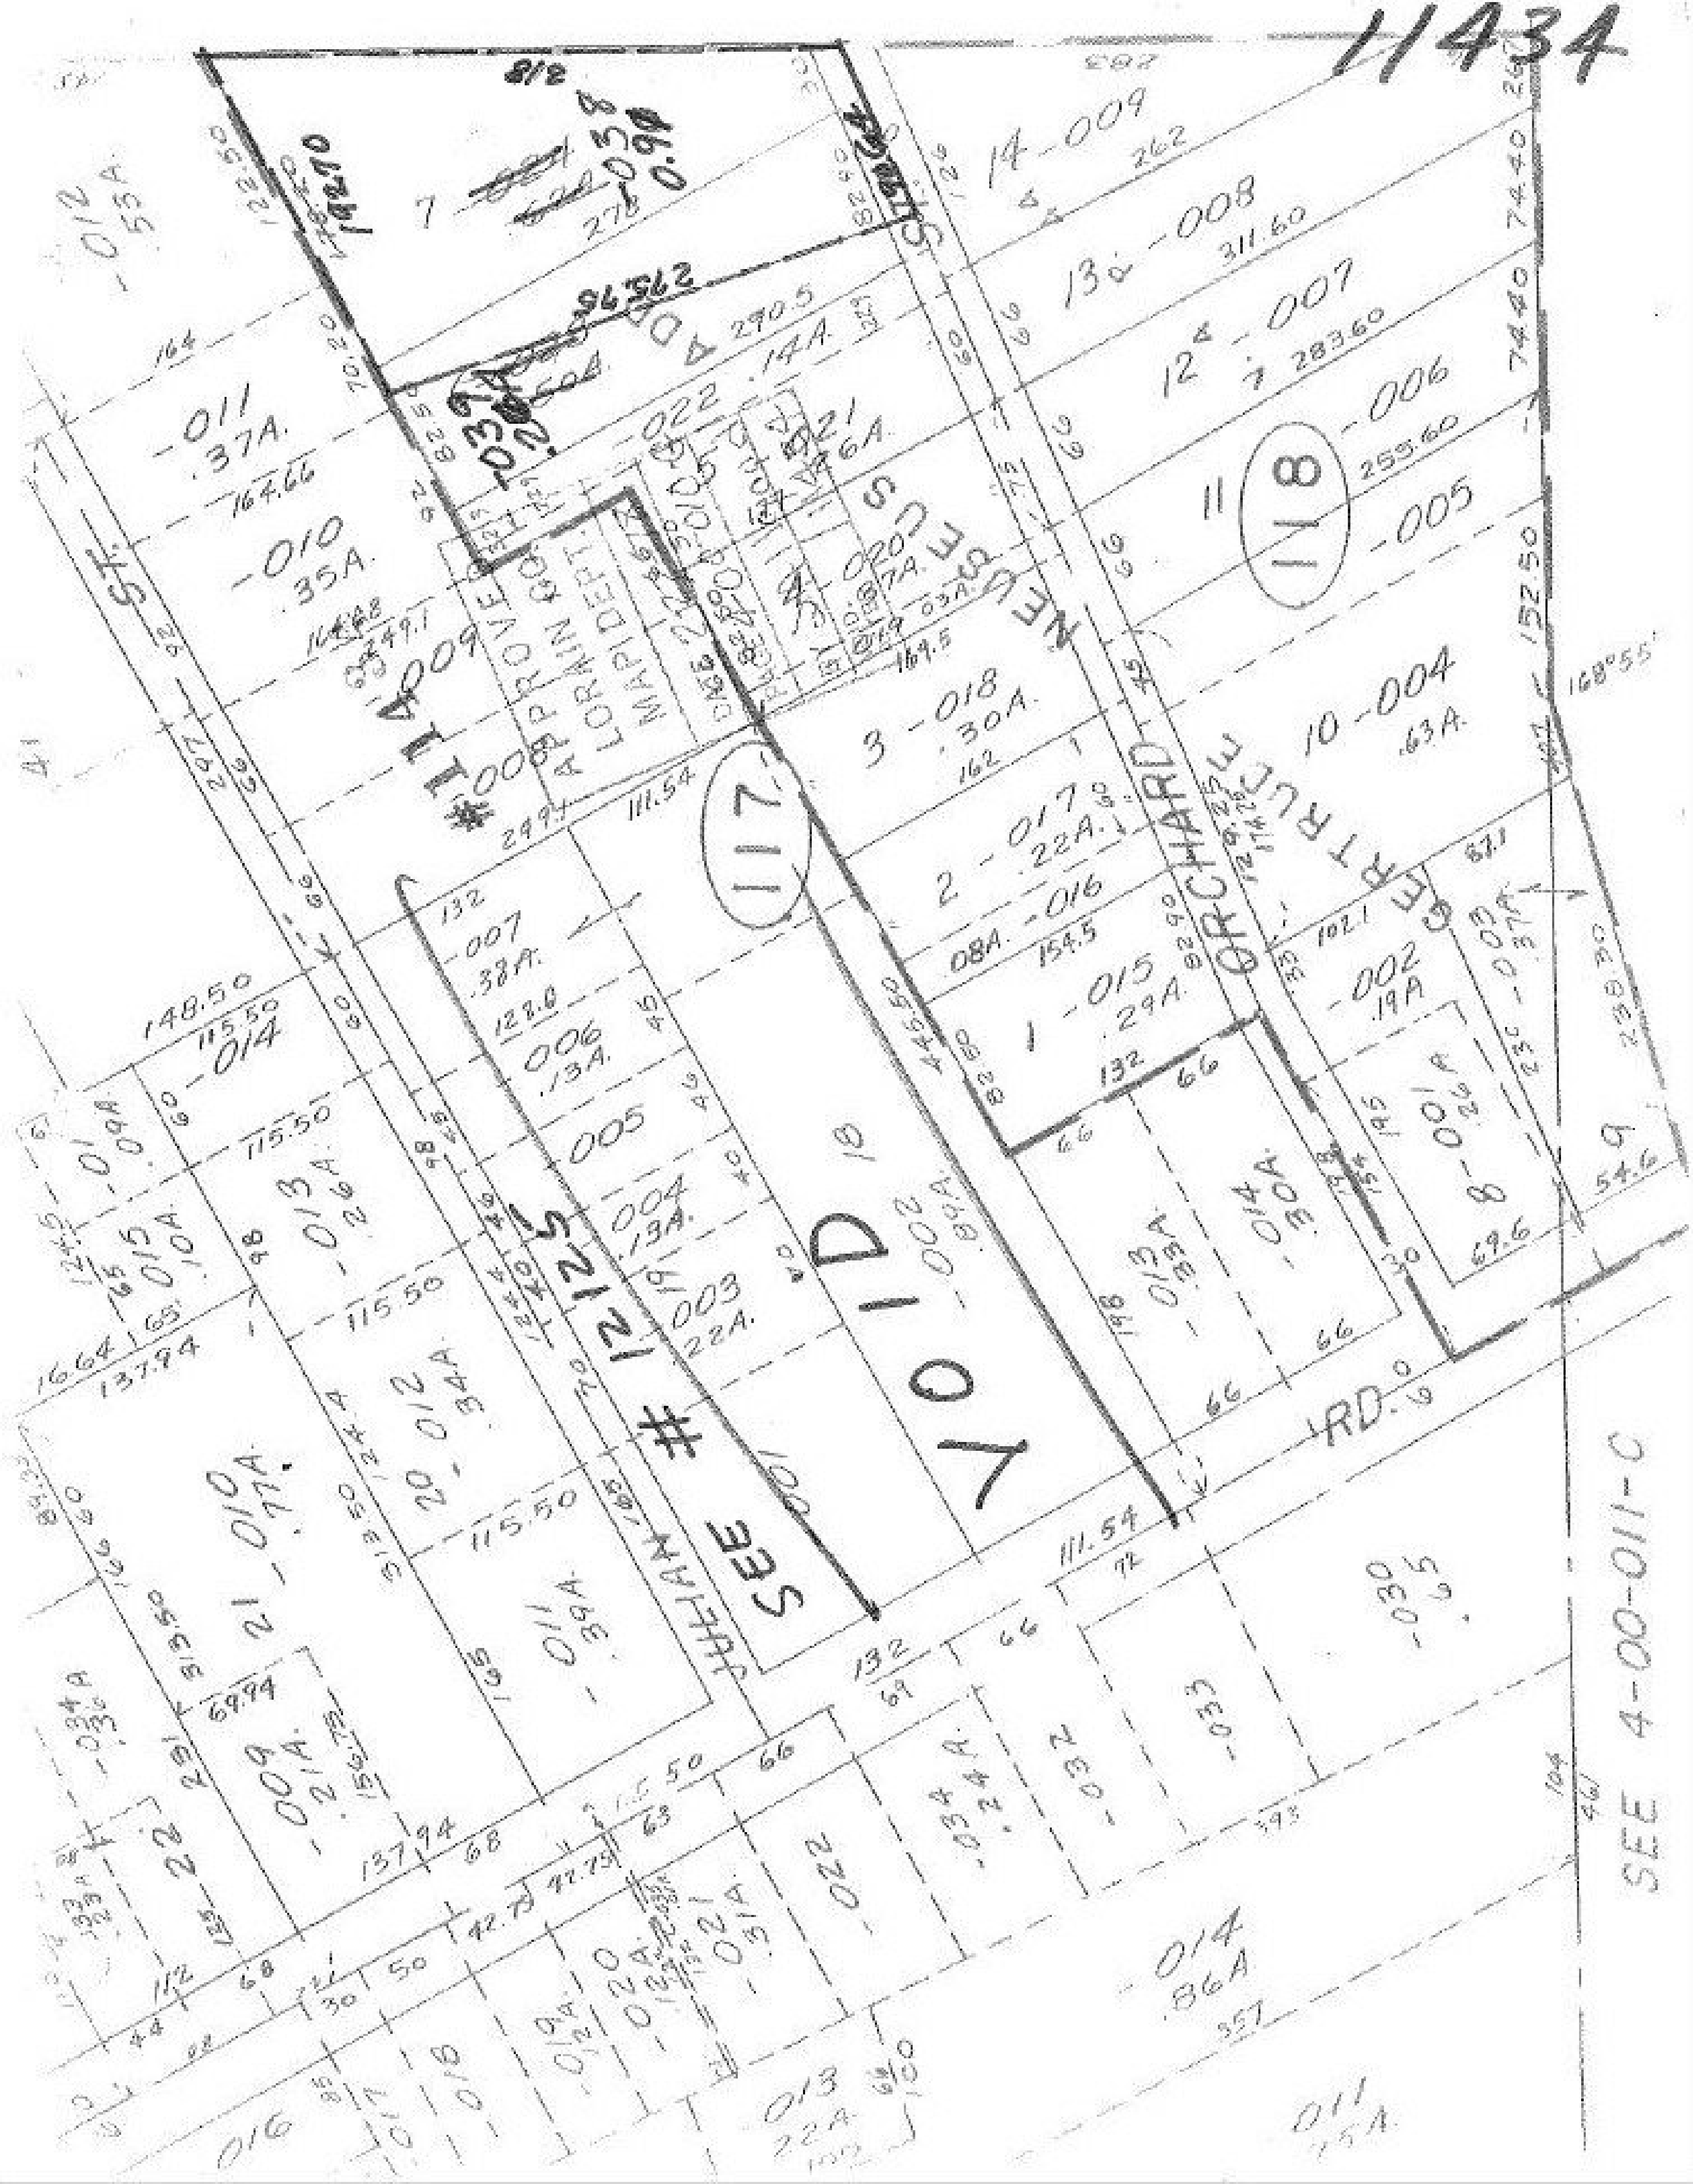

11434
JULIAN ST.
ORCHARD RD.
ORCHARD CT.
STEVENS
SEE #1212S
SEE 4-00-011-C
VOID
117
118
#114009
#008
APPROVED
LORAIN CO.
MAP DEPT.
7-038 0.98
-039A 0.20
-012 .55A
-011 .37A
-010 .35A
-022 .14A
-021 .16A
-020 .08A
-019 .03A
14-009
13-008
12-007
11-006
-005
10-004 .63A
3-018 .30A
2-017 .22A
-016 .08A
1-015 .29A
-002 .19A
-003 .37A
8-001 .26A
9
-007 .38A
006 .13A
005
004 .13A
-003 .22A
-002 .09A
-014
-013 .26A
-015 .10A
-01 .09A
20-012 .34A
21-010 .77A
-011 .39A
-009 .21A
-013 .33A
-014 .30A
22
-030 .65
-033
-032
-034 .24A
-034 .30A
-022
-021 .31A
-020
-019
-018
-017
-016
-013 .22A
-014 .86A
011 .45A
168°55'