11441

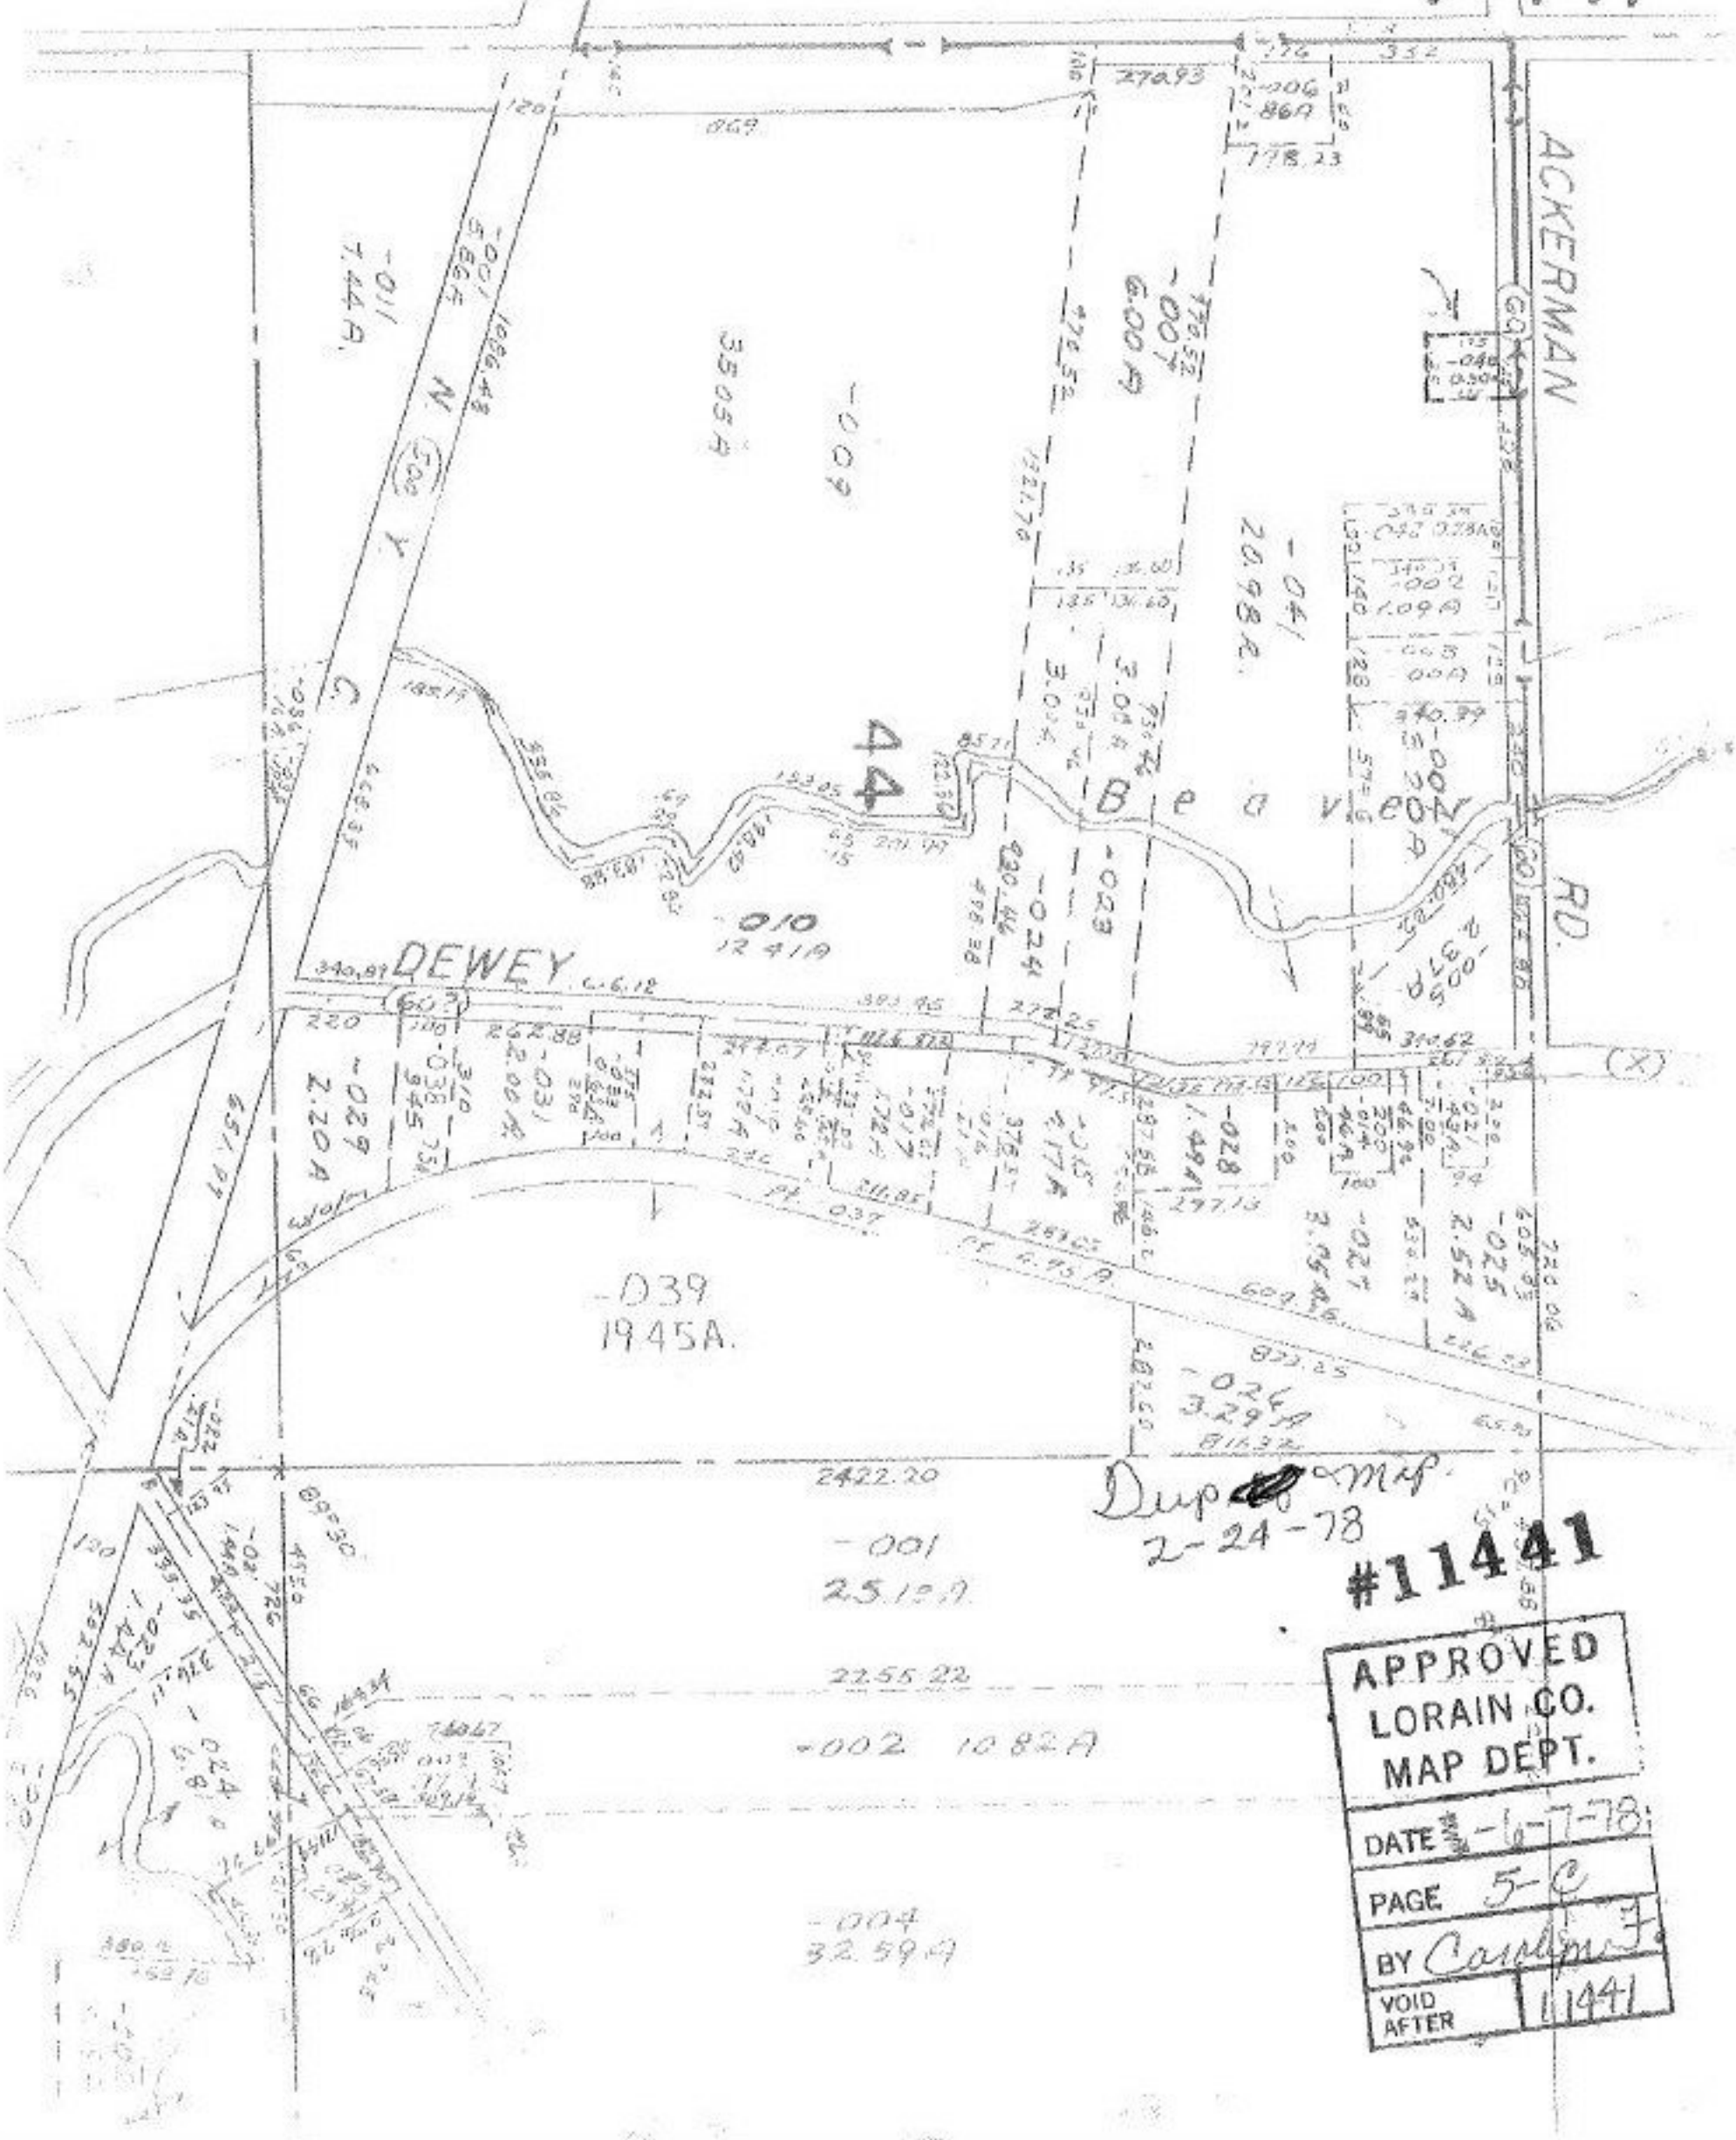

Dup map
2-24-78

#11441

APPROVED
LORAIN CO.
MAP DEPT.

DATE 6-7-78
PAGE 5-C
BY Carolyn F.
VOID AFTER 11441