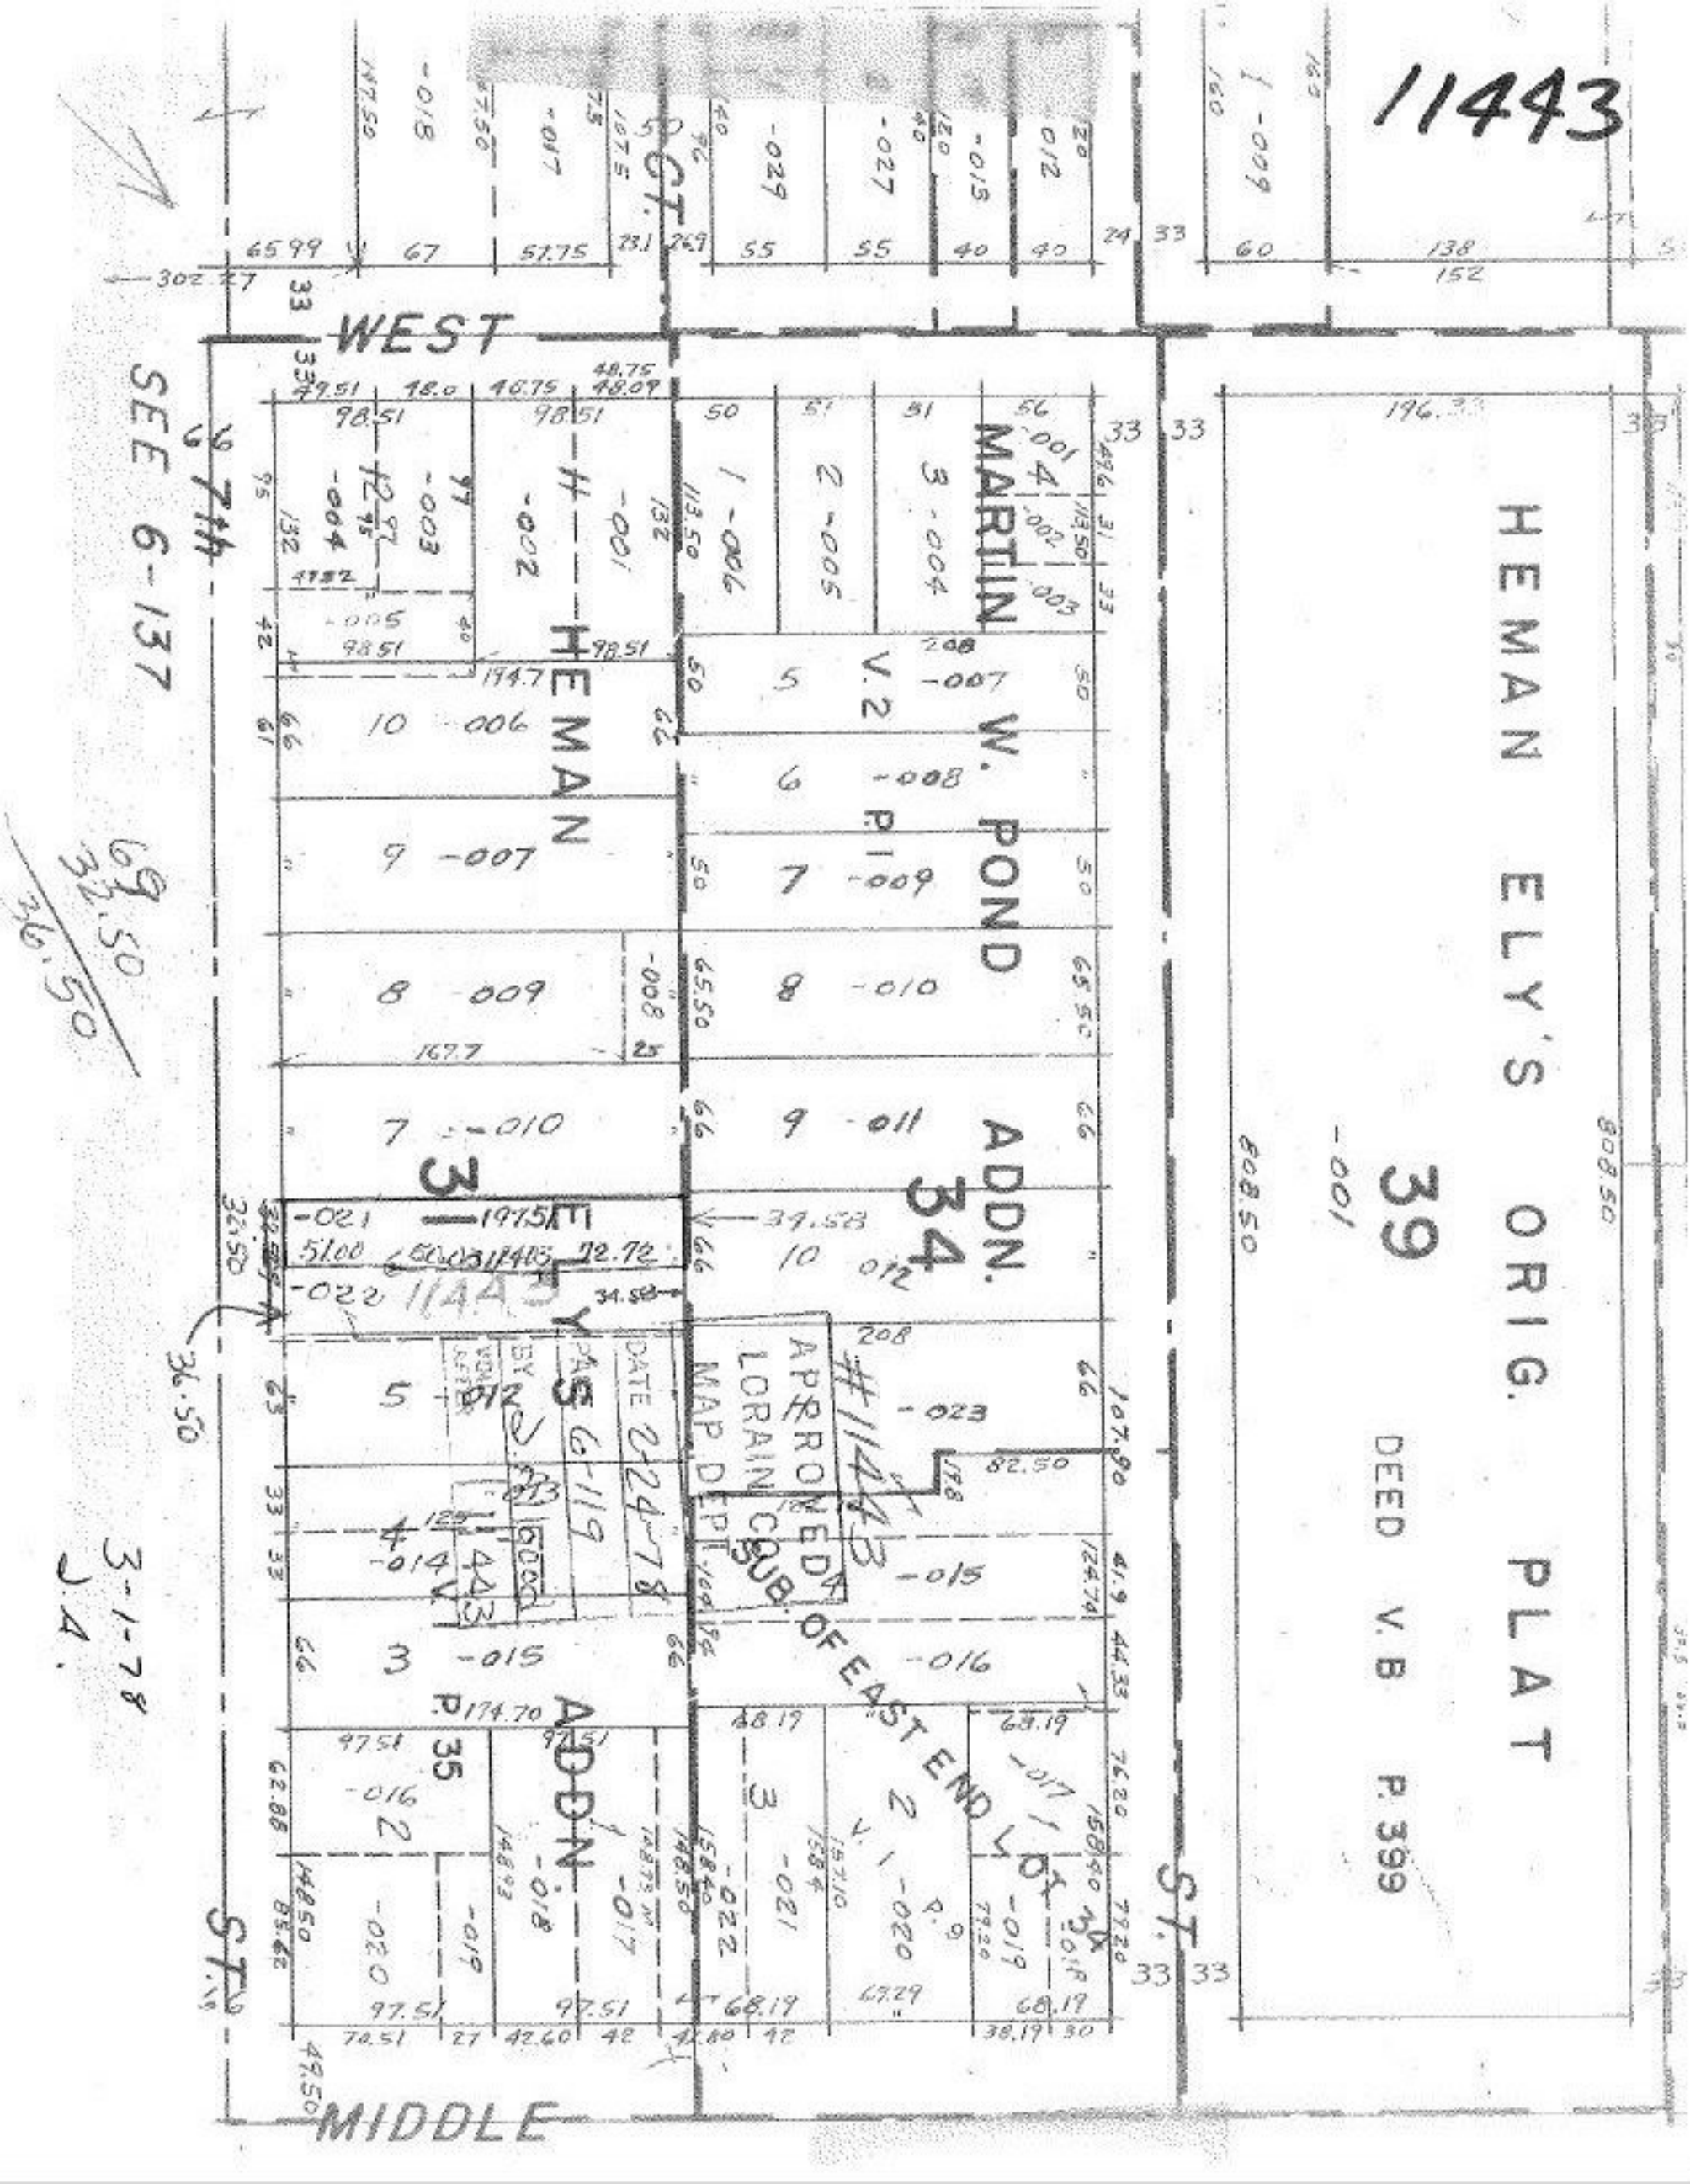
11443
WEST
MIDDLE
ST.
ST.
HEMAN ELY'S ORIG. PLAT
39
DEED V.B P. 399
MARTIN W. POND
ADDN. 34
HEMAN
ADDN.
SUB. OF EAST END LOT 34
APPROVED LORAIN CO. MAP DEPT.
DATE 2-24-78
PAGE 6-119
BY
SEE 6-137
7th
3-1-78
J.A.