11450

#11450

APPROVED
LORAIN CO.
MAP DEPT.

DATE 2-28-78

PAGE 5-00 018 B

BY T. McNa

VOID AFTER 11450
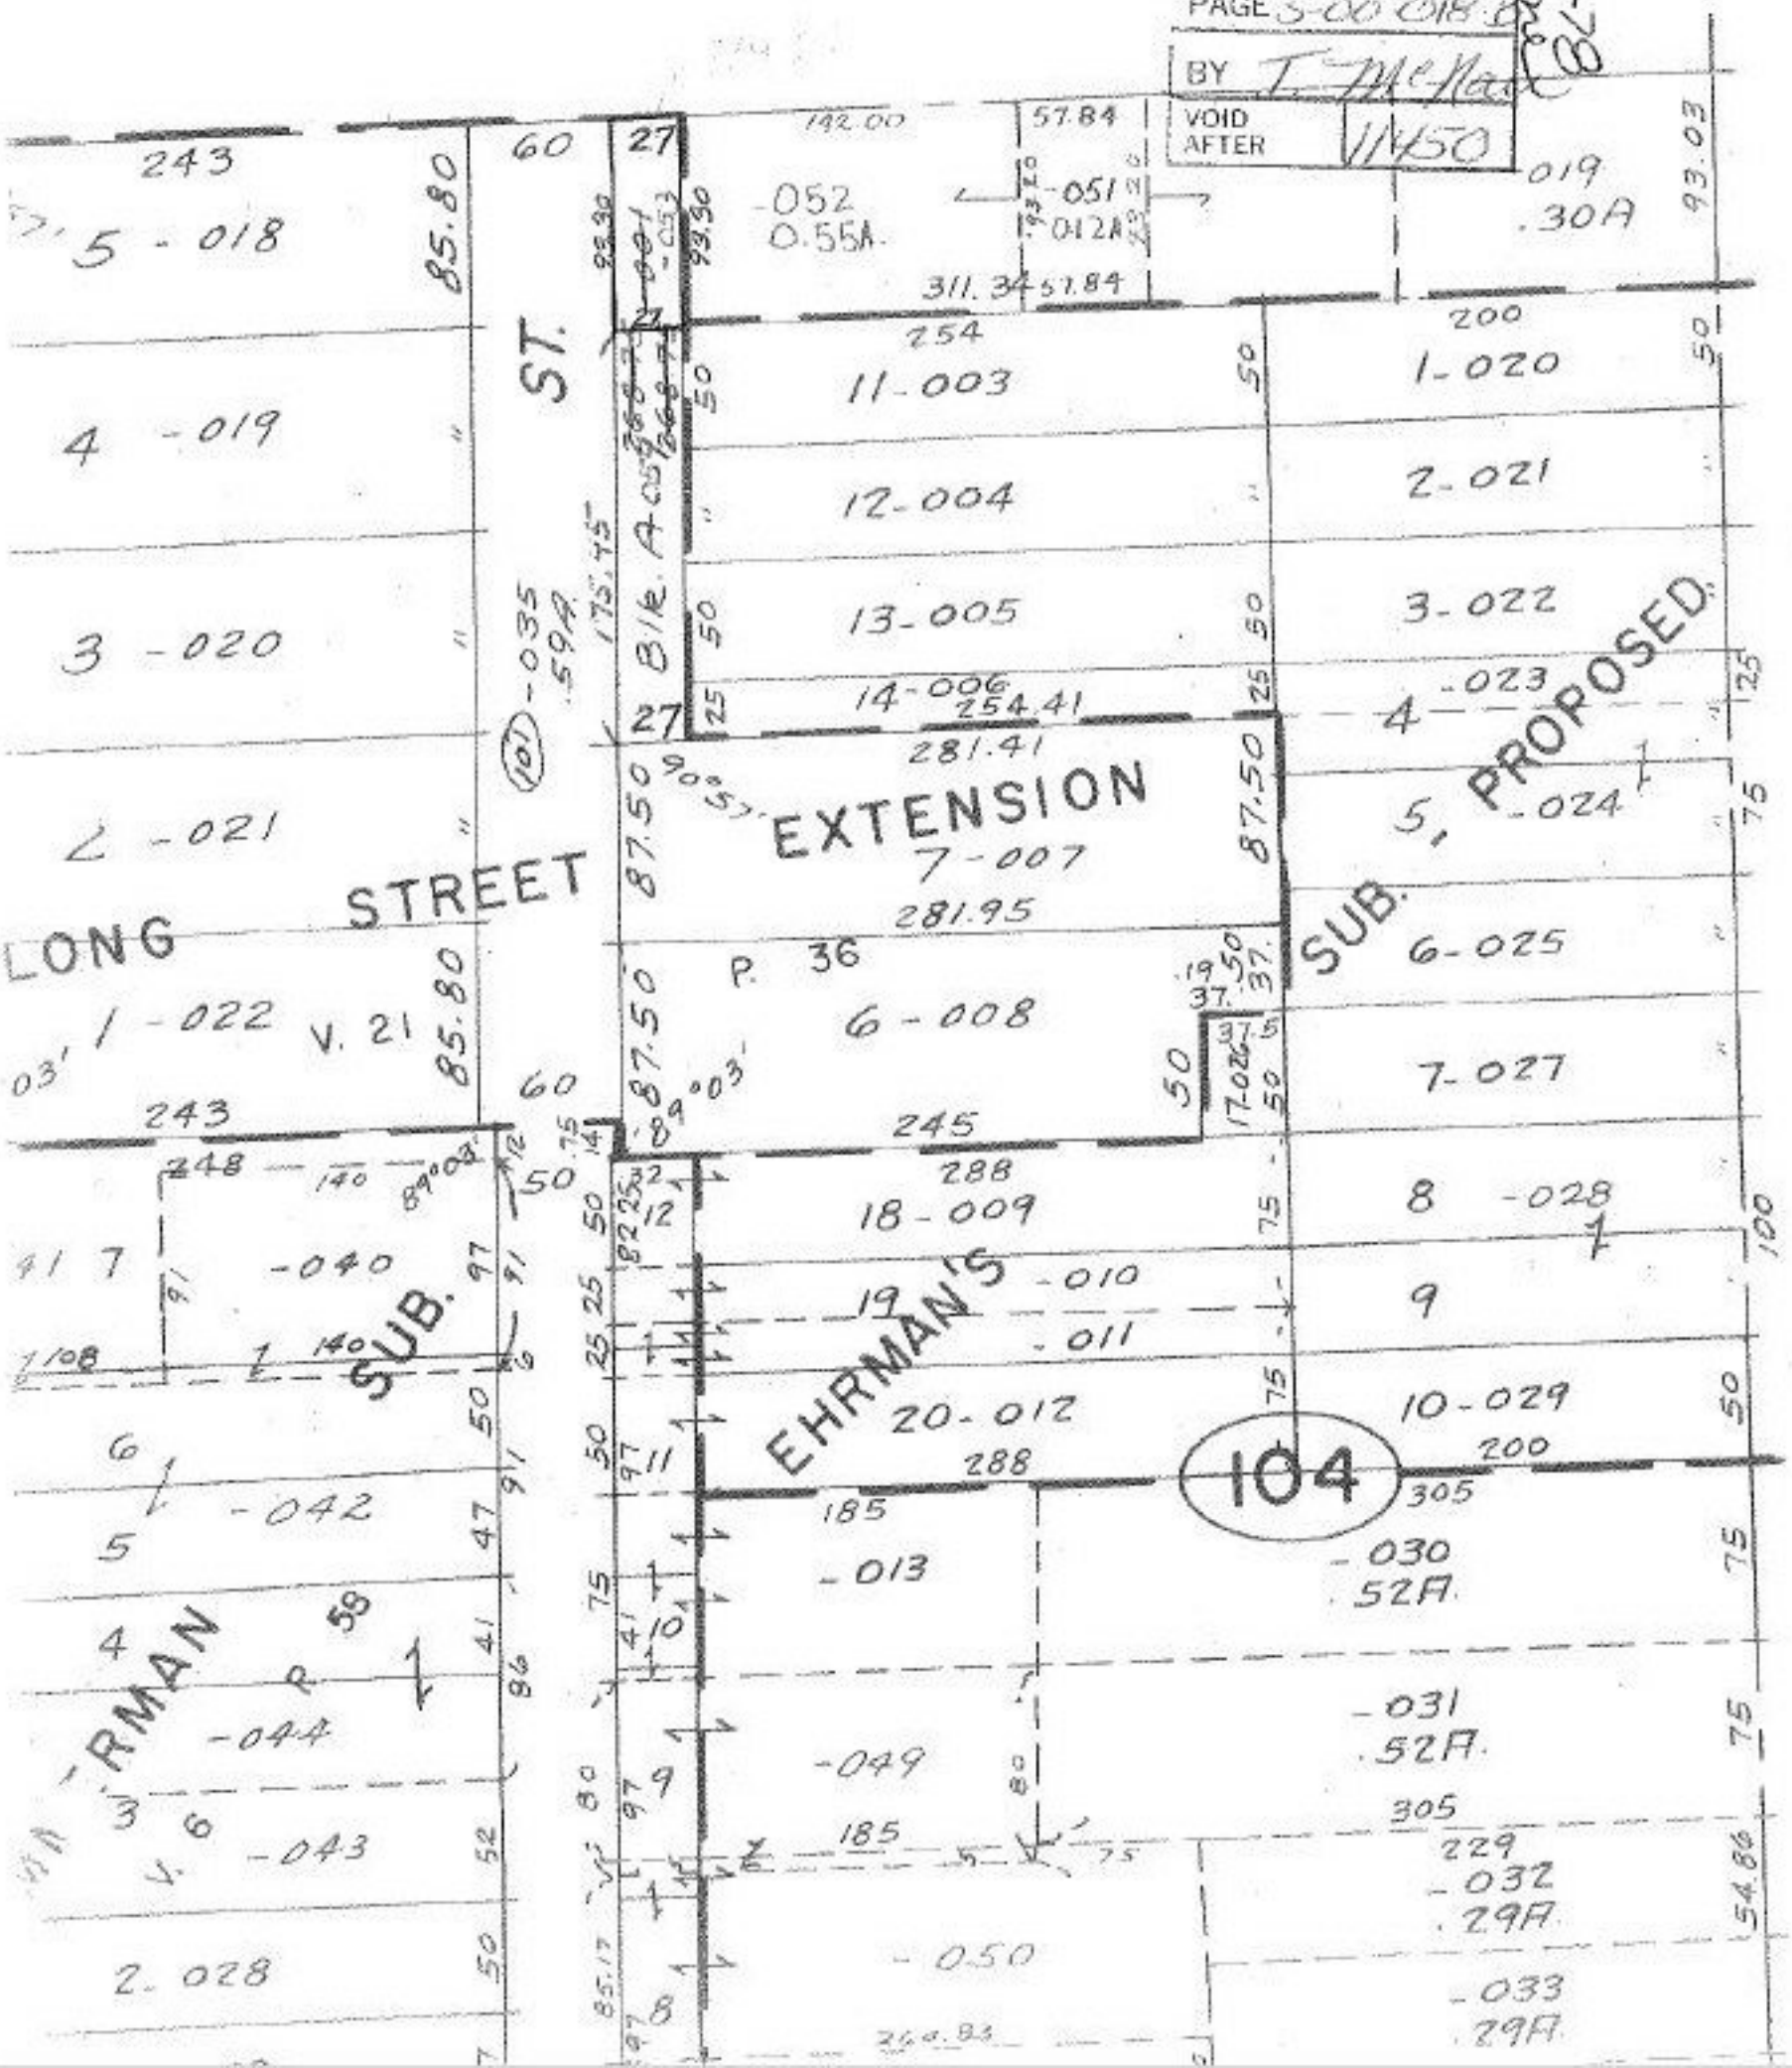
Check 4-7-78