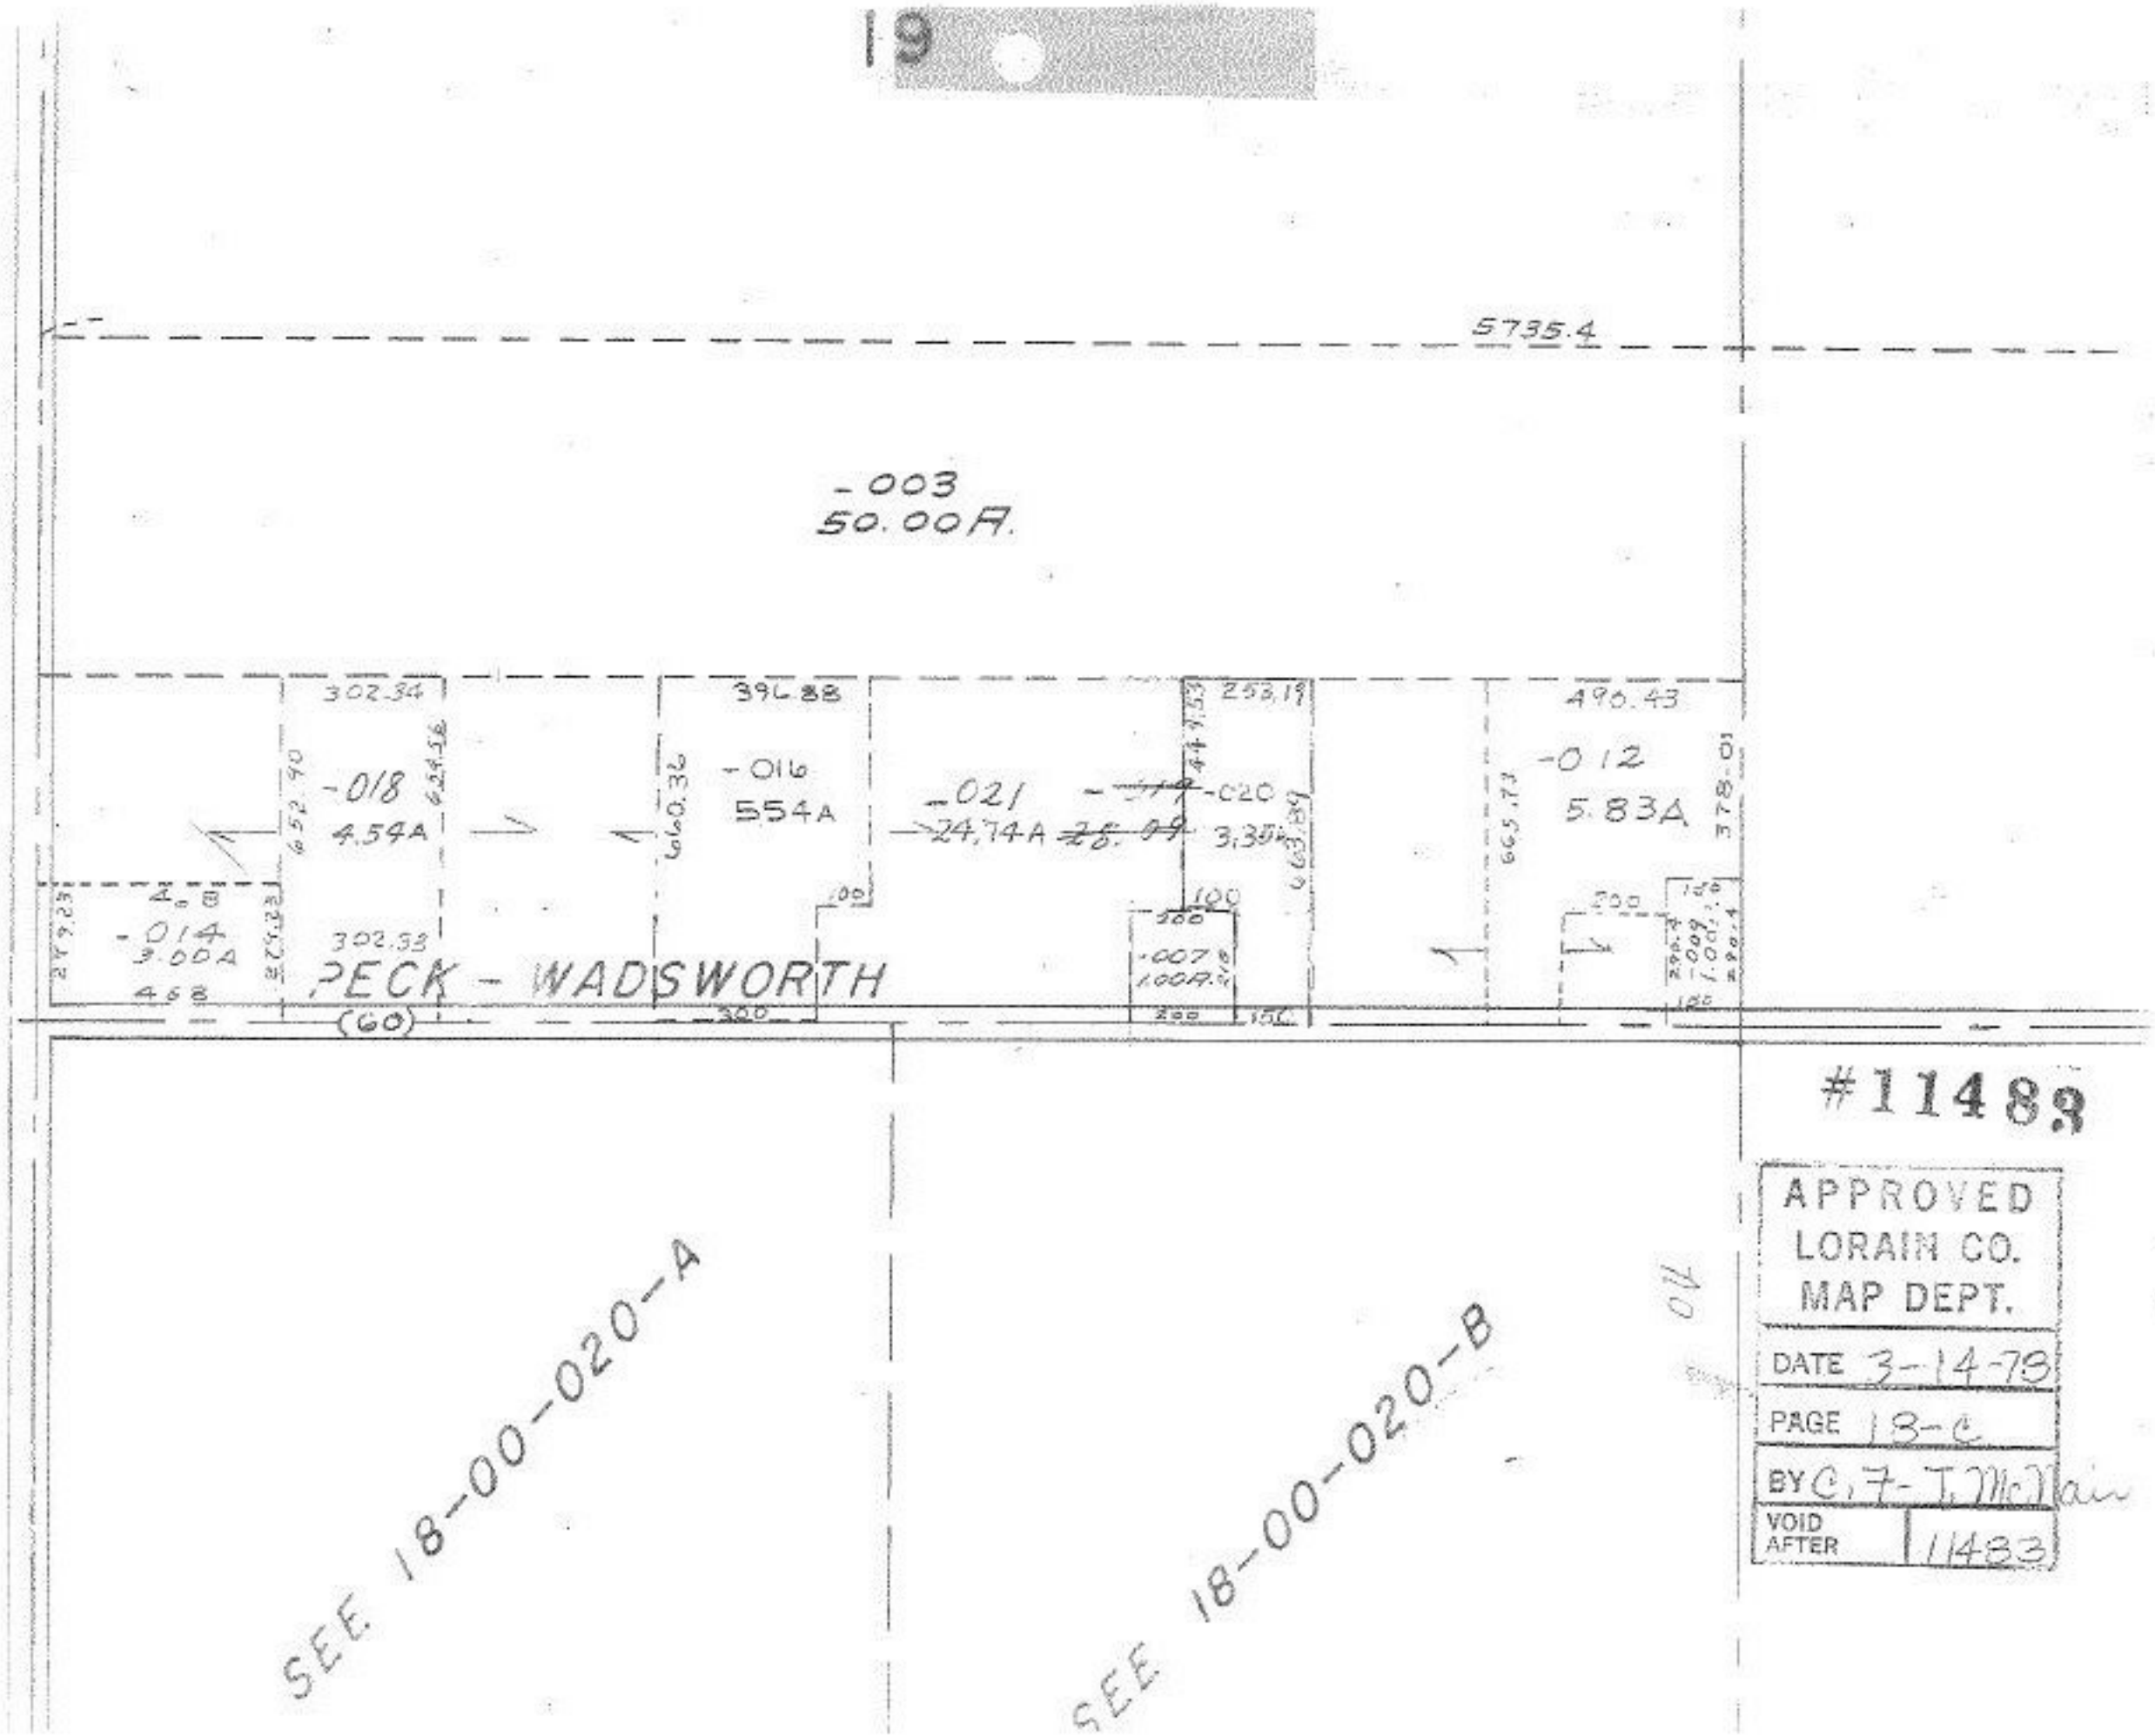
19
5735.4
-003
50.00A.
302.34
396.88
253.19
490.43
-018
4.54A
-016
554A
-021
24.74A
-020
3.35A
-012
5.83A
-014
3.00A
302.33
PECK - WADSWORTH
(60)
SEE 18-00-020-A
SEE 18-00-020-B
#11483
APPROVED
LORAIN CO.
MAP DEPT.
DATE 3-14-78
PAGE 18-C
BY C. F. T. McNair
VOID AFTER 11483