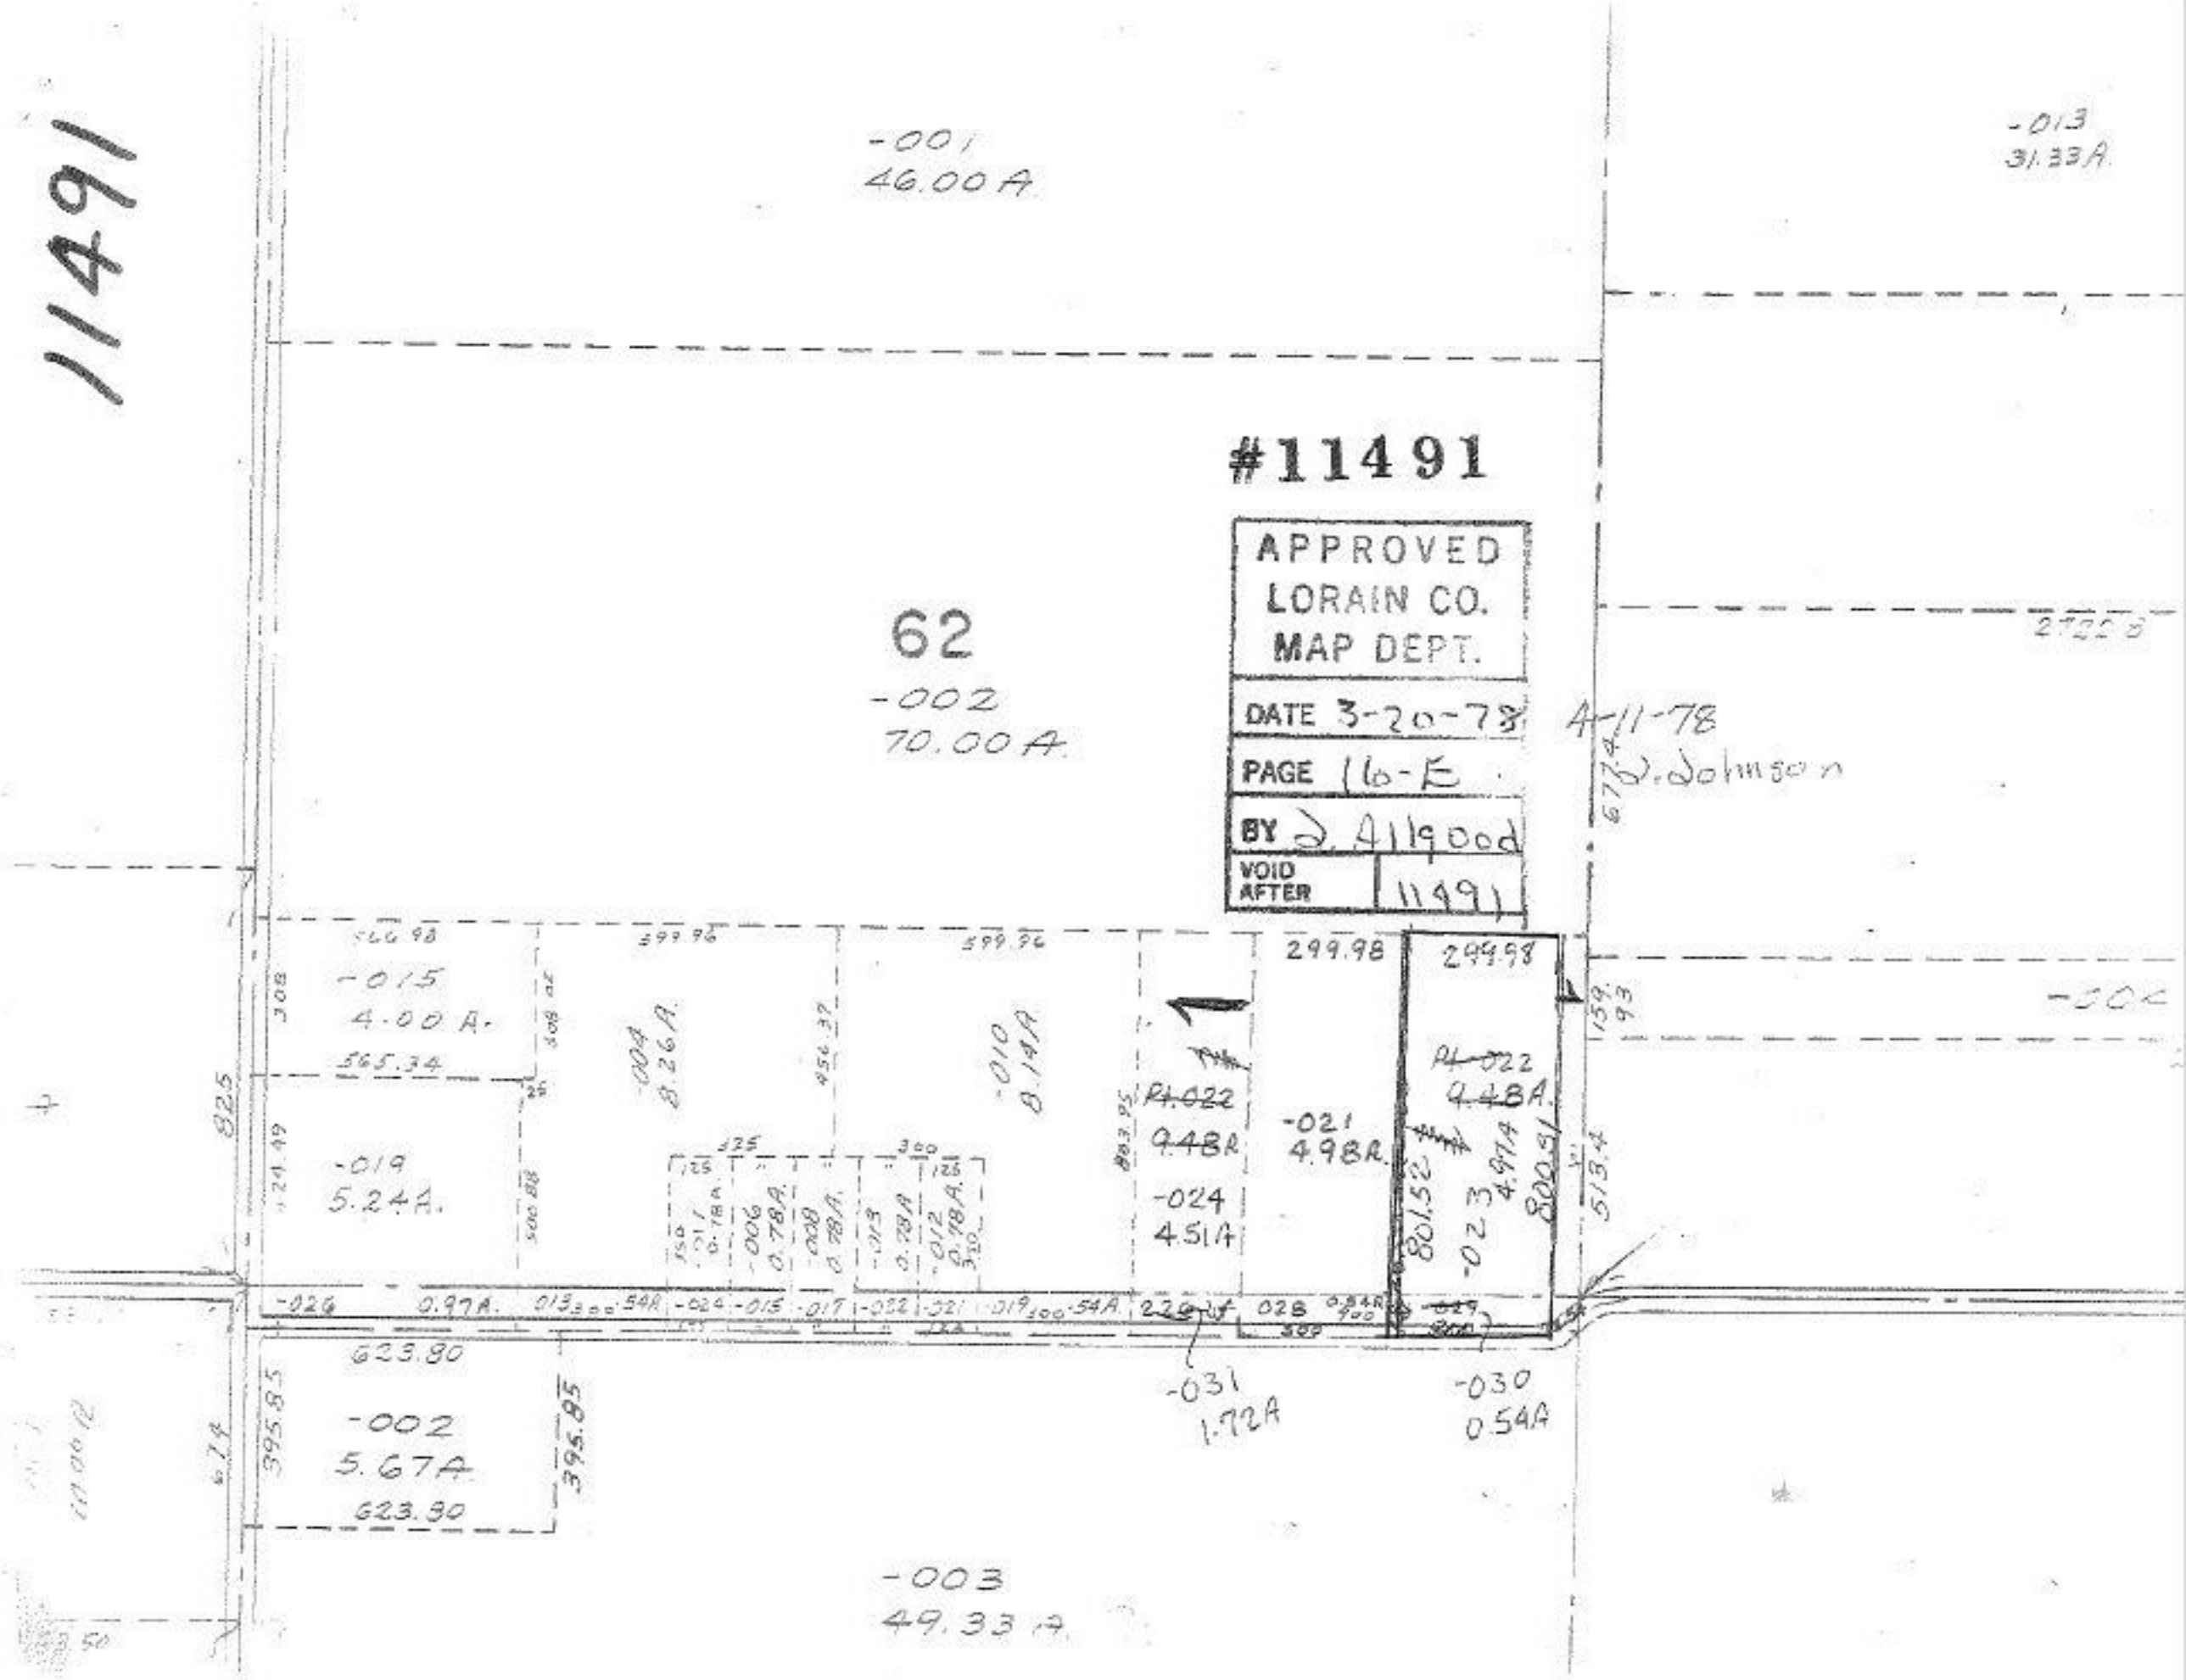
11491
-001
46.00 A
-013
31.33 A
#11491
APPROVED
LORAIN CO.
MAP DEPT.
DATE 3-20-78
PAGE 16-E
BY J. Allgood
VOID AFTER 11491
62
-002
70.00 A
4-11-78
J. Johnson
-015
4.00 A.
565.34
-019
5.24 A.
-004
8.26 A
-010
8.14 A
-024
4.51 A
-021
4.98 A.
-023
4.97 A
-031
1.72 A
-030
0.54 A
-002
5.67 A
623.80
-003
49.33 A