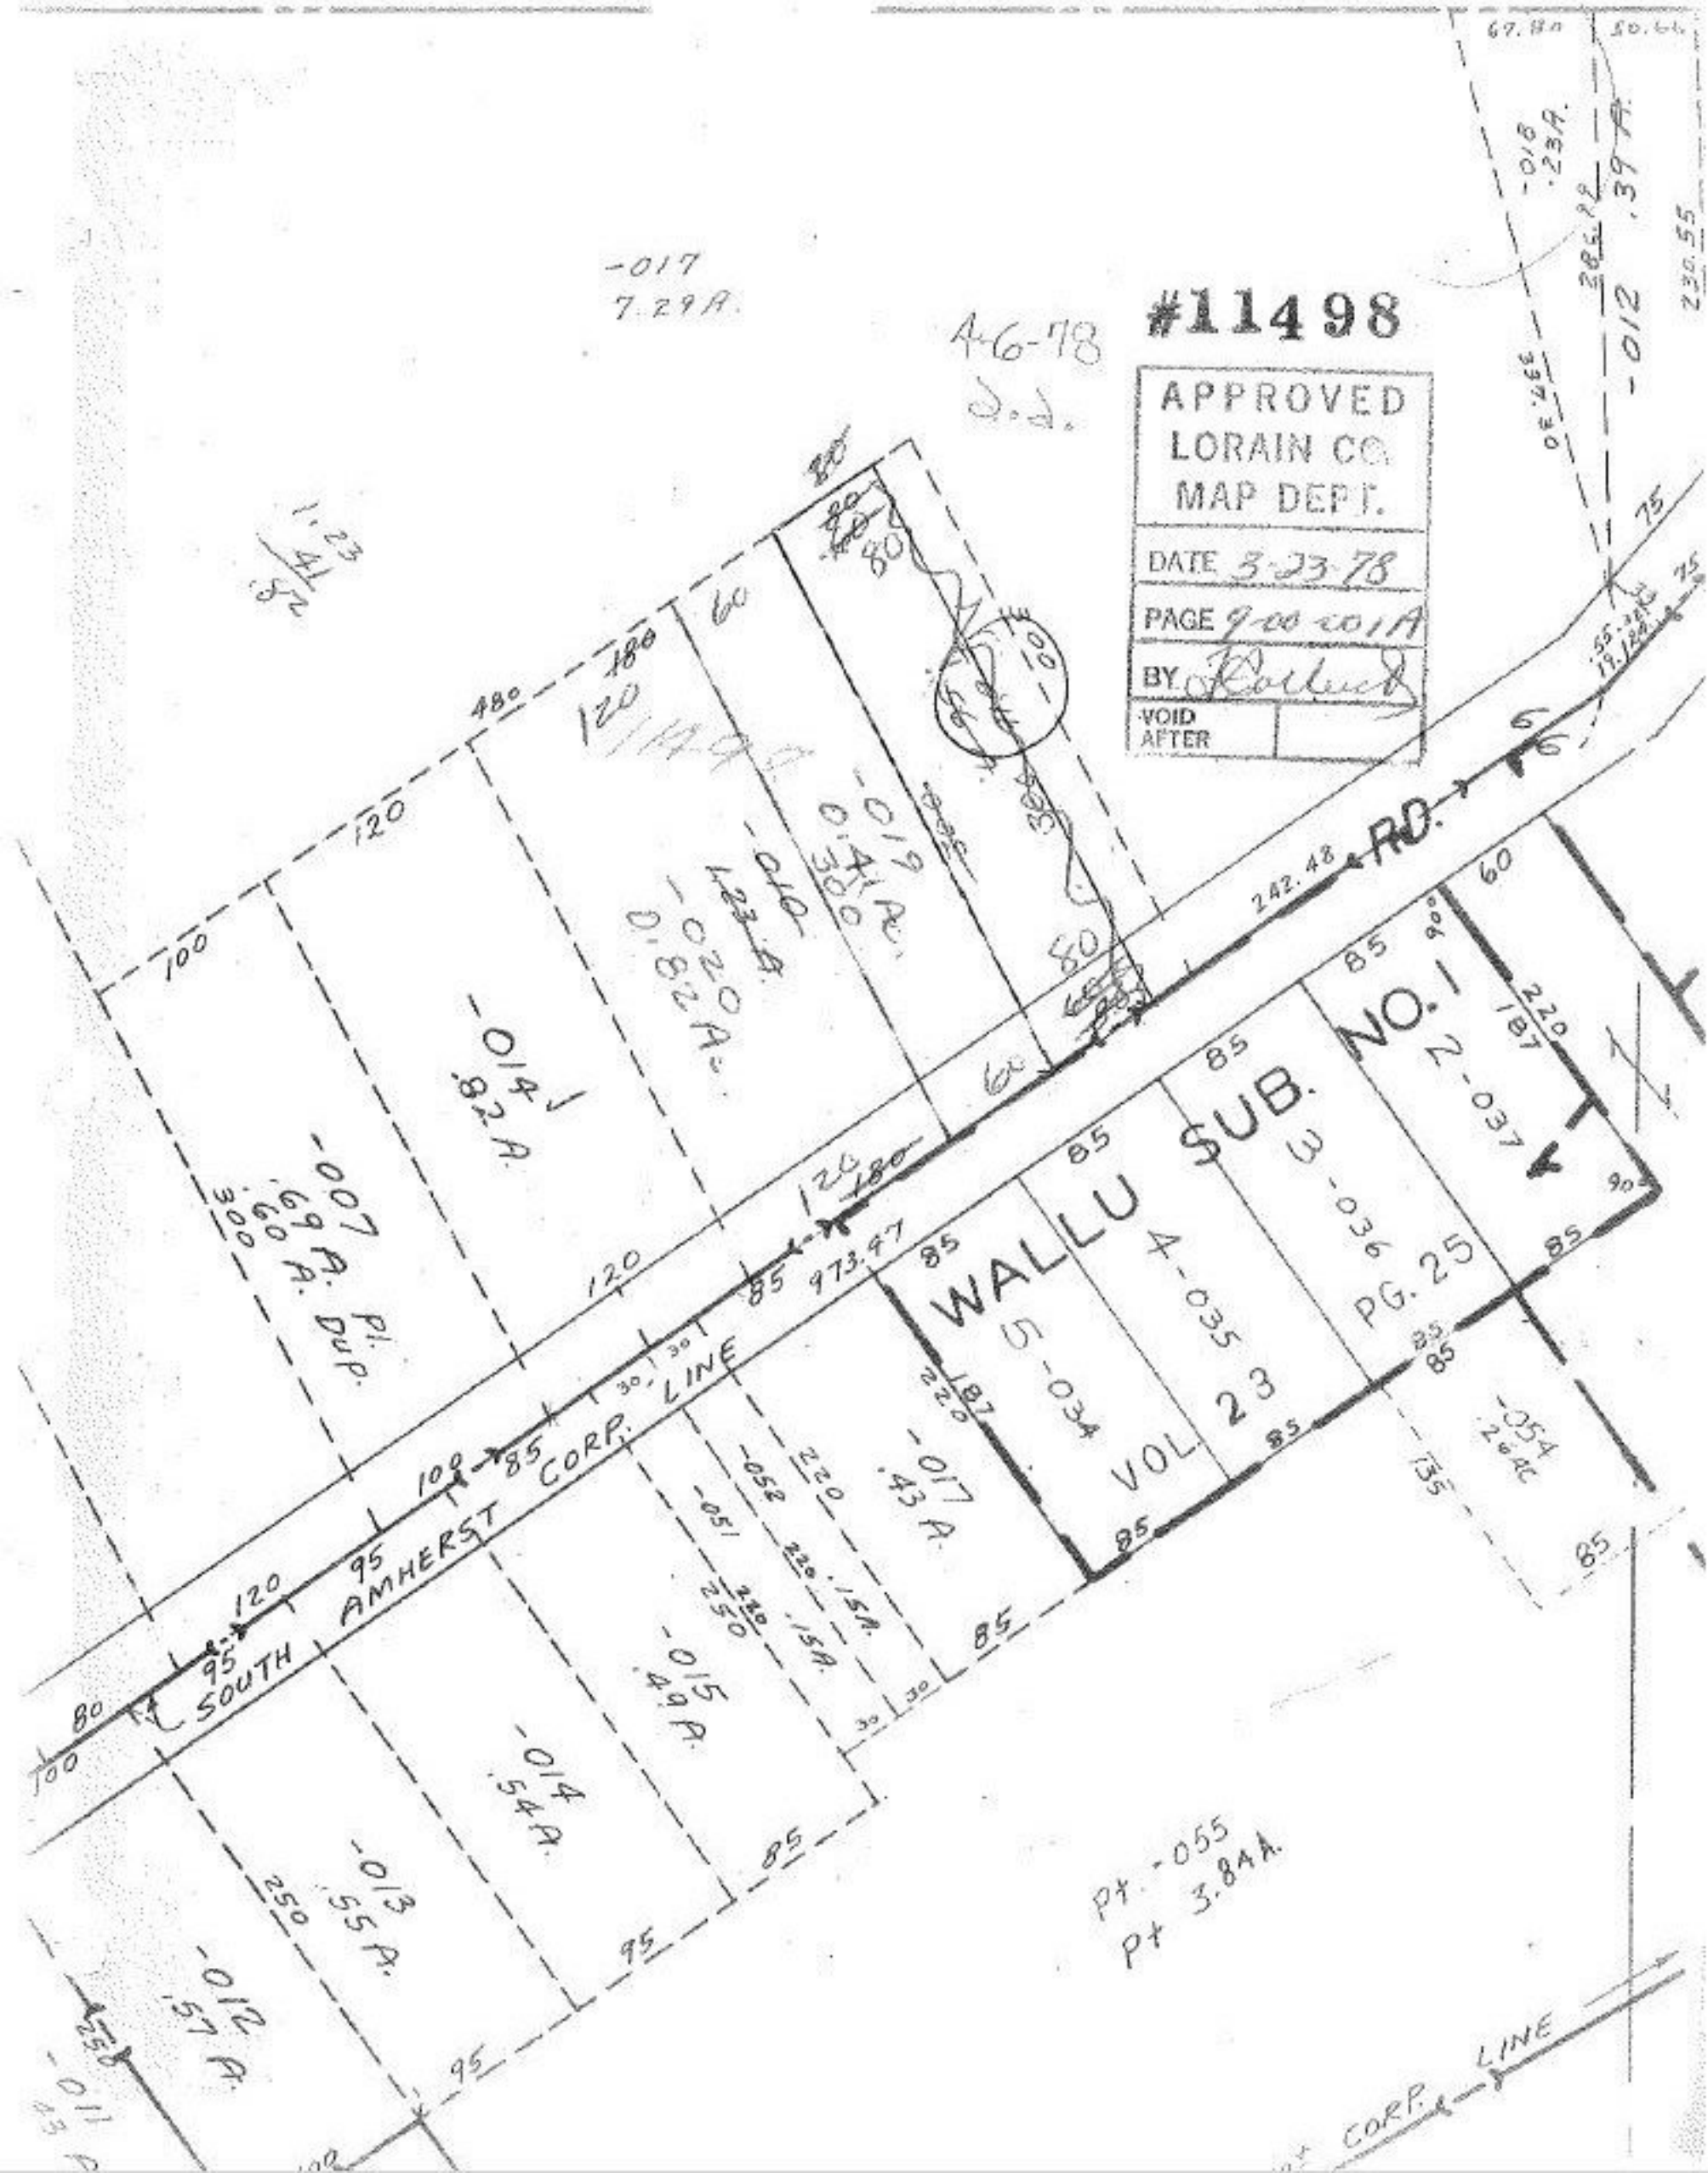

#11498
APPROVED
LORAIN CO.
MAP DEPT.
DATE 3-23-78
PAGE 9-00-001A
BY
VOID AFTER
4-6-78
-017
7.29A.
-019
0.41A.
-010
-020
0.82A.
-014
.82A.
-007
.69A.
.60A.
Pl. DUP.
-012
.39A.
-018
.23A.
-017
.43A.
-015
.49A.
-014
.54A.
-013
.55A.
-012
.57A.
-011
.43A.
-054
.26A.
WALLU SUB. NO. 1
VOL. 23
PG. 25
5-034
4-035
3-036
2-037
SOUTH AMHERST CORP. LINE
RD.
973.47
242.48
Pt. -055
Pt 3.84A.
CORP. LINE