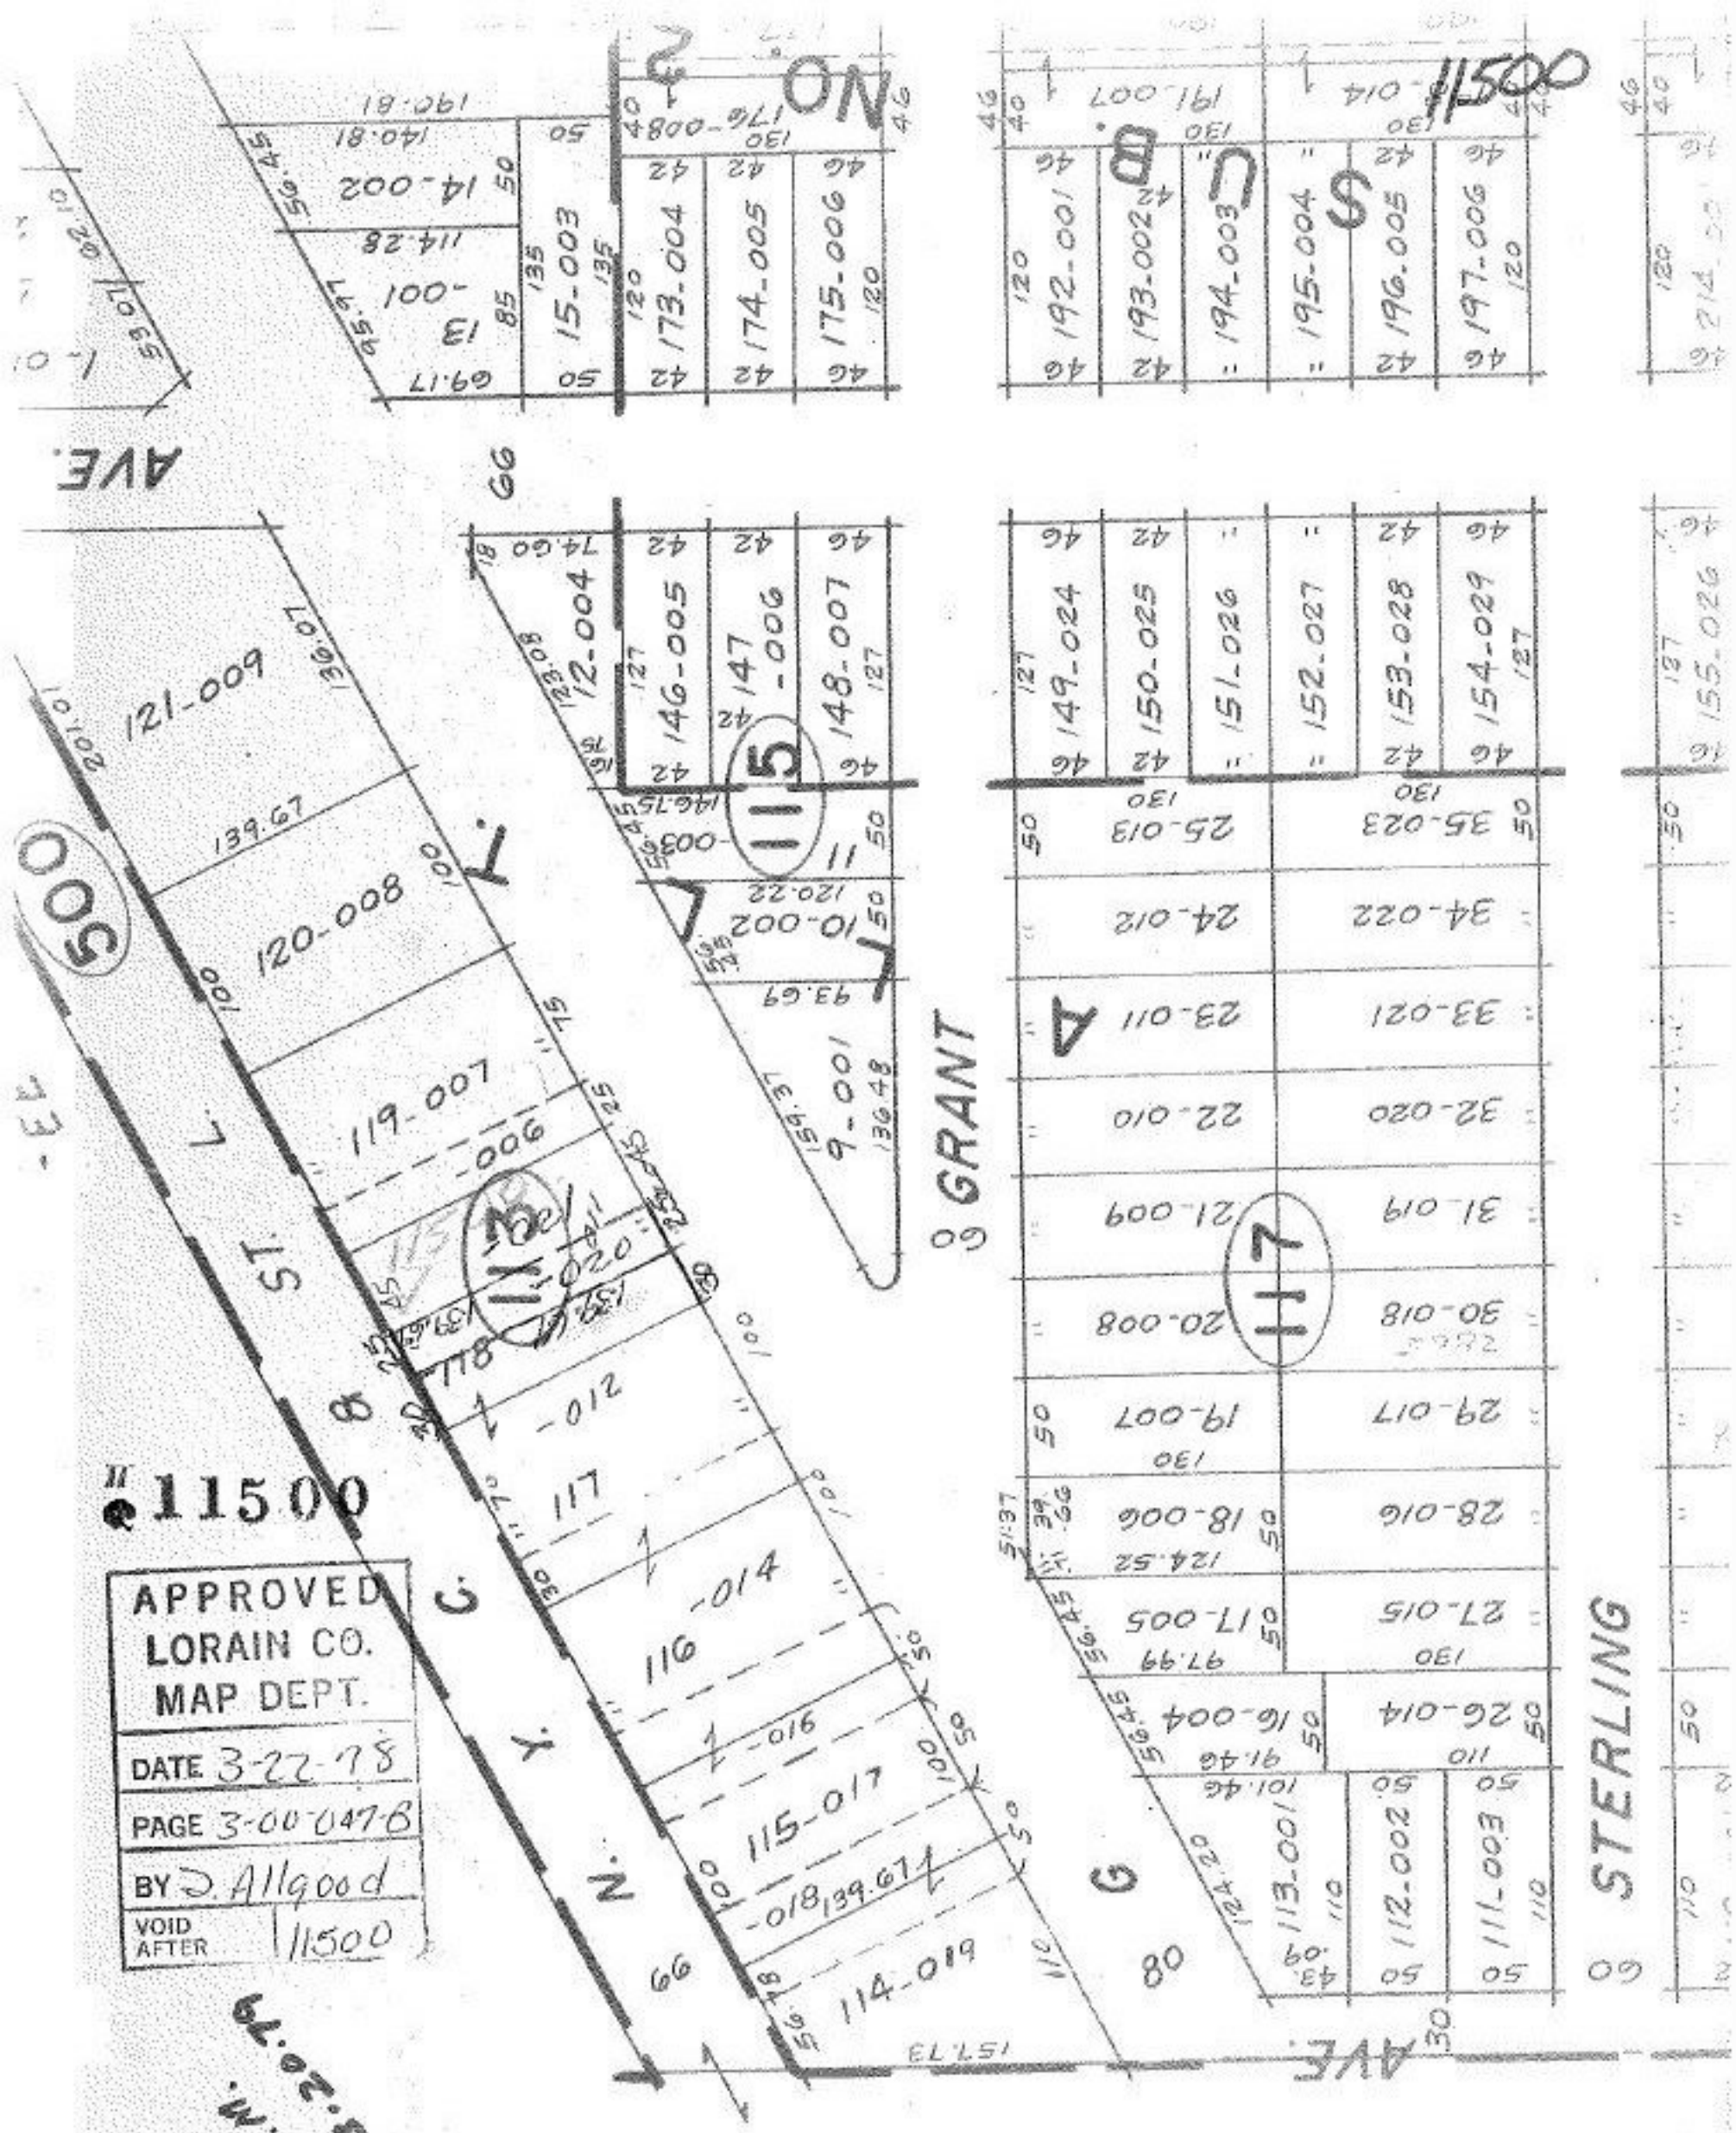

11500
APPROVED
LORAIN CO.
MAP DEPT.
DATE 3-22-78
PAGE 3-00-047-B
BY D. Allgood
VOID AFTER 11500
T.M. 3.20.79
500
AVE.
GRANT
STERLING
AVE.
N. Y. C. & ST. L.
NO. 2