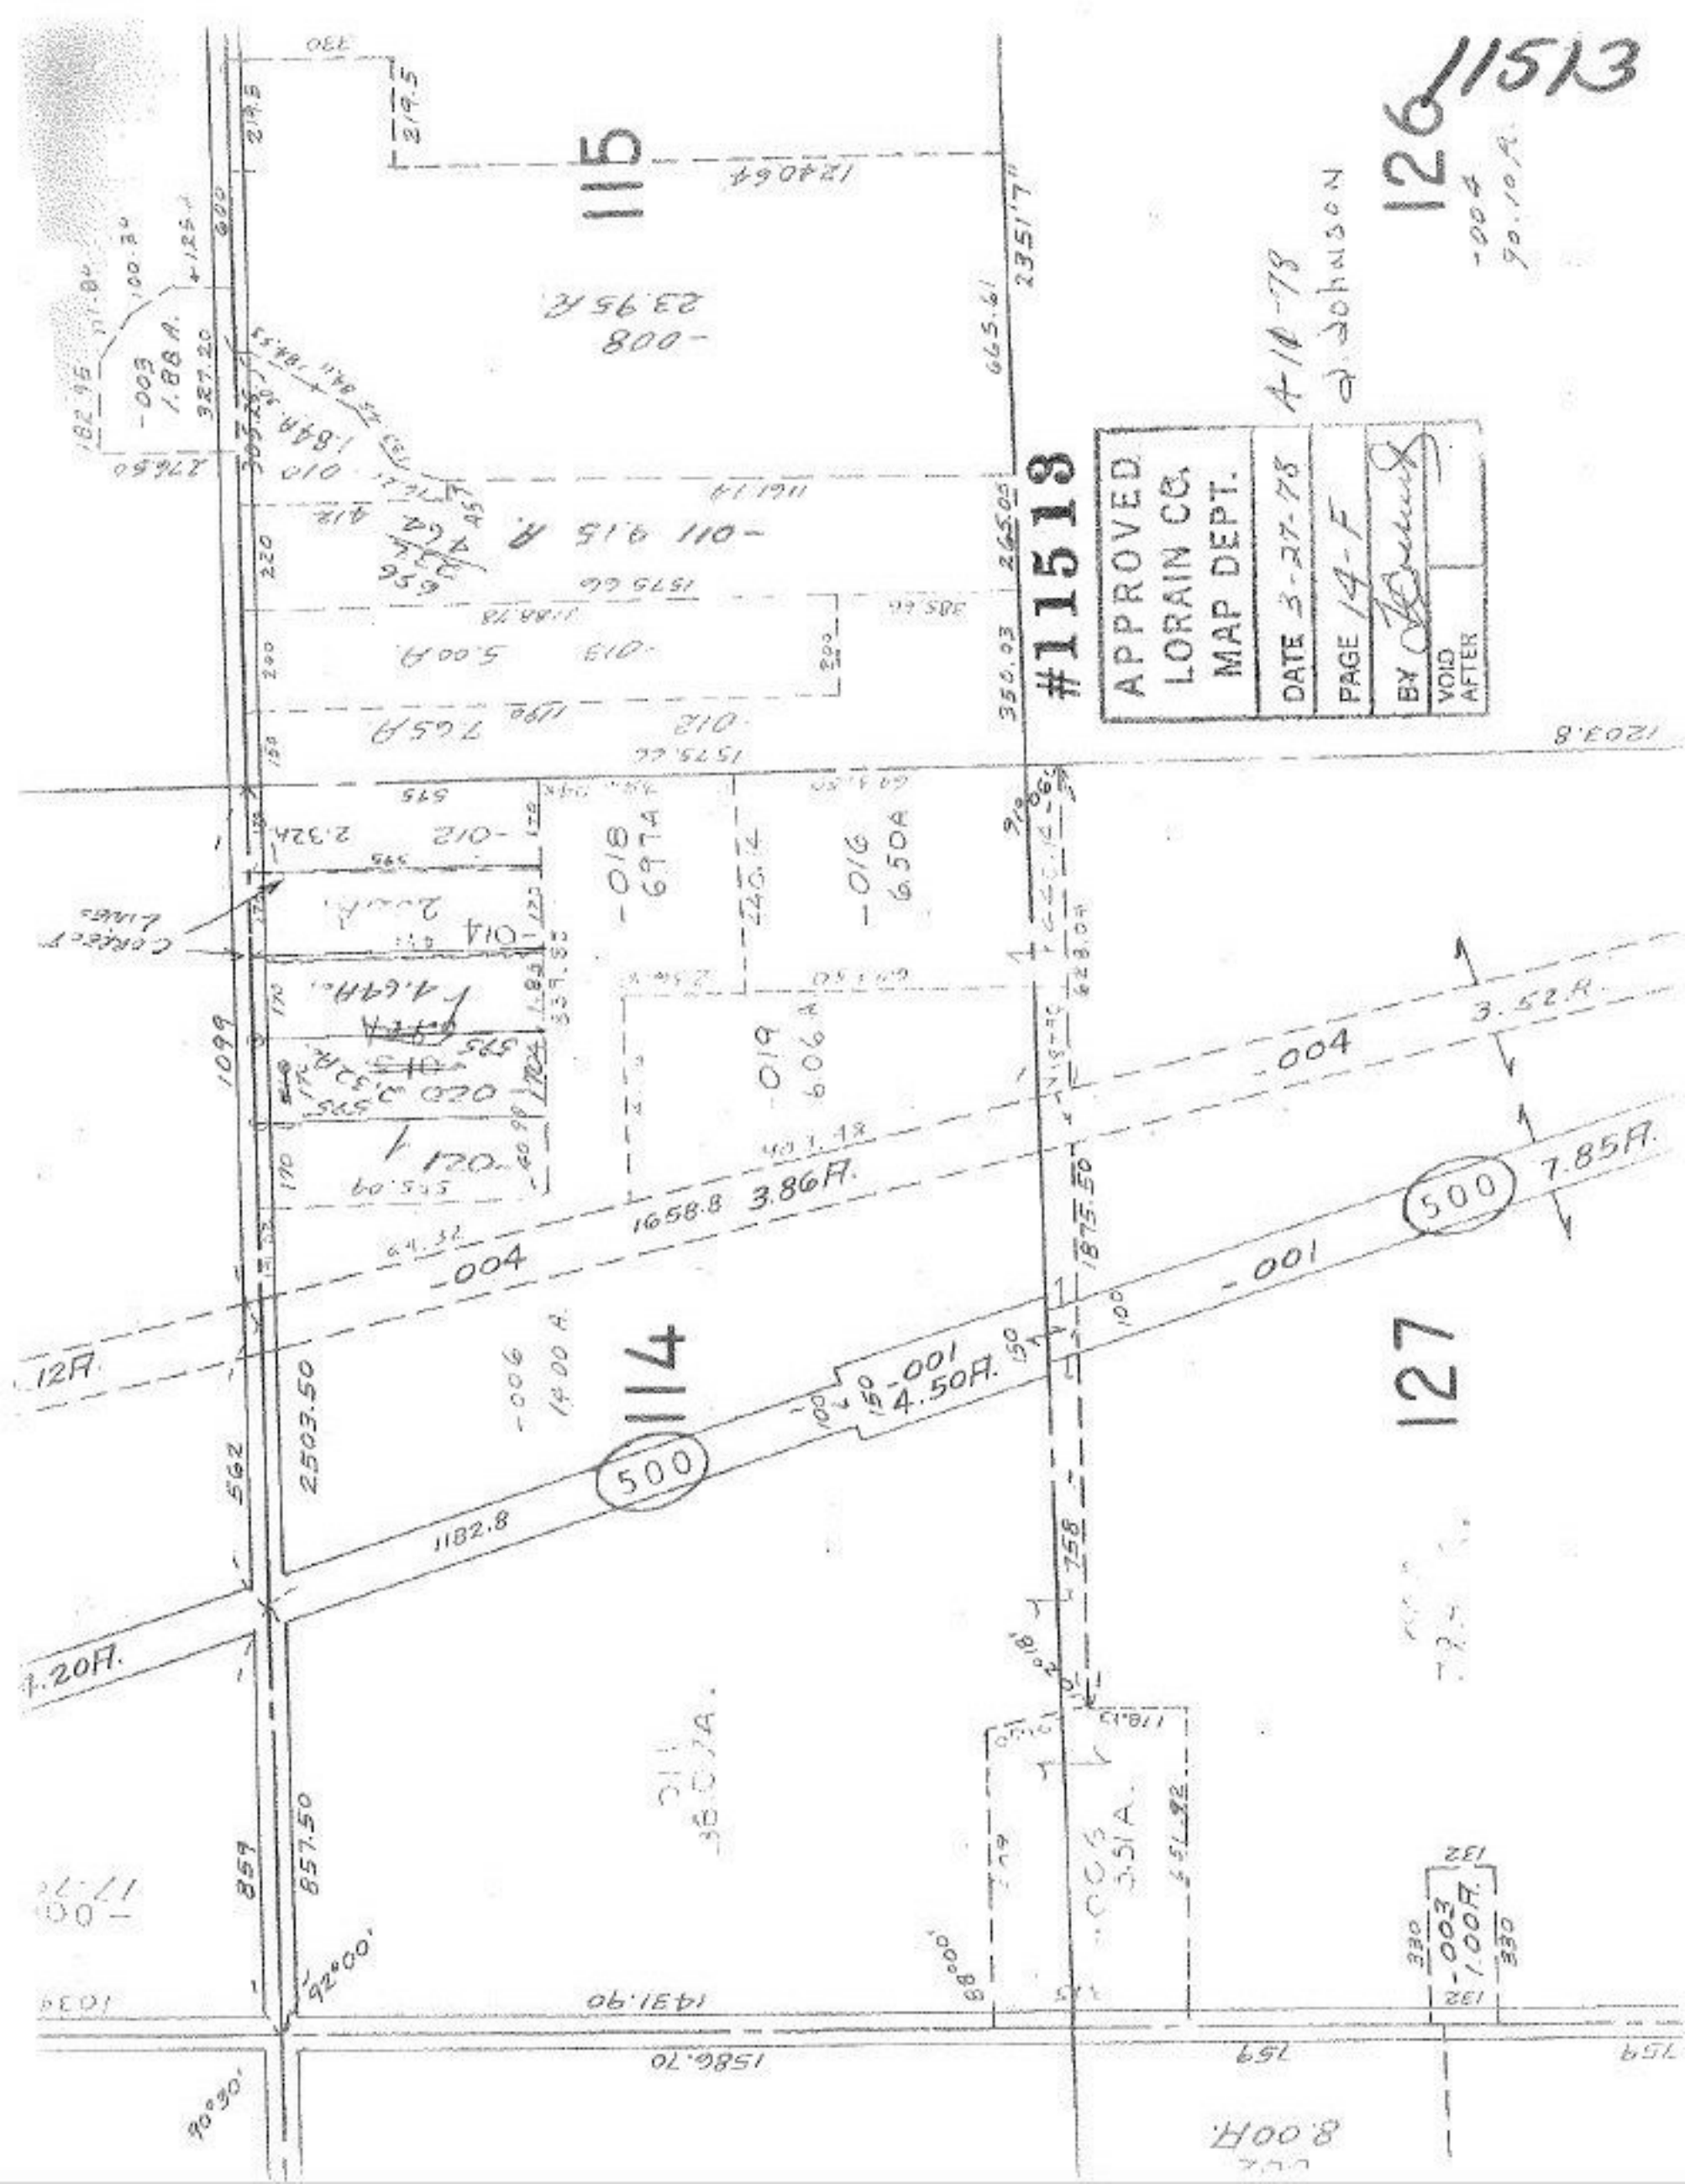

11513
#11513
APPROVED
LORAIN CO.
MAP DEPT.
DATE 3-27-78
PAGE 14-F
BY
VOID AFTER
115
114
126
127
500
-004
-001
-008
23.95 A
-011 9.15 A
-018 6.97 A
-016 6.50 A
-019 6.06 A
-006 14.00 A
-003 1.88 A
-004 90.10 A
3.52 A
7.85 A
3.86 A
4.50 A
1658.8
1182.8
2503.50
857.50
1431.90
1586.70
1203.8
1875.50
2351'7"
1240.64