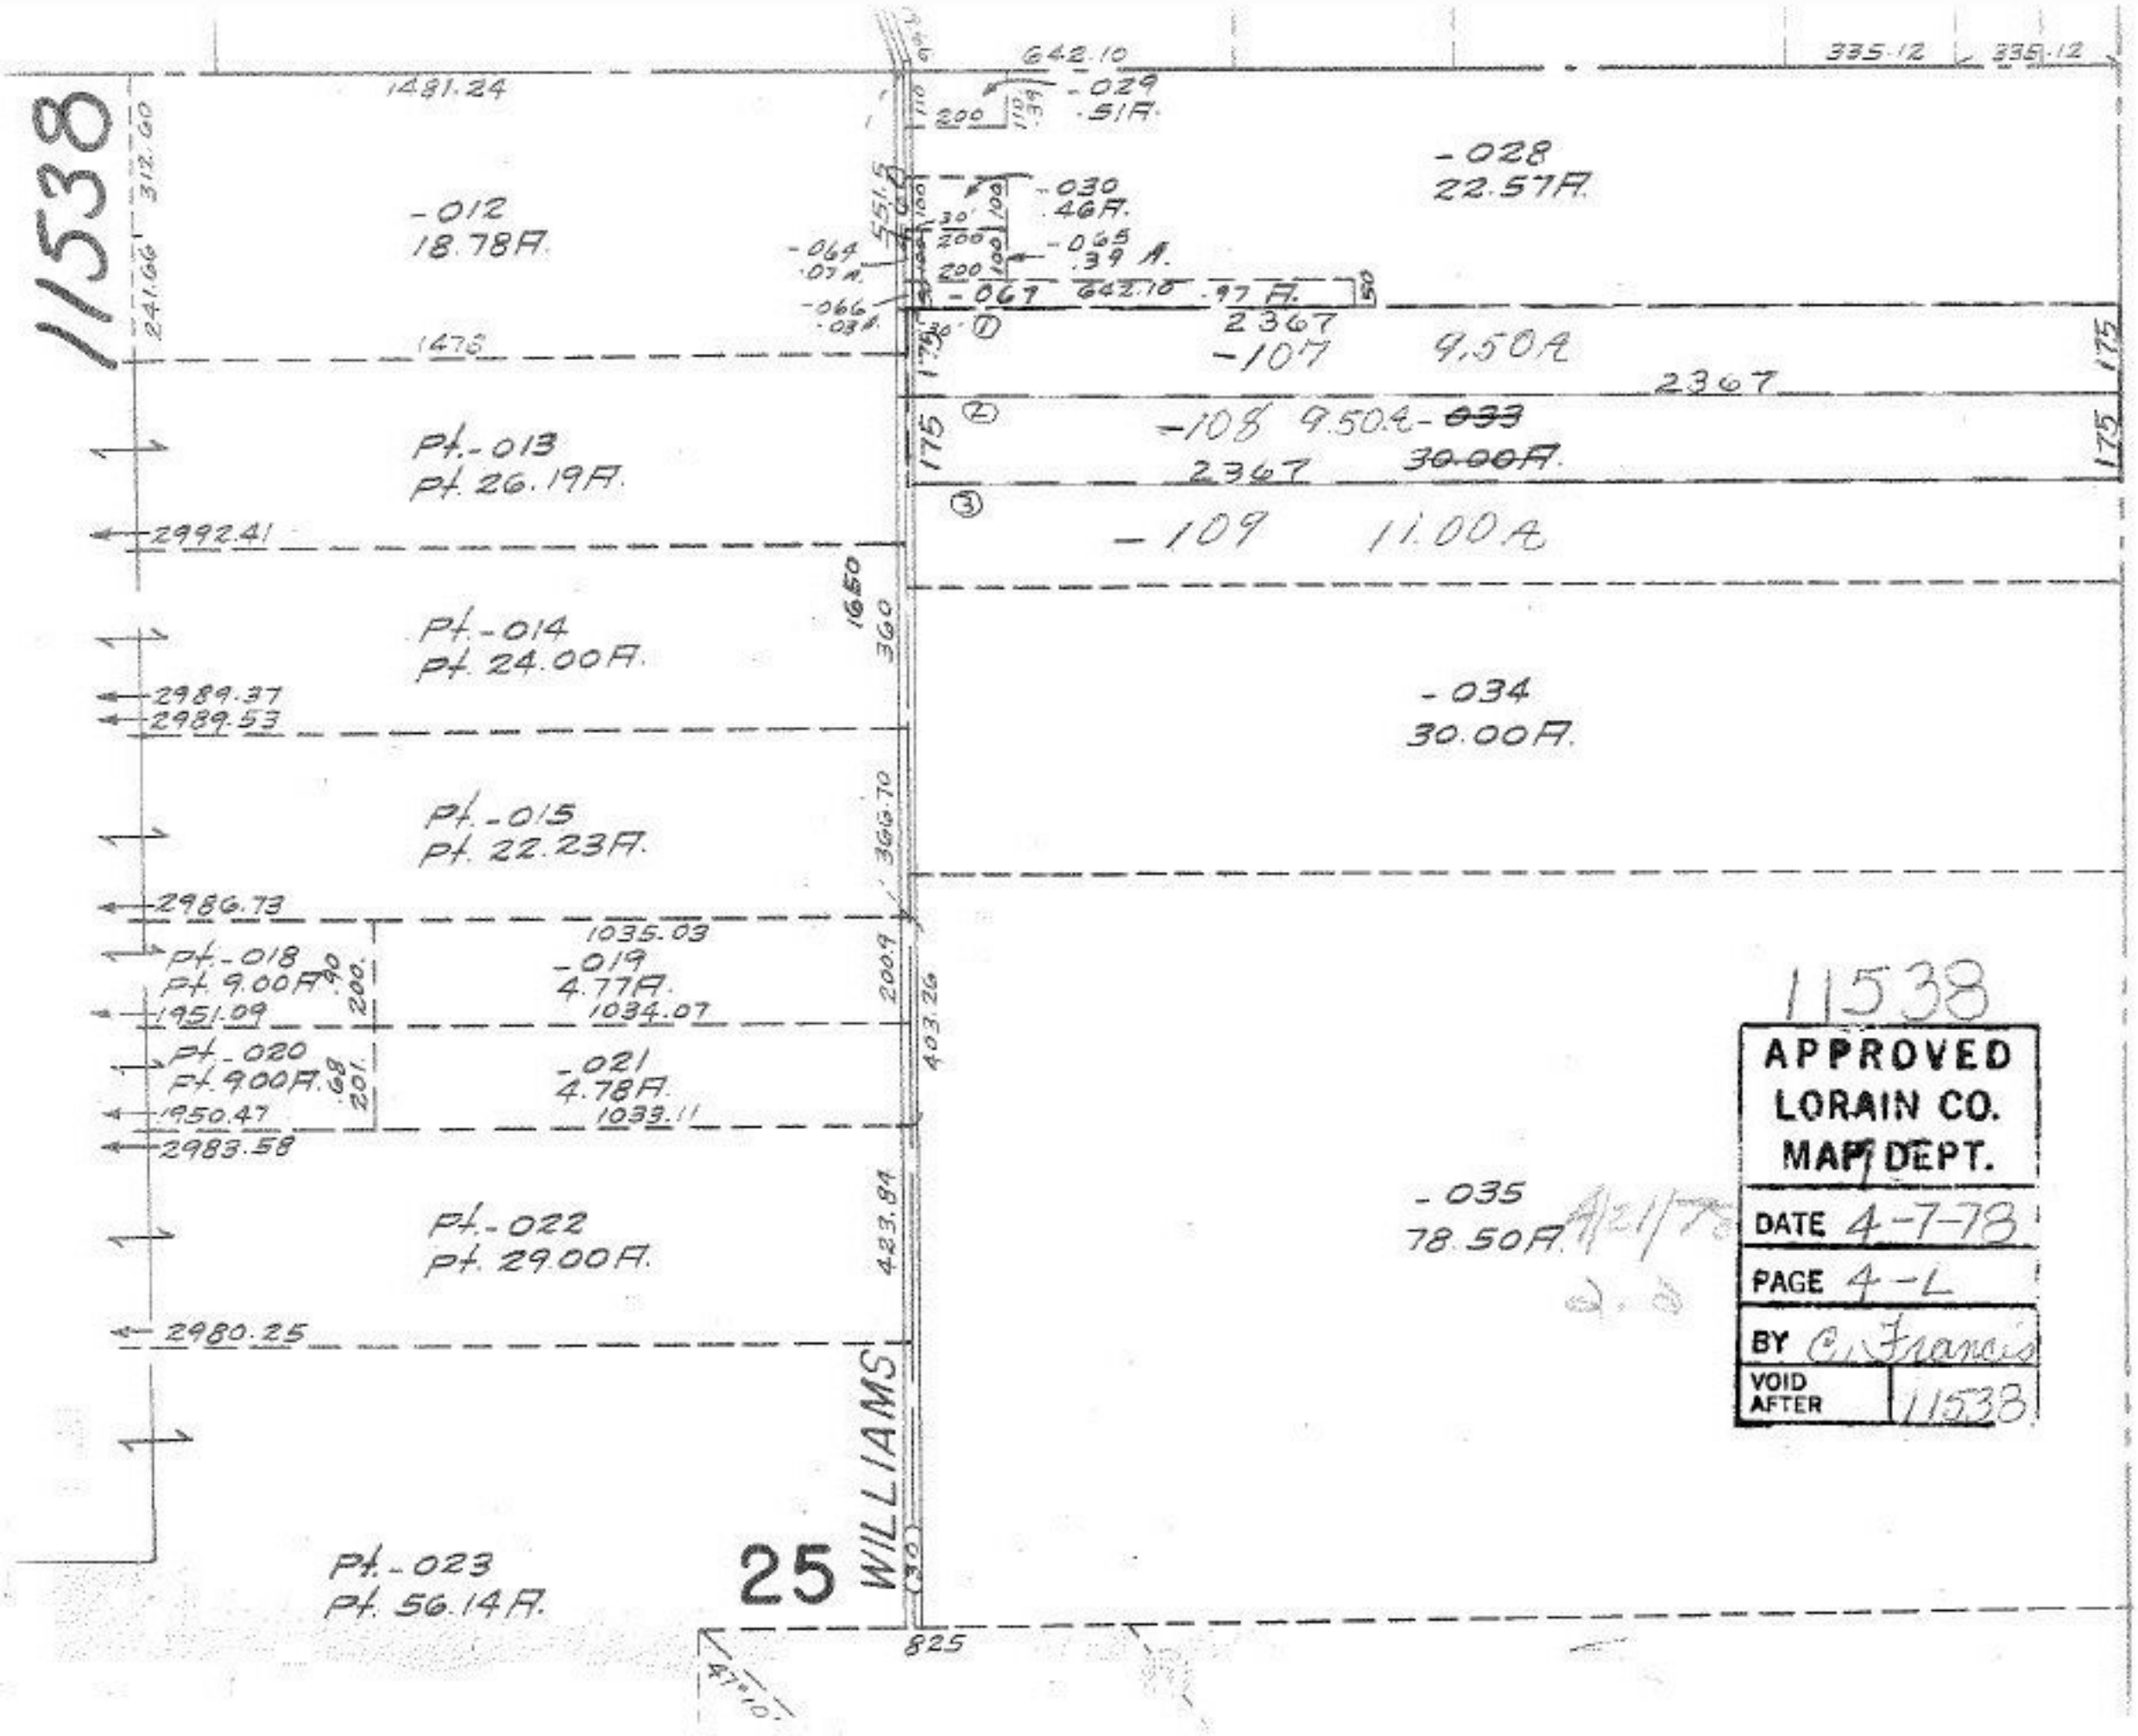
11538
1481.24
642.10
335.12
335.12
-029
.51A.
-028
22.57A.
-012
18.78A.
-030
.46A.
-065
.39 A.
-064
.07 A.
-066
.03 A.
-067
642.10
.97 A.
2367
-107
9.50A
2367
-108
9.50A
-033
30.00A.
2367
-109
11.00A
Pt.-013
Pt. 26.19A.
2992.41
Pt.-014
Pt. 24.00A.
2989.37
2989.53
-034
30.00A.
Pt.-015
Pt. 22.23A.
2986.73
1035.03
-019
4.77A.
1034.07
Pt.-018
Pt. 9.00A.
1951.09
Pt.-020
Pt. 9.00A.
1950.47
-021
4.78A.
1033.11
2983.58
Pt.-022
Pt. 29.00A.
2980.25
-035
78.50A.
WILLIAMS
Pt.-023
Pt. 56.14A.
25
825
11538
APPROVED
LORAIN CO.
MAP DEPT.
DATE 4-7-78
PAGE 4-L
BY C. Francis
VOID AFTER 11538