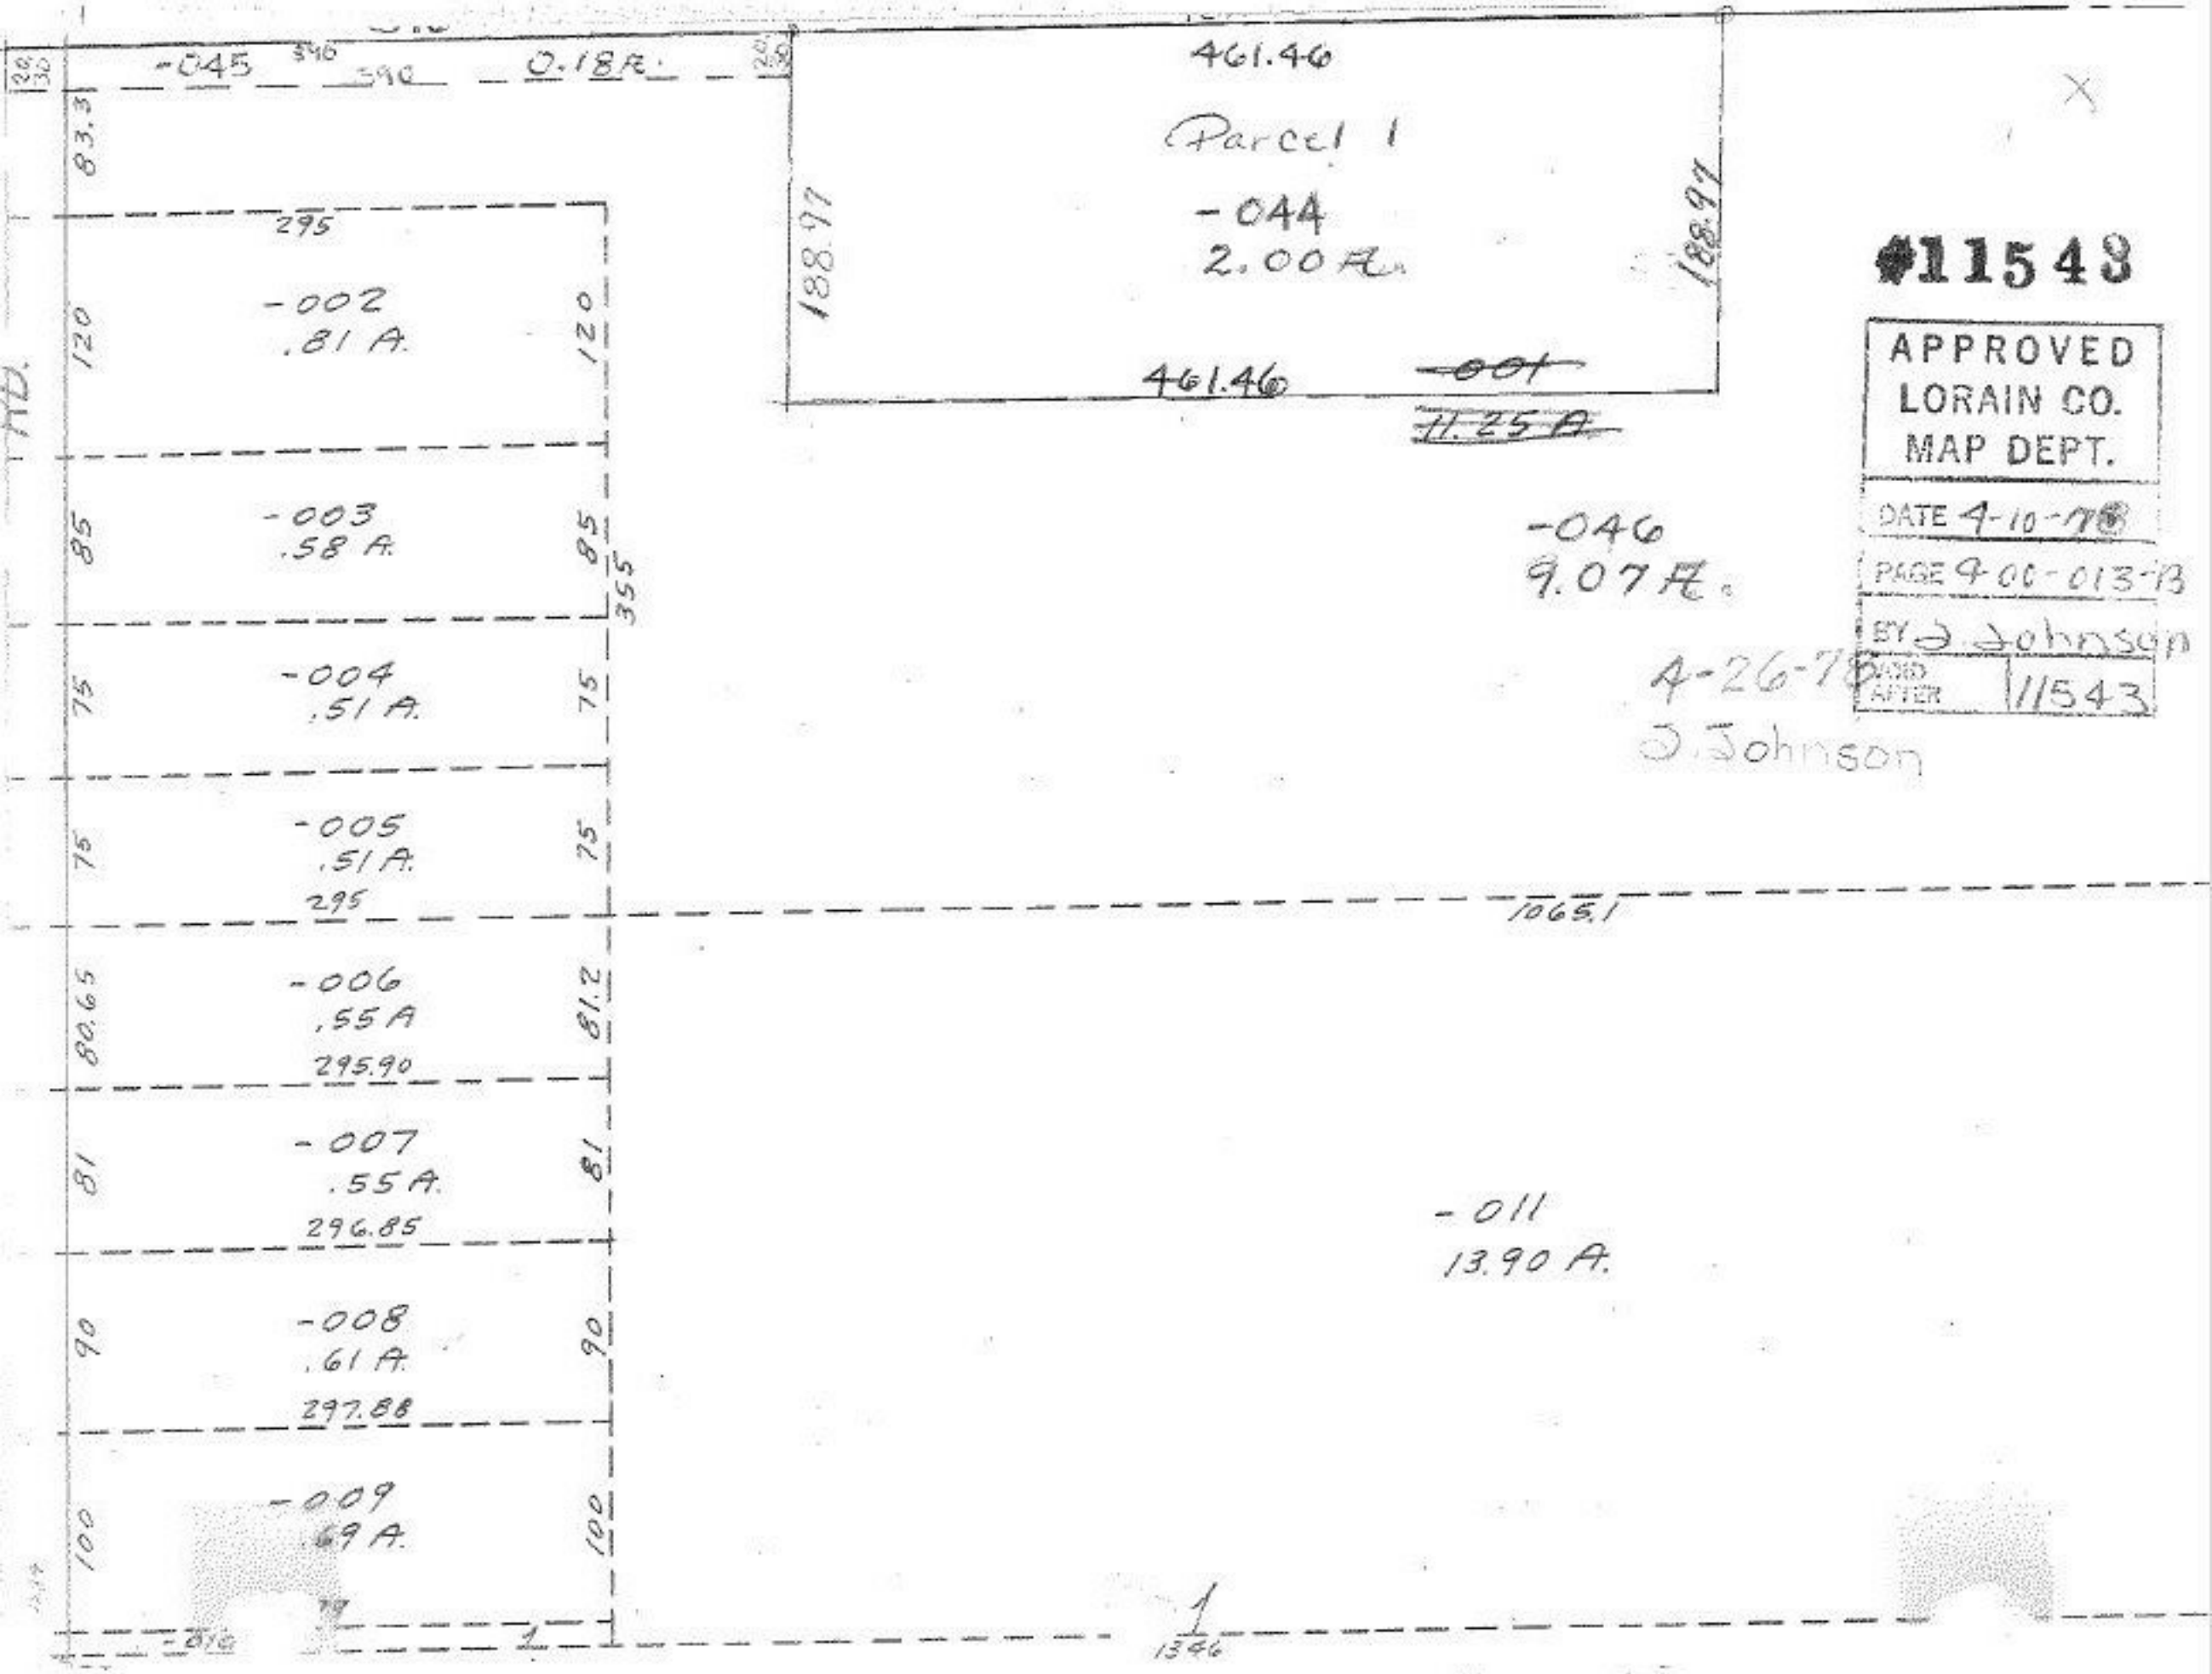

#11543

APPROVED
LORAIN CO.
MAP DEPT.

DATE 4-10-78

PAGE 9-00-013-B

BY J. Johnson

VOID AFTER 11543

4-26-78
J. Johnson