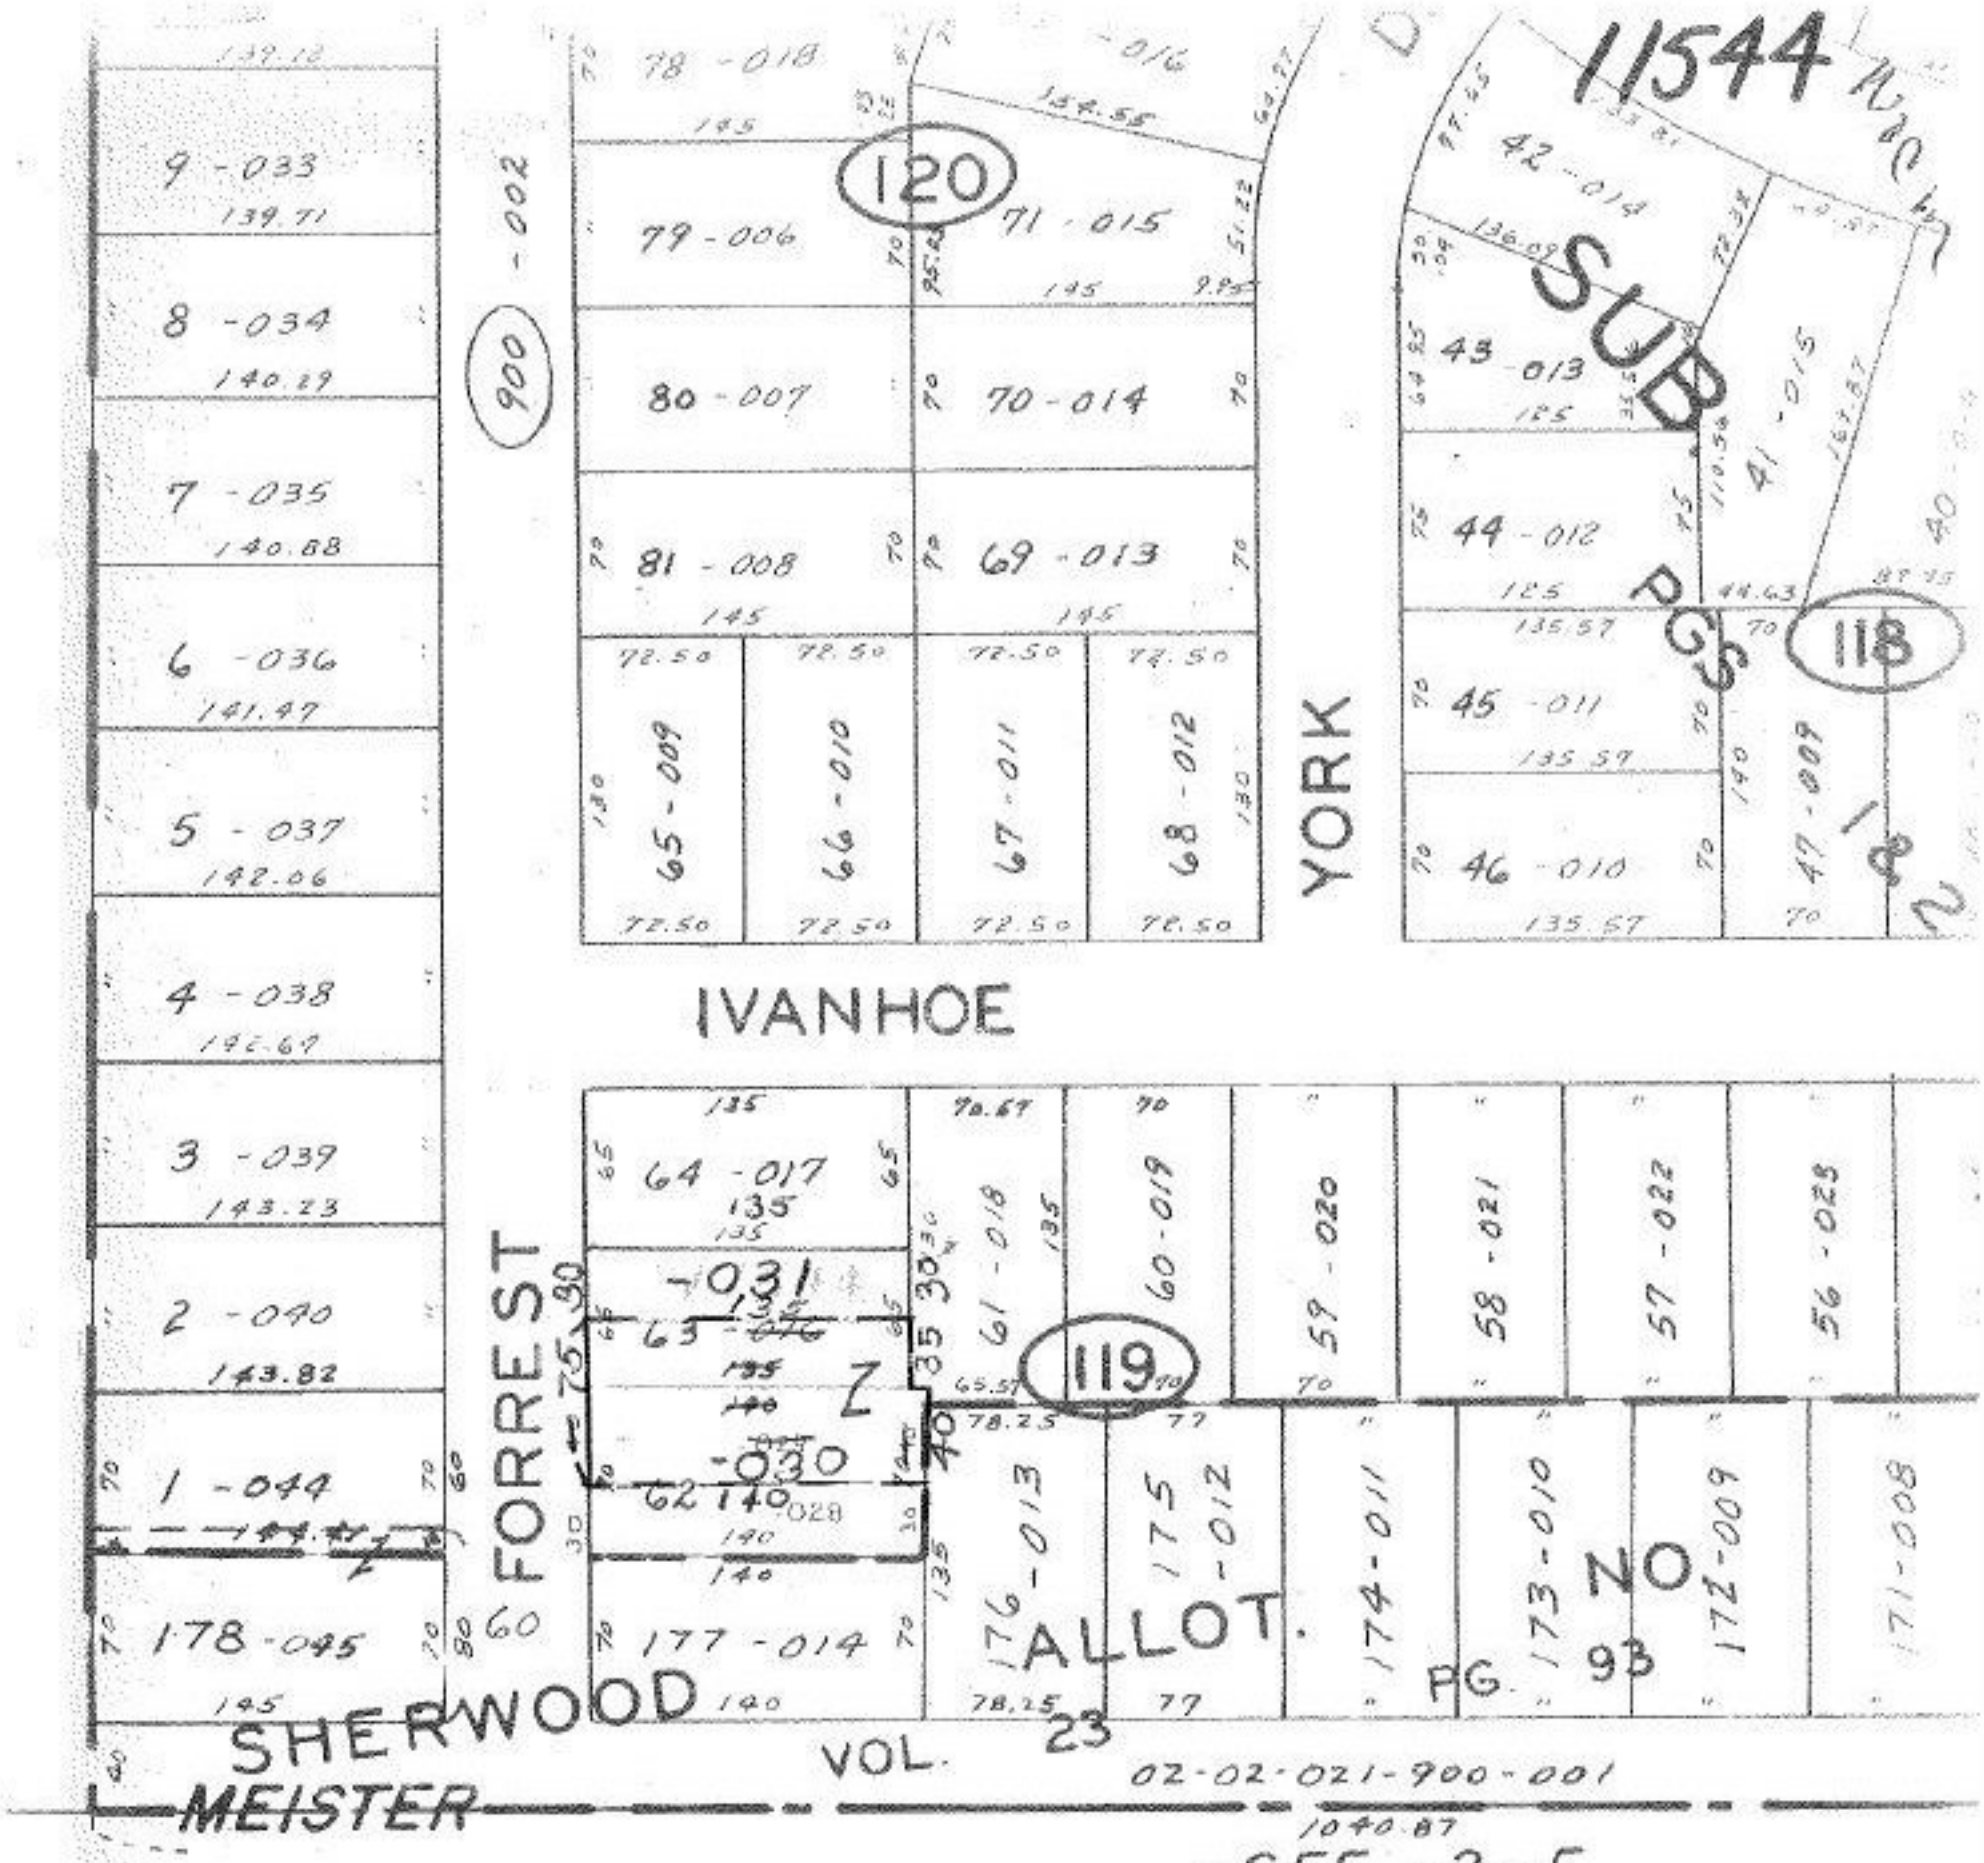

#11544

RIVER TWP.

TRACT
E. PT.

APPROVED
LORAIN CO.
MAP DEPT.
DATE 4-21-78
PAGE 2-02-021-B
BY C.F. F.C.
VOID AFTER 11544

C.F. 5-12-78