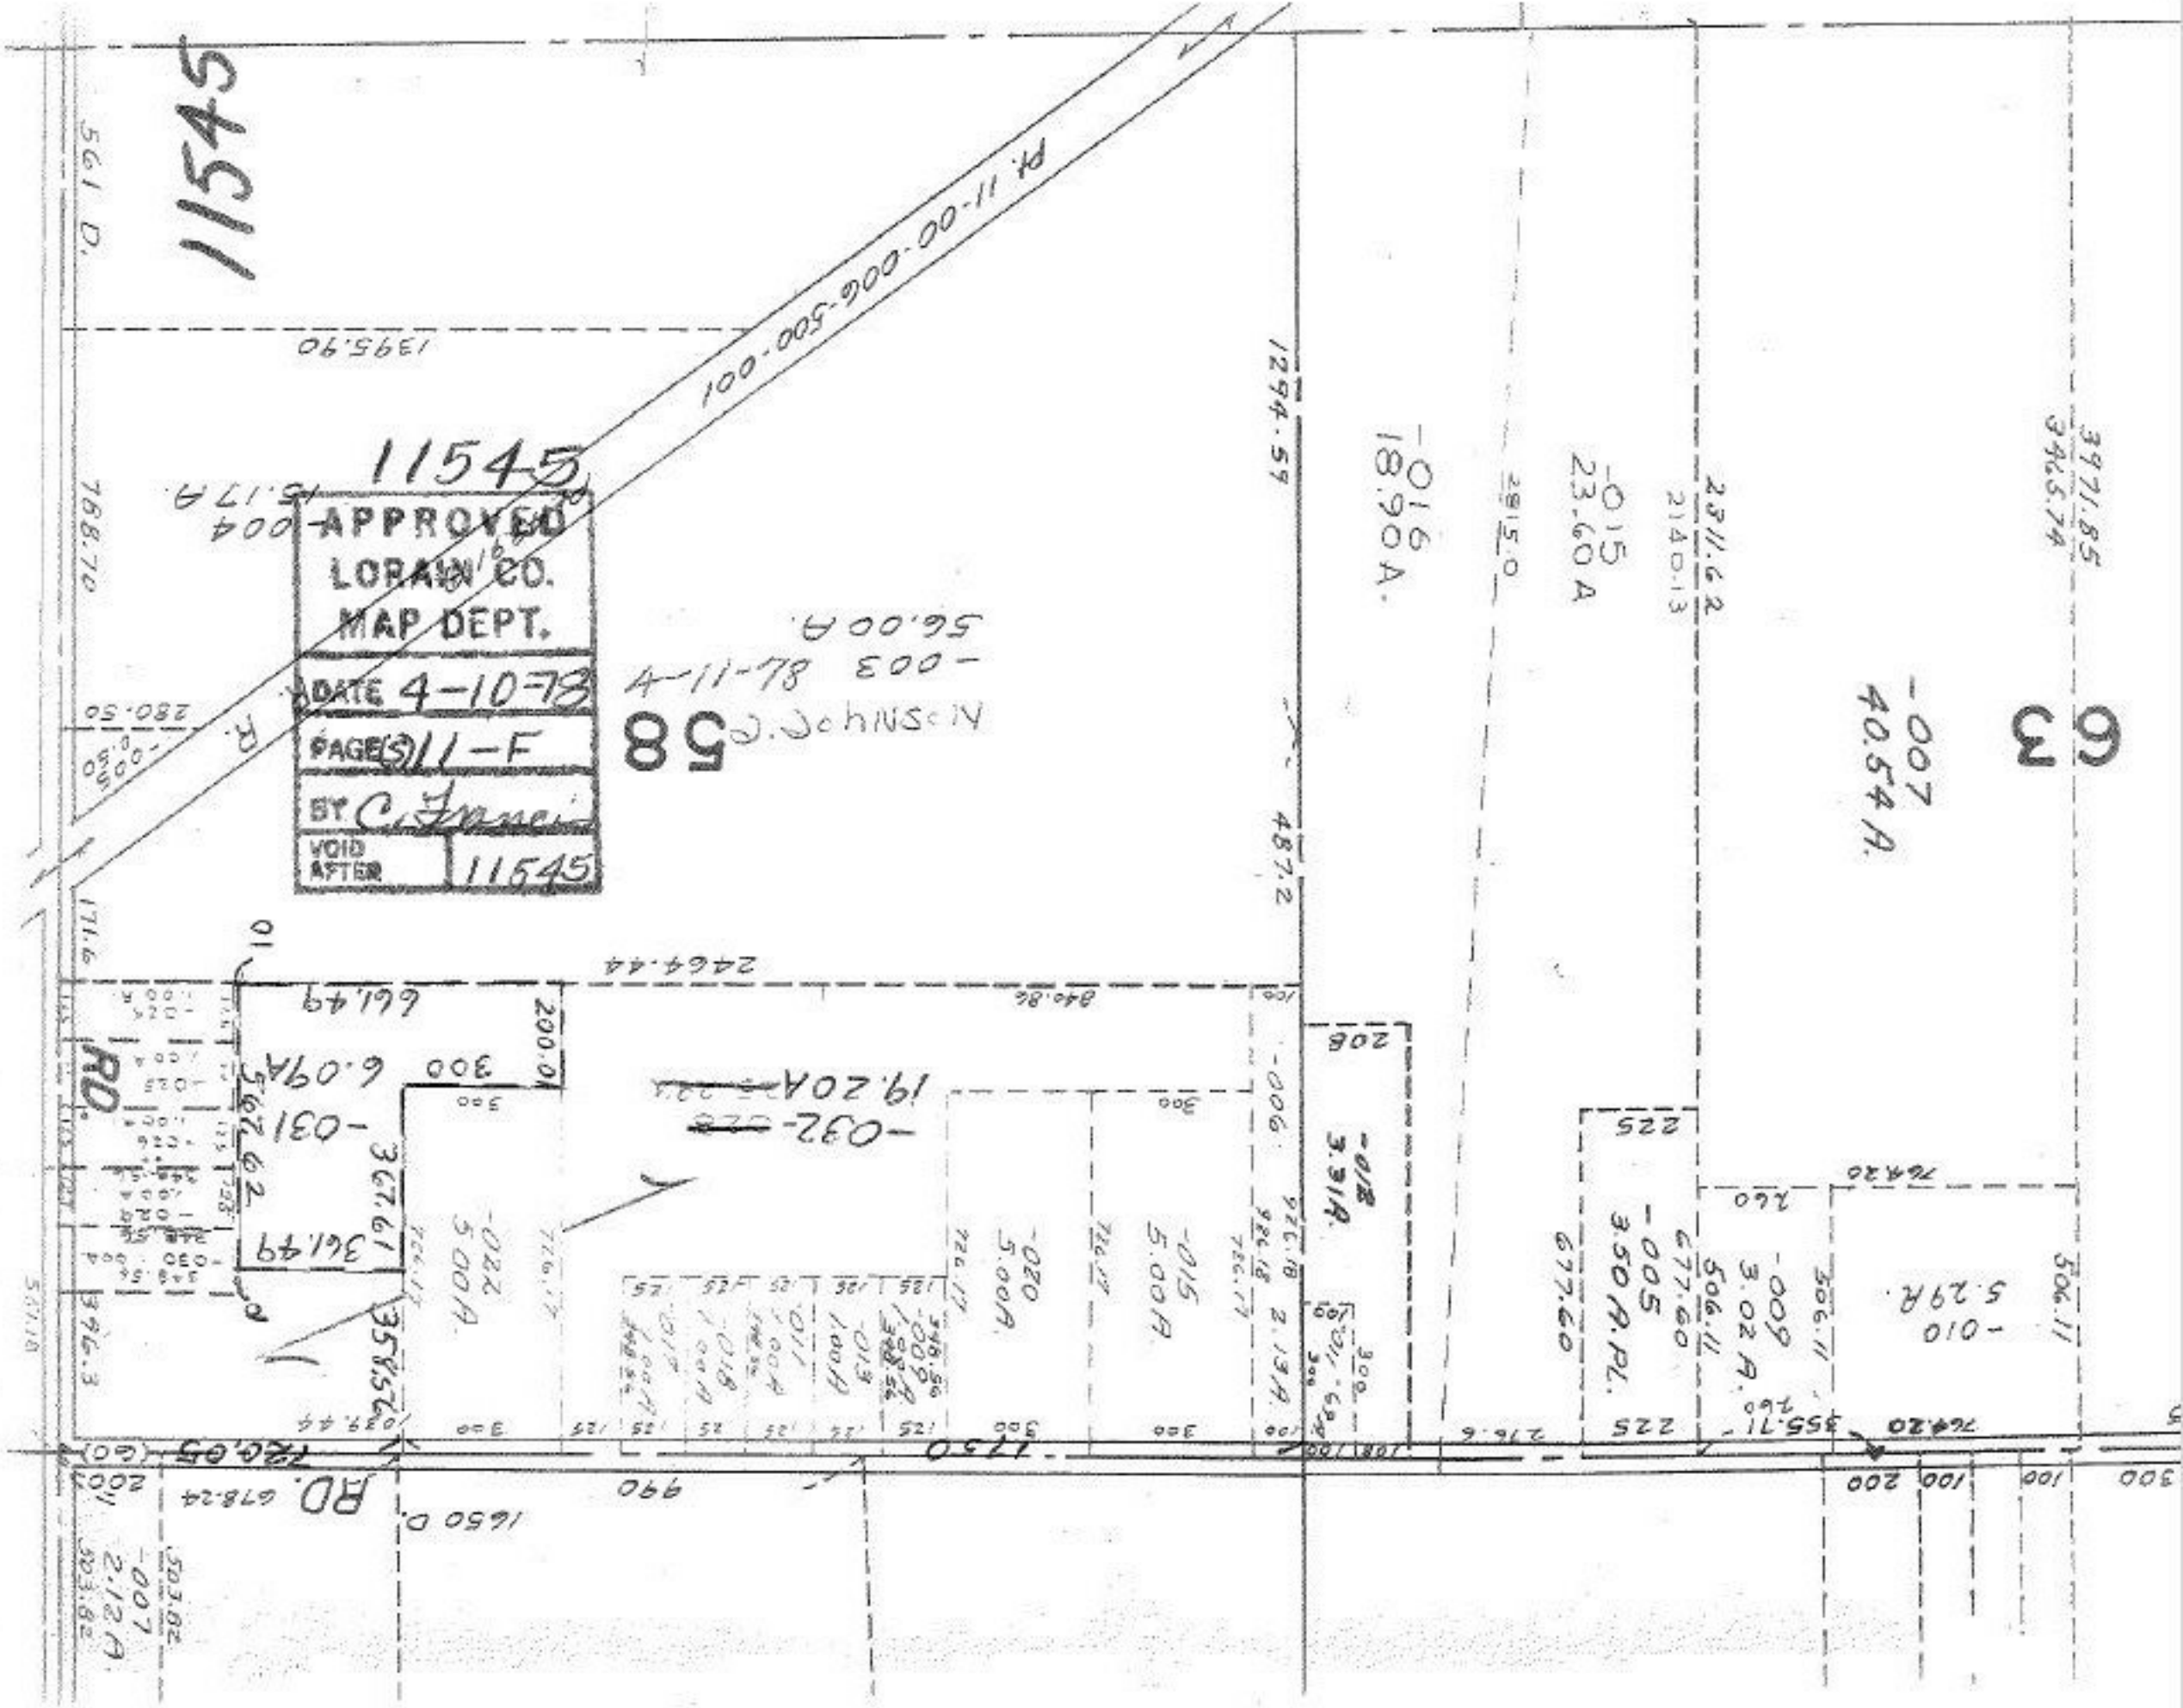
11545
APPROVED
LORAIN CO.
MAP DEPT.
DATE 4-10-78
PAGE(S) 11-F
BY C. Francis
VOID AFTER 11545
58
4-11-78
-003
56.00 A.
-016
18.90 A.
-015
23.60 A
-007
40.54 A.
63
-032
19.20 A
-031
6.09 A
-022
5.00 A
-020
5.00 A
-015
5.00 A
-012
3.31 A
-005
3.50 A. PL.
-009
3.02 A.
-010
5.29 A.
RD.
1395.90
1294.59
487.2
2464.44
1750
990
1650 D.
561 D.
788.70
280.50
171.6
396.3
3971.85
3465.74
2311.62
2140.13
2815.0
677.60
506.11
355.71
764.20
200
100
300
225
208
260