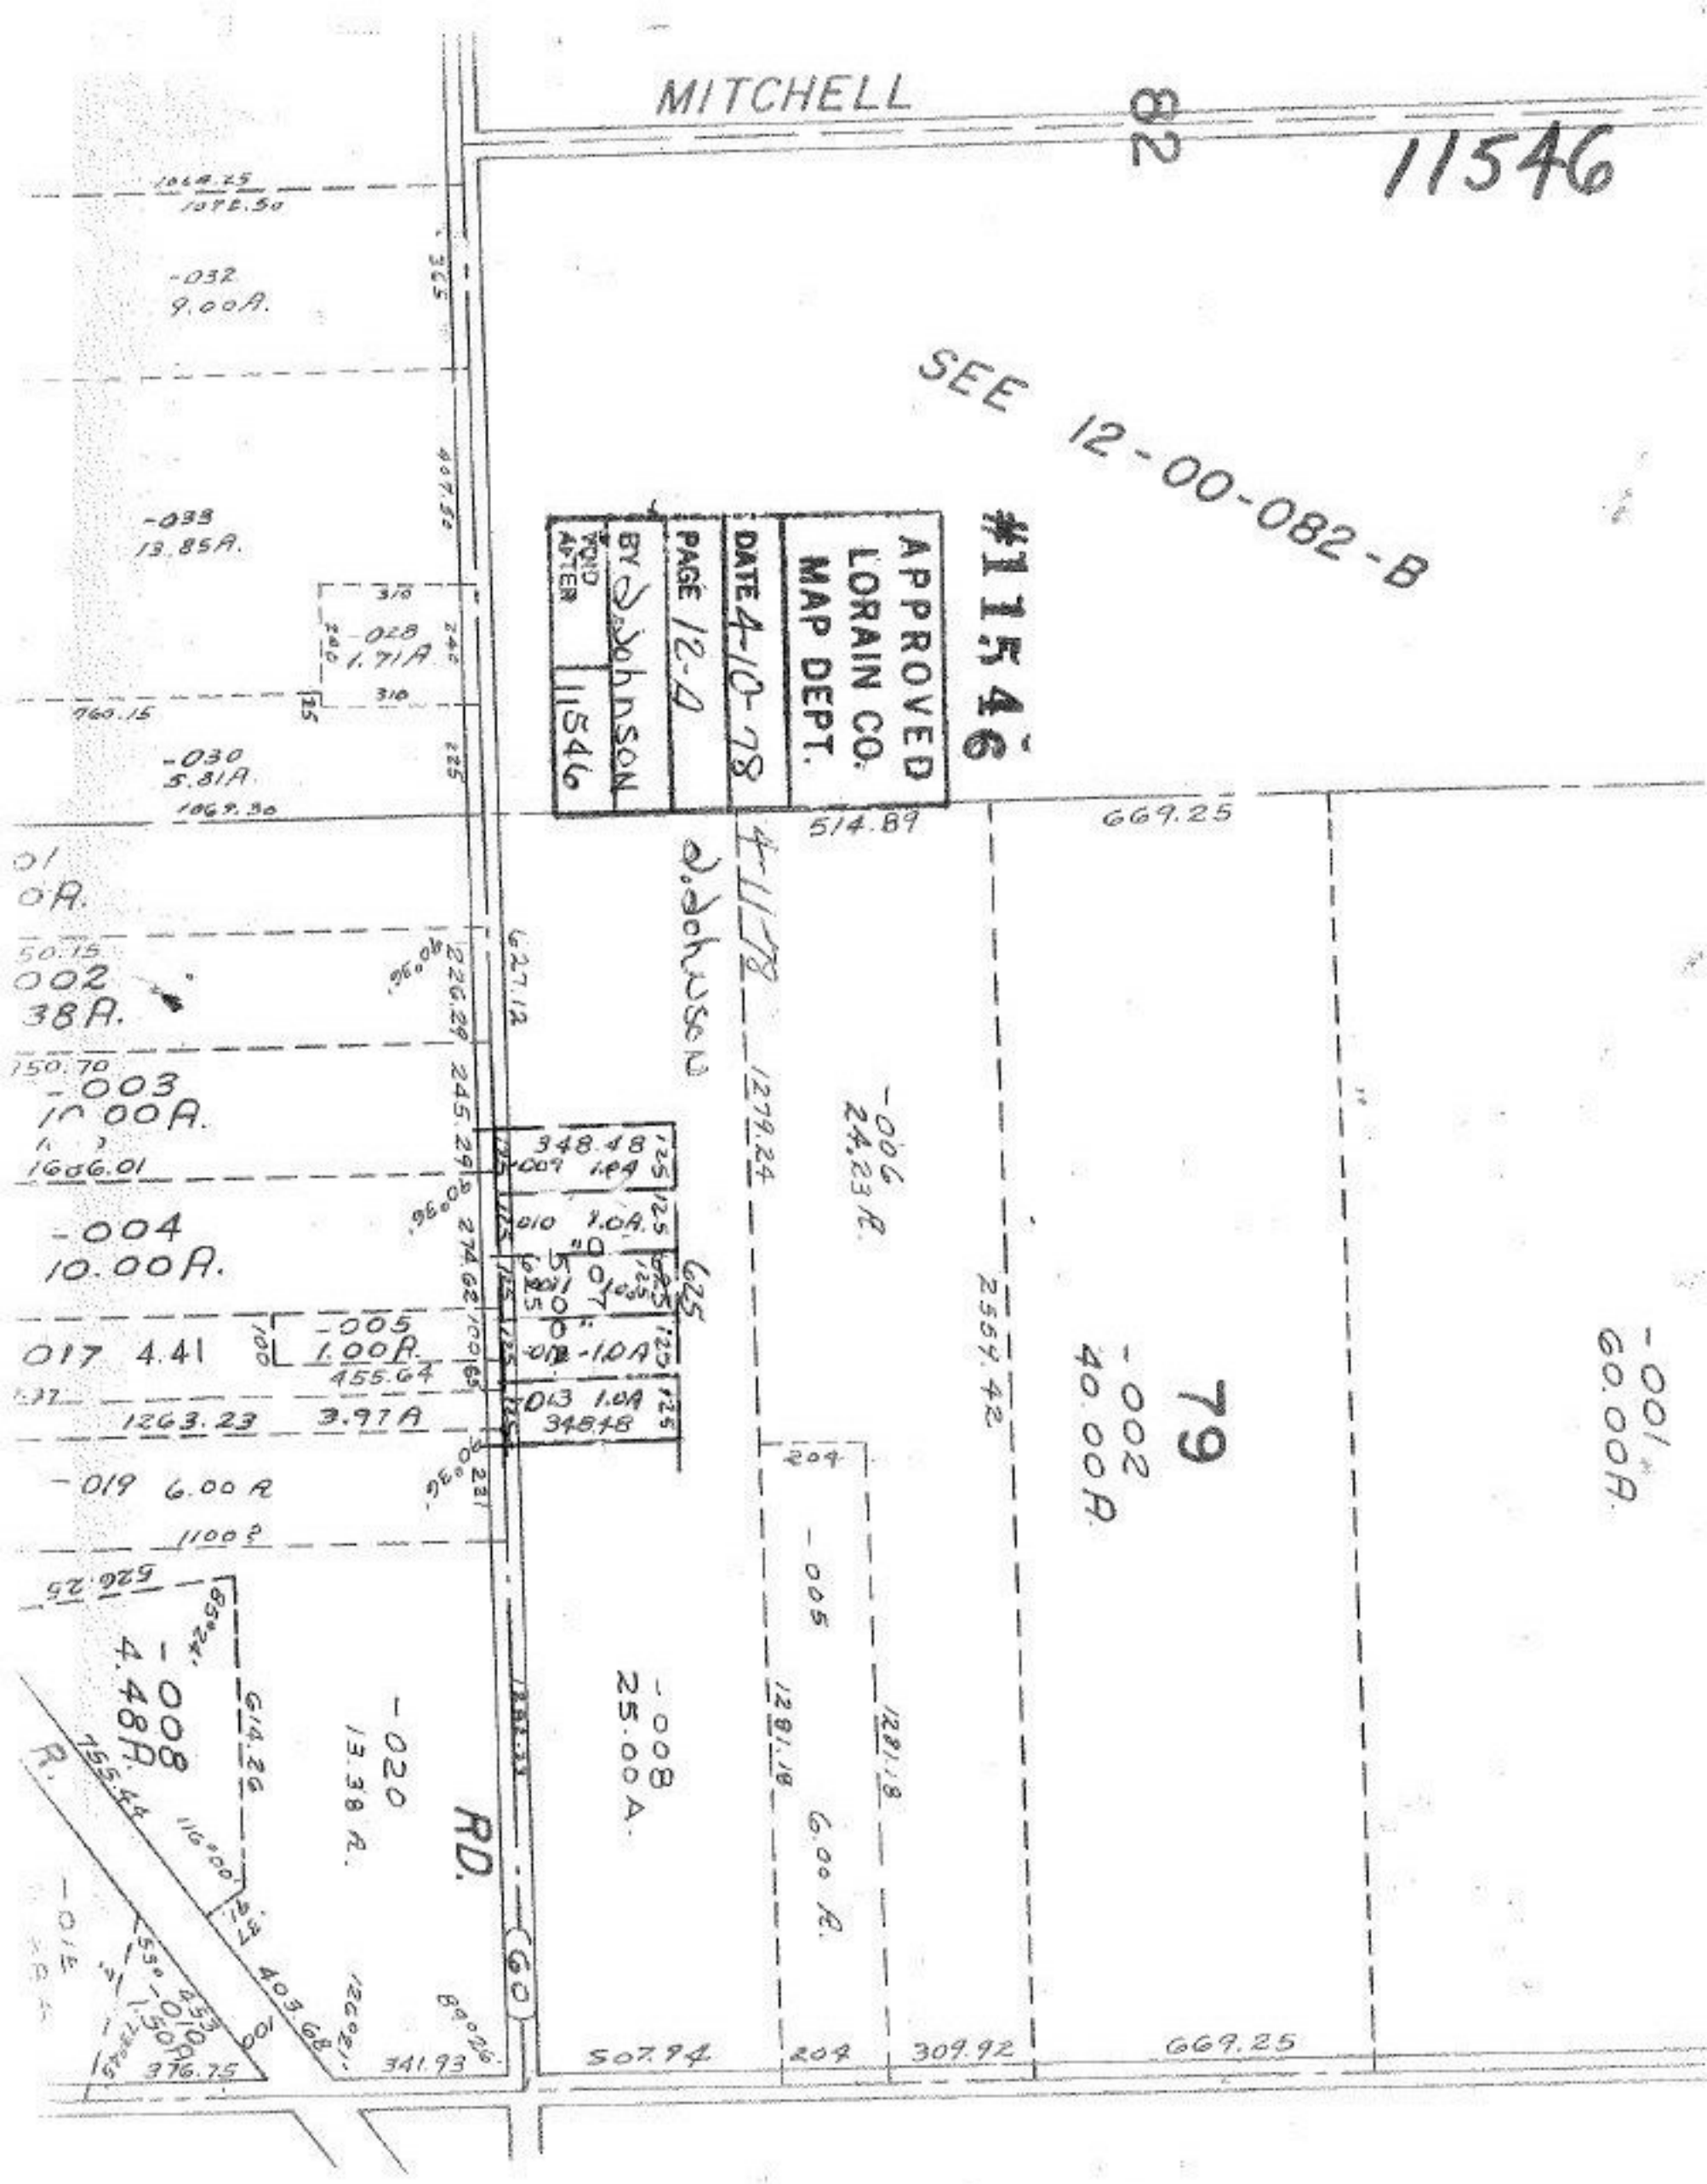
MITCHELL
82
11546
SEE 12-00-082-B
#11546
APPROVED
LORAIN CO.
MAP DEPT.
DATE 4-10-78
PAGE 12-A
BY D. Johnson
VOID AFTER 11546
-032
9.00A.
-033
13.85A.
-028
1.71A
-030
5.81A
514.89
669.25
-002
38A.
-003
10.00A.
-004
10.00A.
-005
1.00A.
455.64
1263.23
3.97A
-019 6.00 A
-008
4.48A.
-020
13.38 A.
RD.
-008
25.00A.
-006
24.23 A.
-005
6.00 A.
-002
40.00A.
-001
60.00A.
79
507.94
309.92
669.25
341.93
376.75