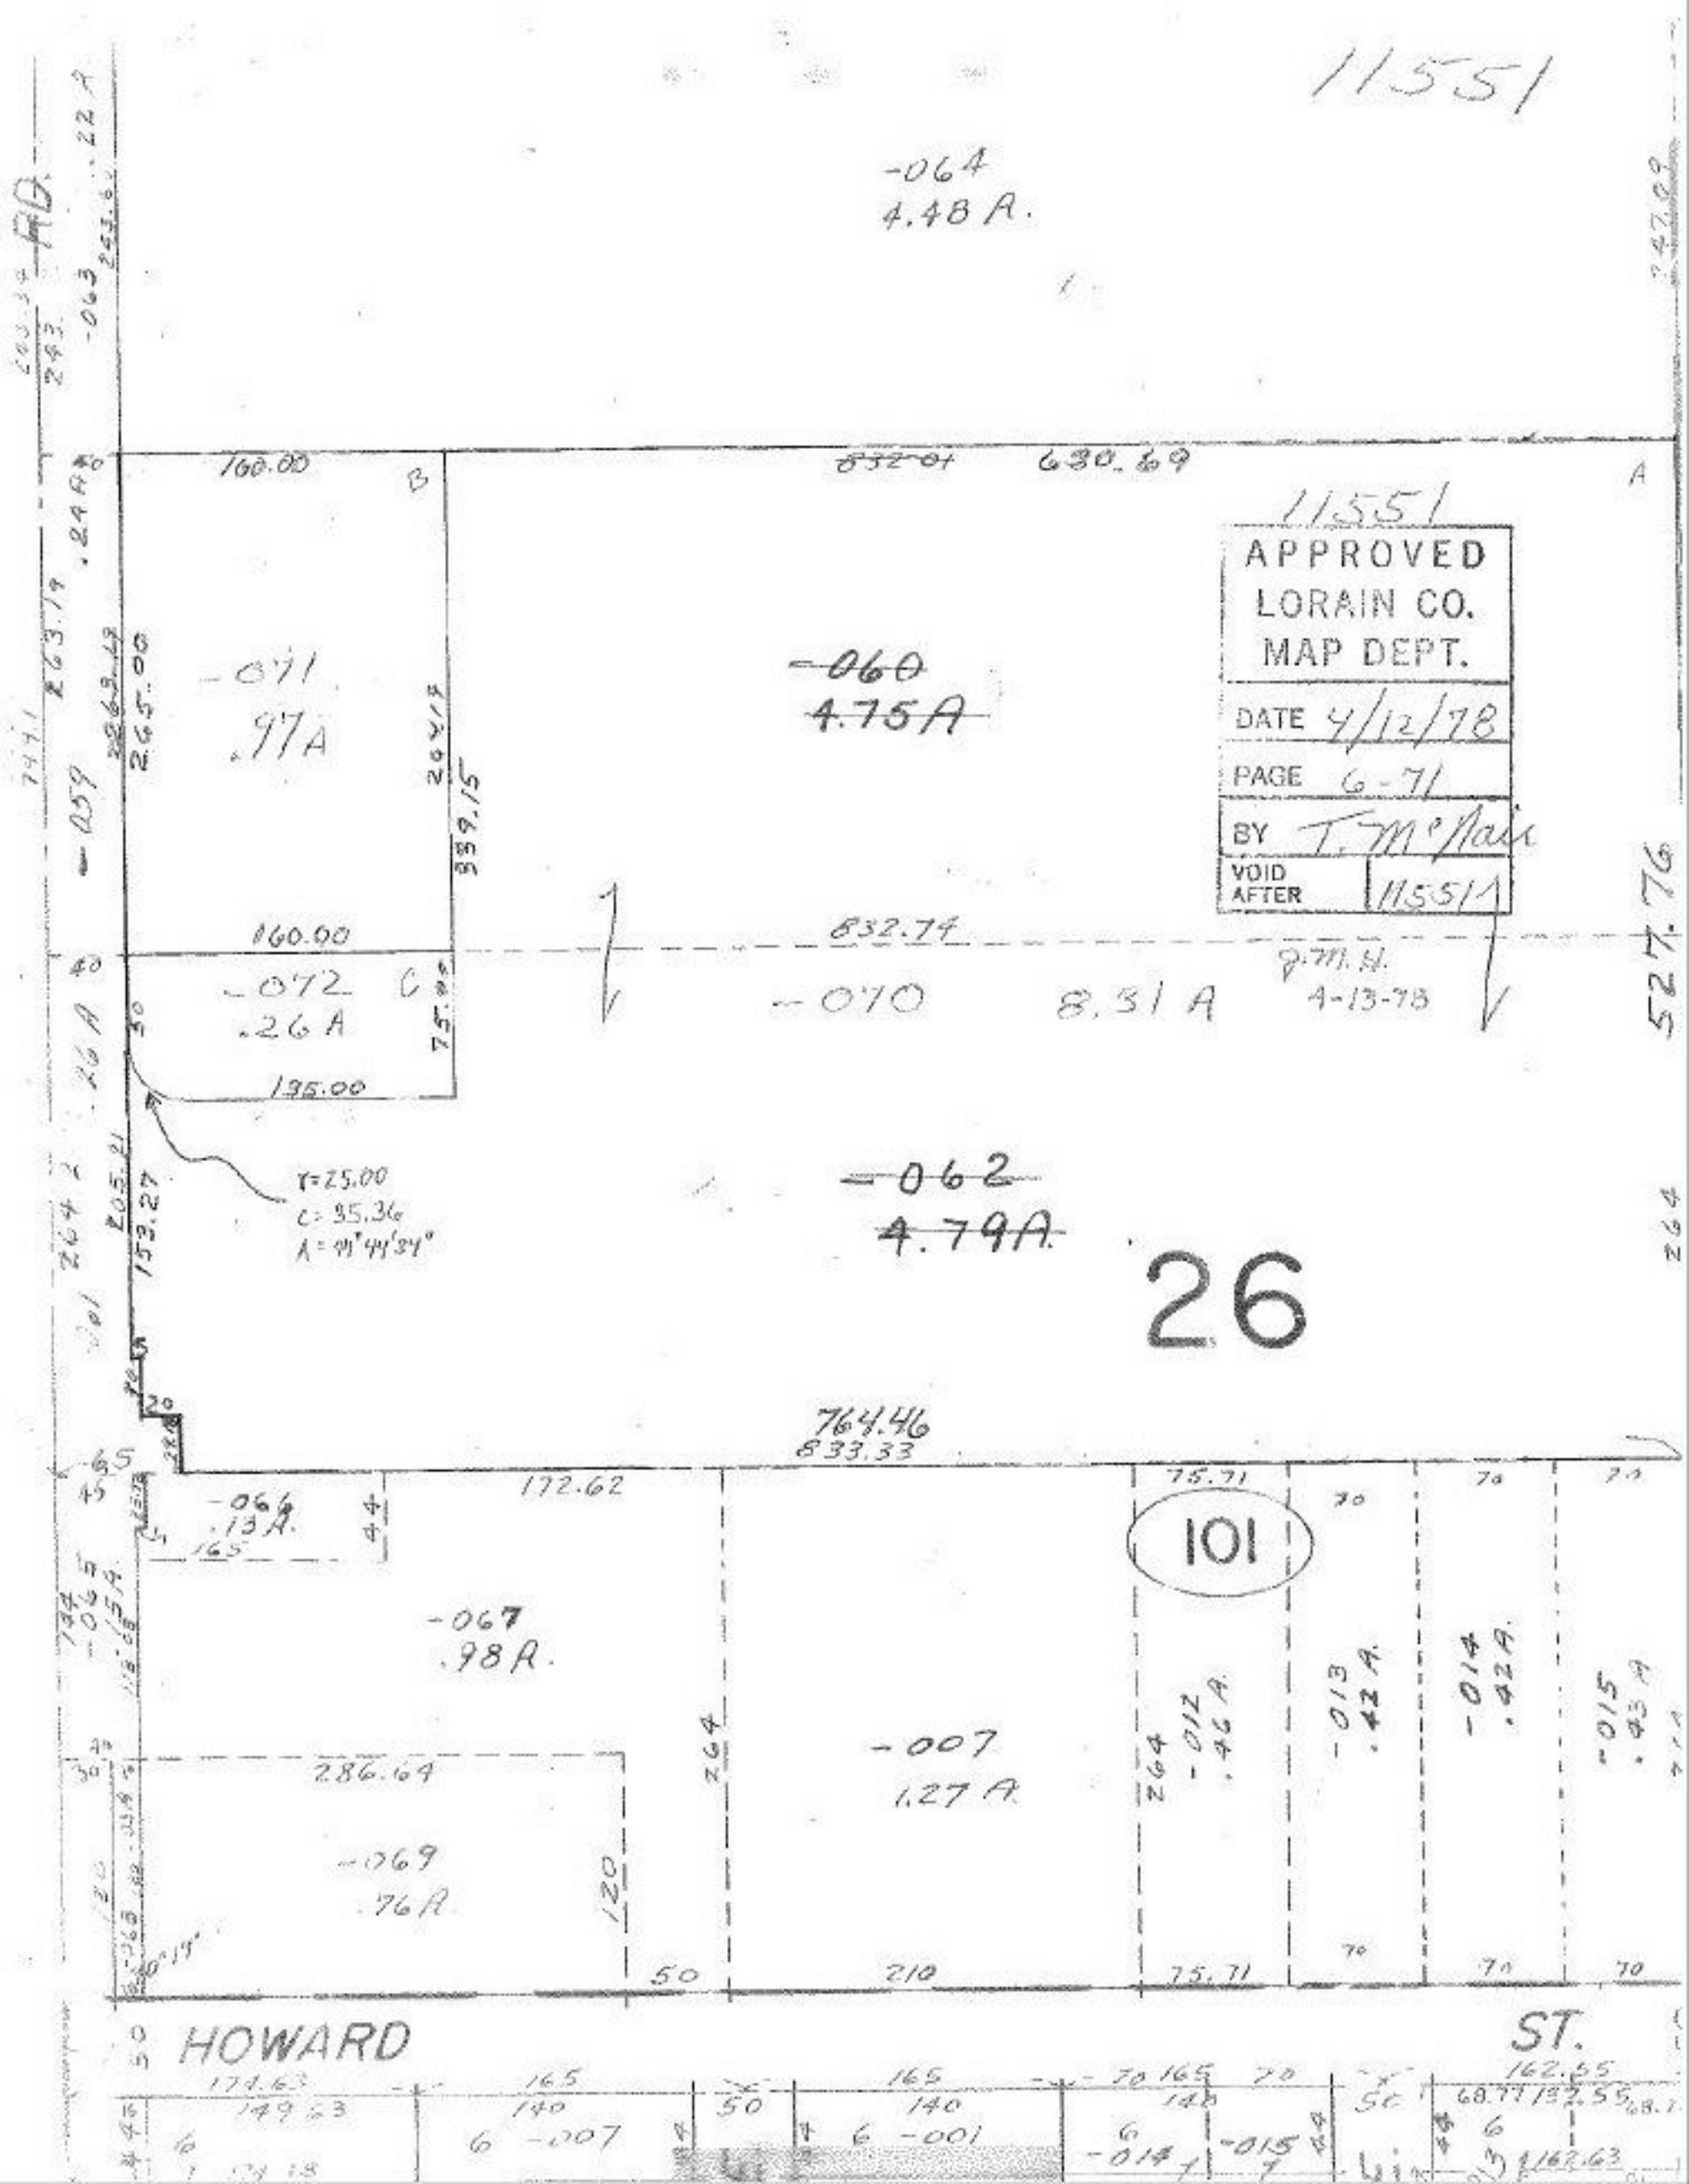
11551
-064
4.48 A.
160.00
B
832.01
630.69
A
11551
APPROVED
LORAIN CO.
MAP DEPT.
DATE 4/12/78
PAGE 6-71
BY T. McNair
VOID AFTER 11551
-071
.97A
265.00
339.15
-060
4.75A
160.00
832.74
-072
.26 A
C
-070
8.31 A
4-13-78
135.00
527.76
r=25.00
c=35.36
A=41°44'34"
-062
4.79A
26
764.46
833.33
172.62
-066
.13A.
-067
.98A.
101
75.71
-007
1.27 A.
-012
.46 A.
-013
.42 A.
-014
.42 A.
-015
.43 A
286.64
-069
.76A
50
210
HOWARD
ST.
174.63
149.63
165
140
6 -007
50
6 -001
-014
-015
162.55
68.77
132.55
162.63