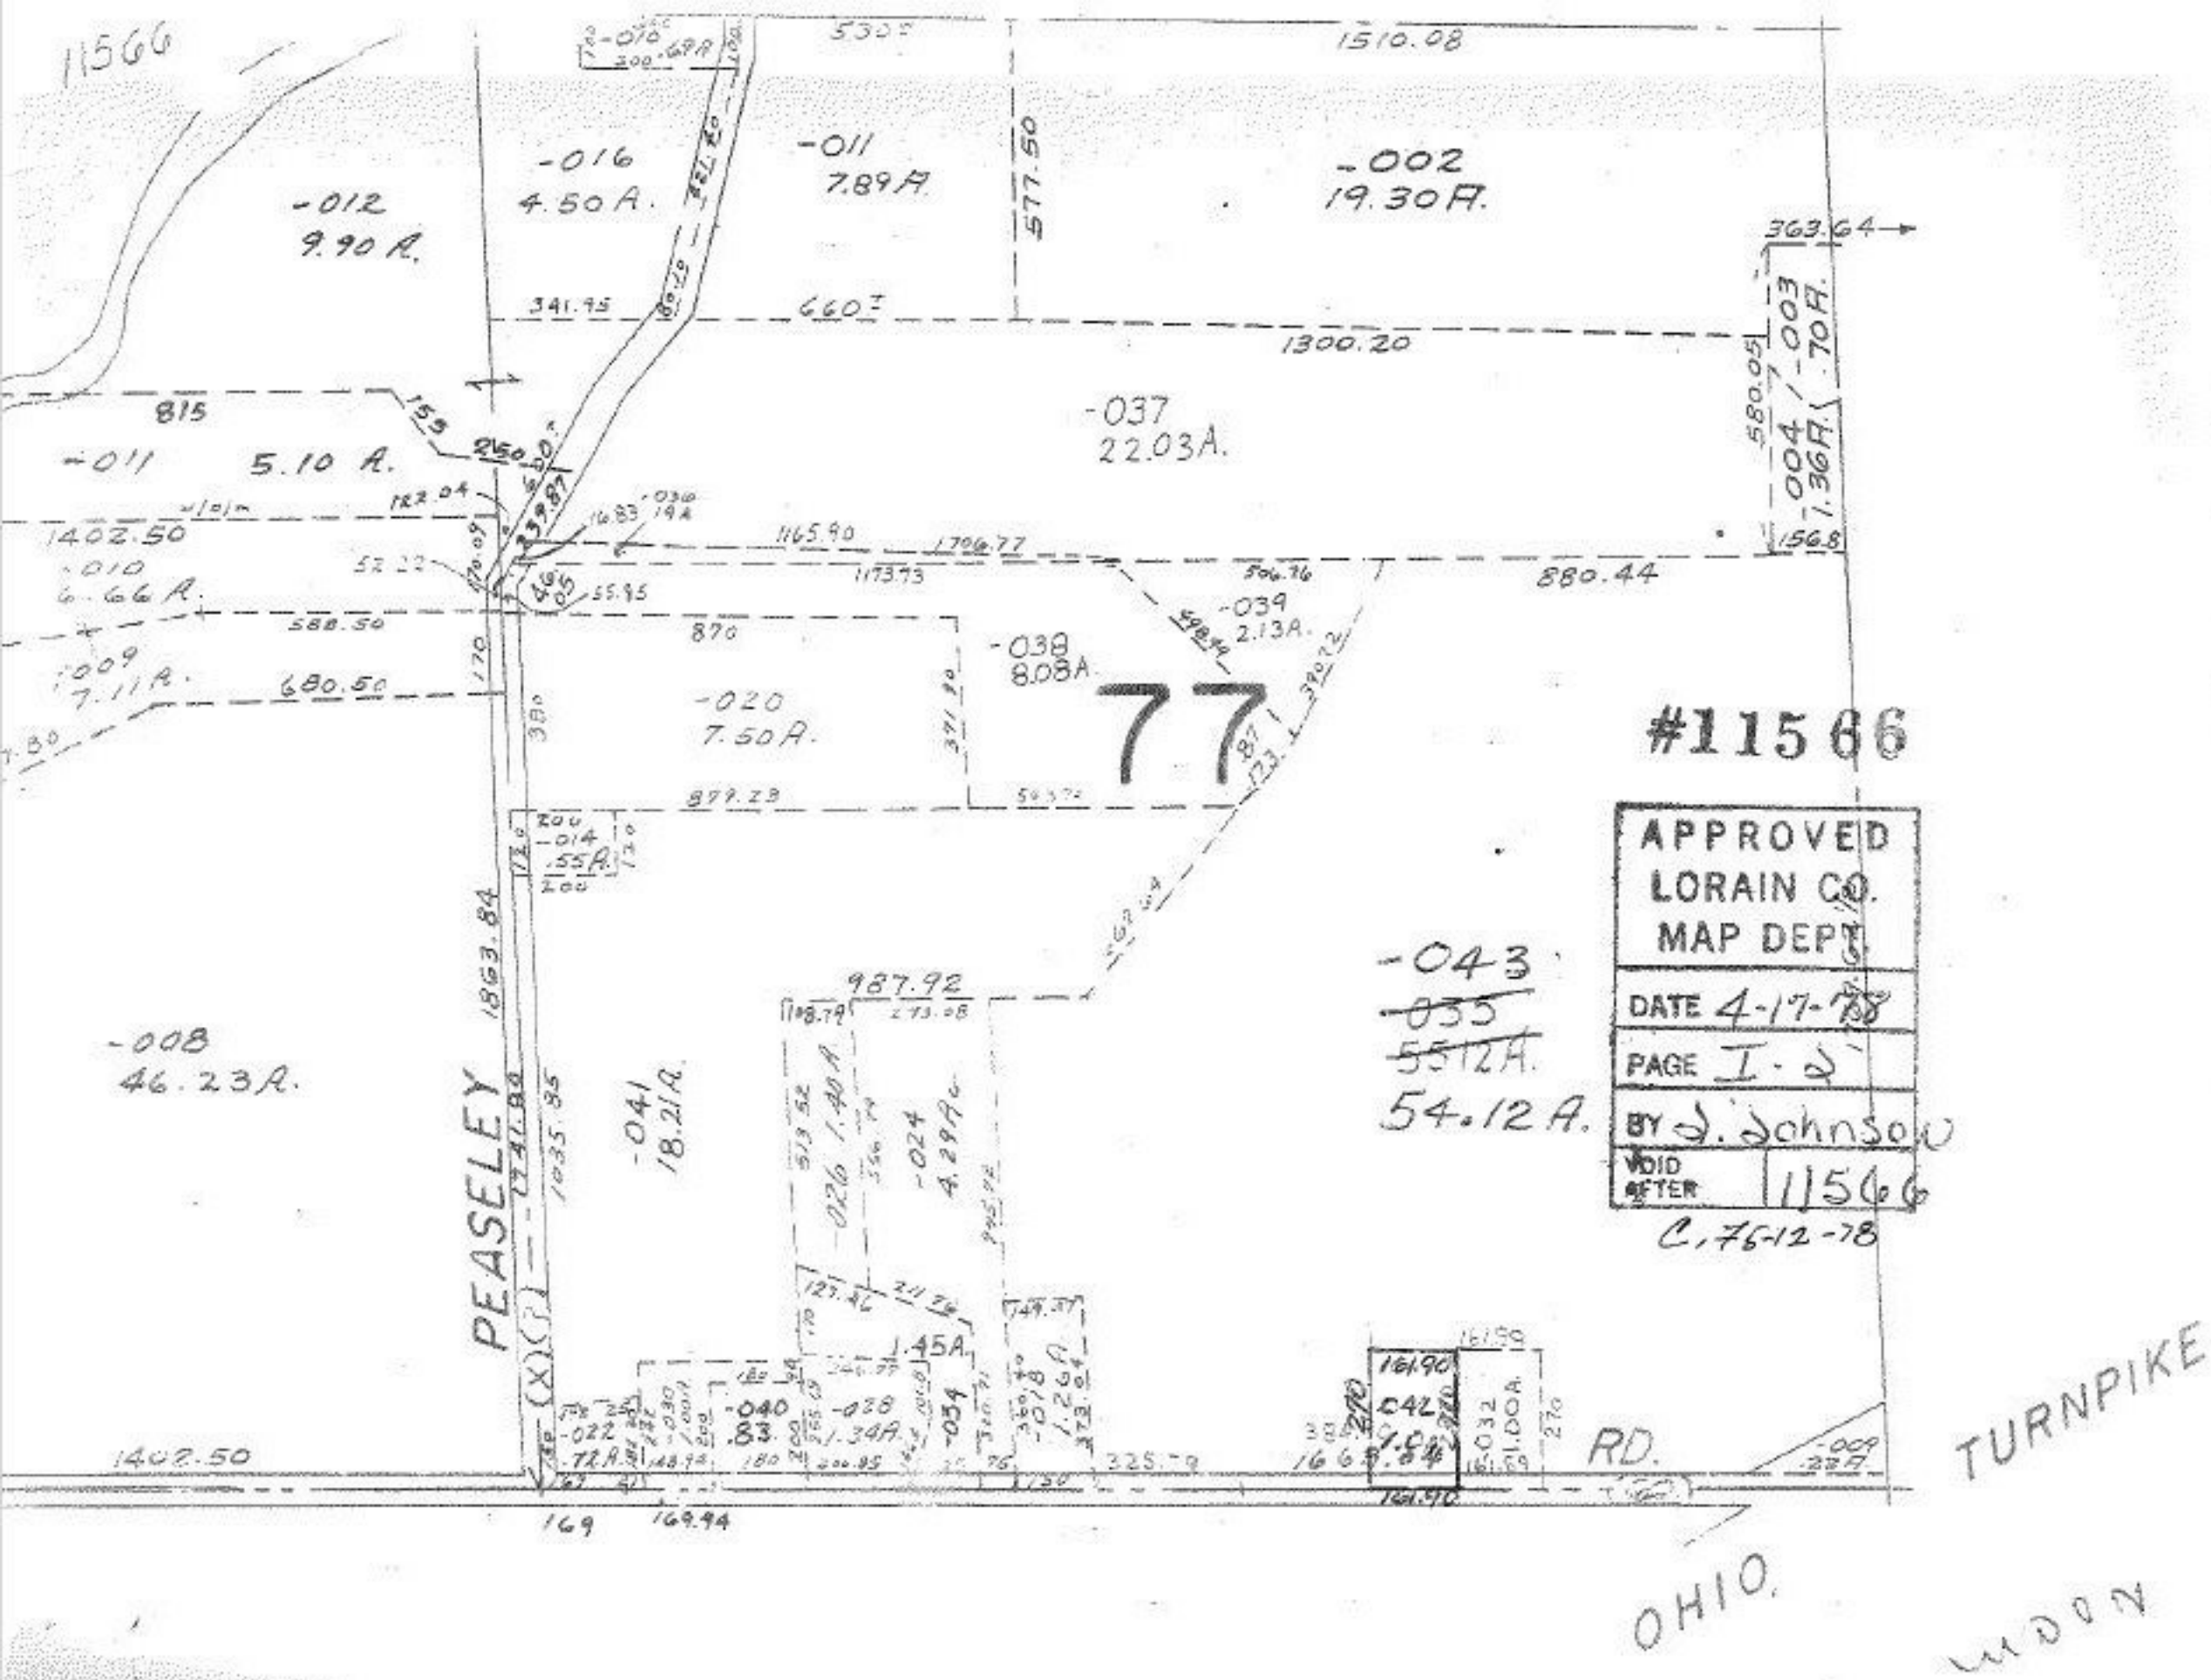
11566
-012
9.90 A.
-016
4.50 A.
-011
7.89 A.
-002
19.30 A.
1510.08
577.50
363.64
341.95
660±
1300.20
815
-011
5.10 A.
-037
22.03A.
580.05
-004 / -003
1.36A. .70A.
1402.50
-010
6.66 A.
1165.90
1706.77
1173.73
880.44
588.50
870
-039
2.13A.
-038
8.08A.
-009
7.11 A.
680.50
-020
7.50 A.
77
879.23
-014
.55A.
1863.84
987.92
-043
~~-035~~
~~5512A.~~
54.12 A.
-008
46.23A.
PEASELEY
-041
18.21A.
-026 1.40A.
-024
4.29A.
1.45A.
-040
.83
-028
1.34A.
-034
-018
1.26A.
-022
.72A.
1402.50
169
169.94
325.79
161.90
.042
1.00A.
.032
1.00A.
RD.
TURNPIKE
OHIO.
#11566
APPROVED
LORAIN CO.
MAP DEPT.
DATE 4-17-78
PAGE I-2
BY J. Johnson
VOID AFTER 11566
C, 76-12-78