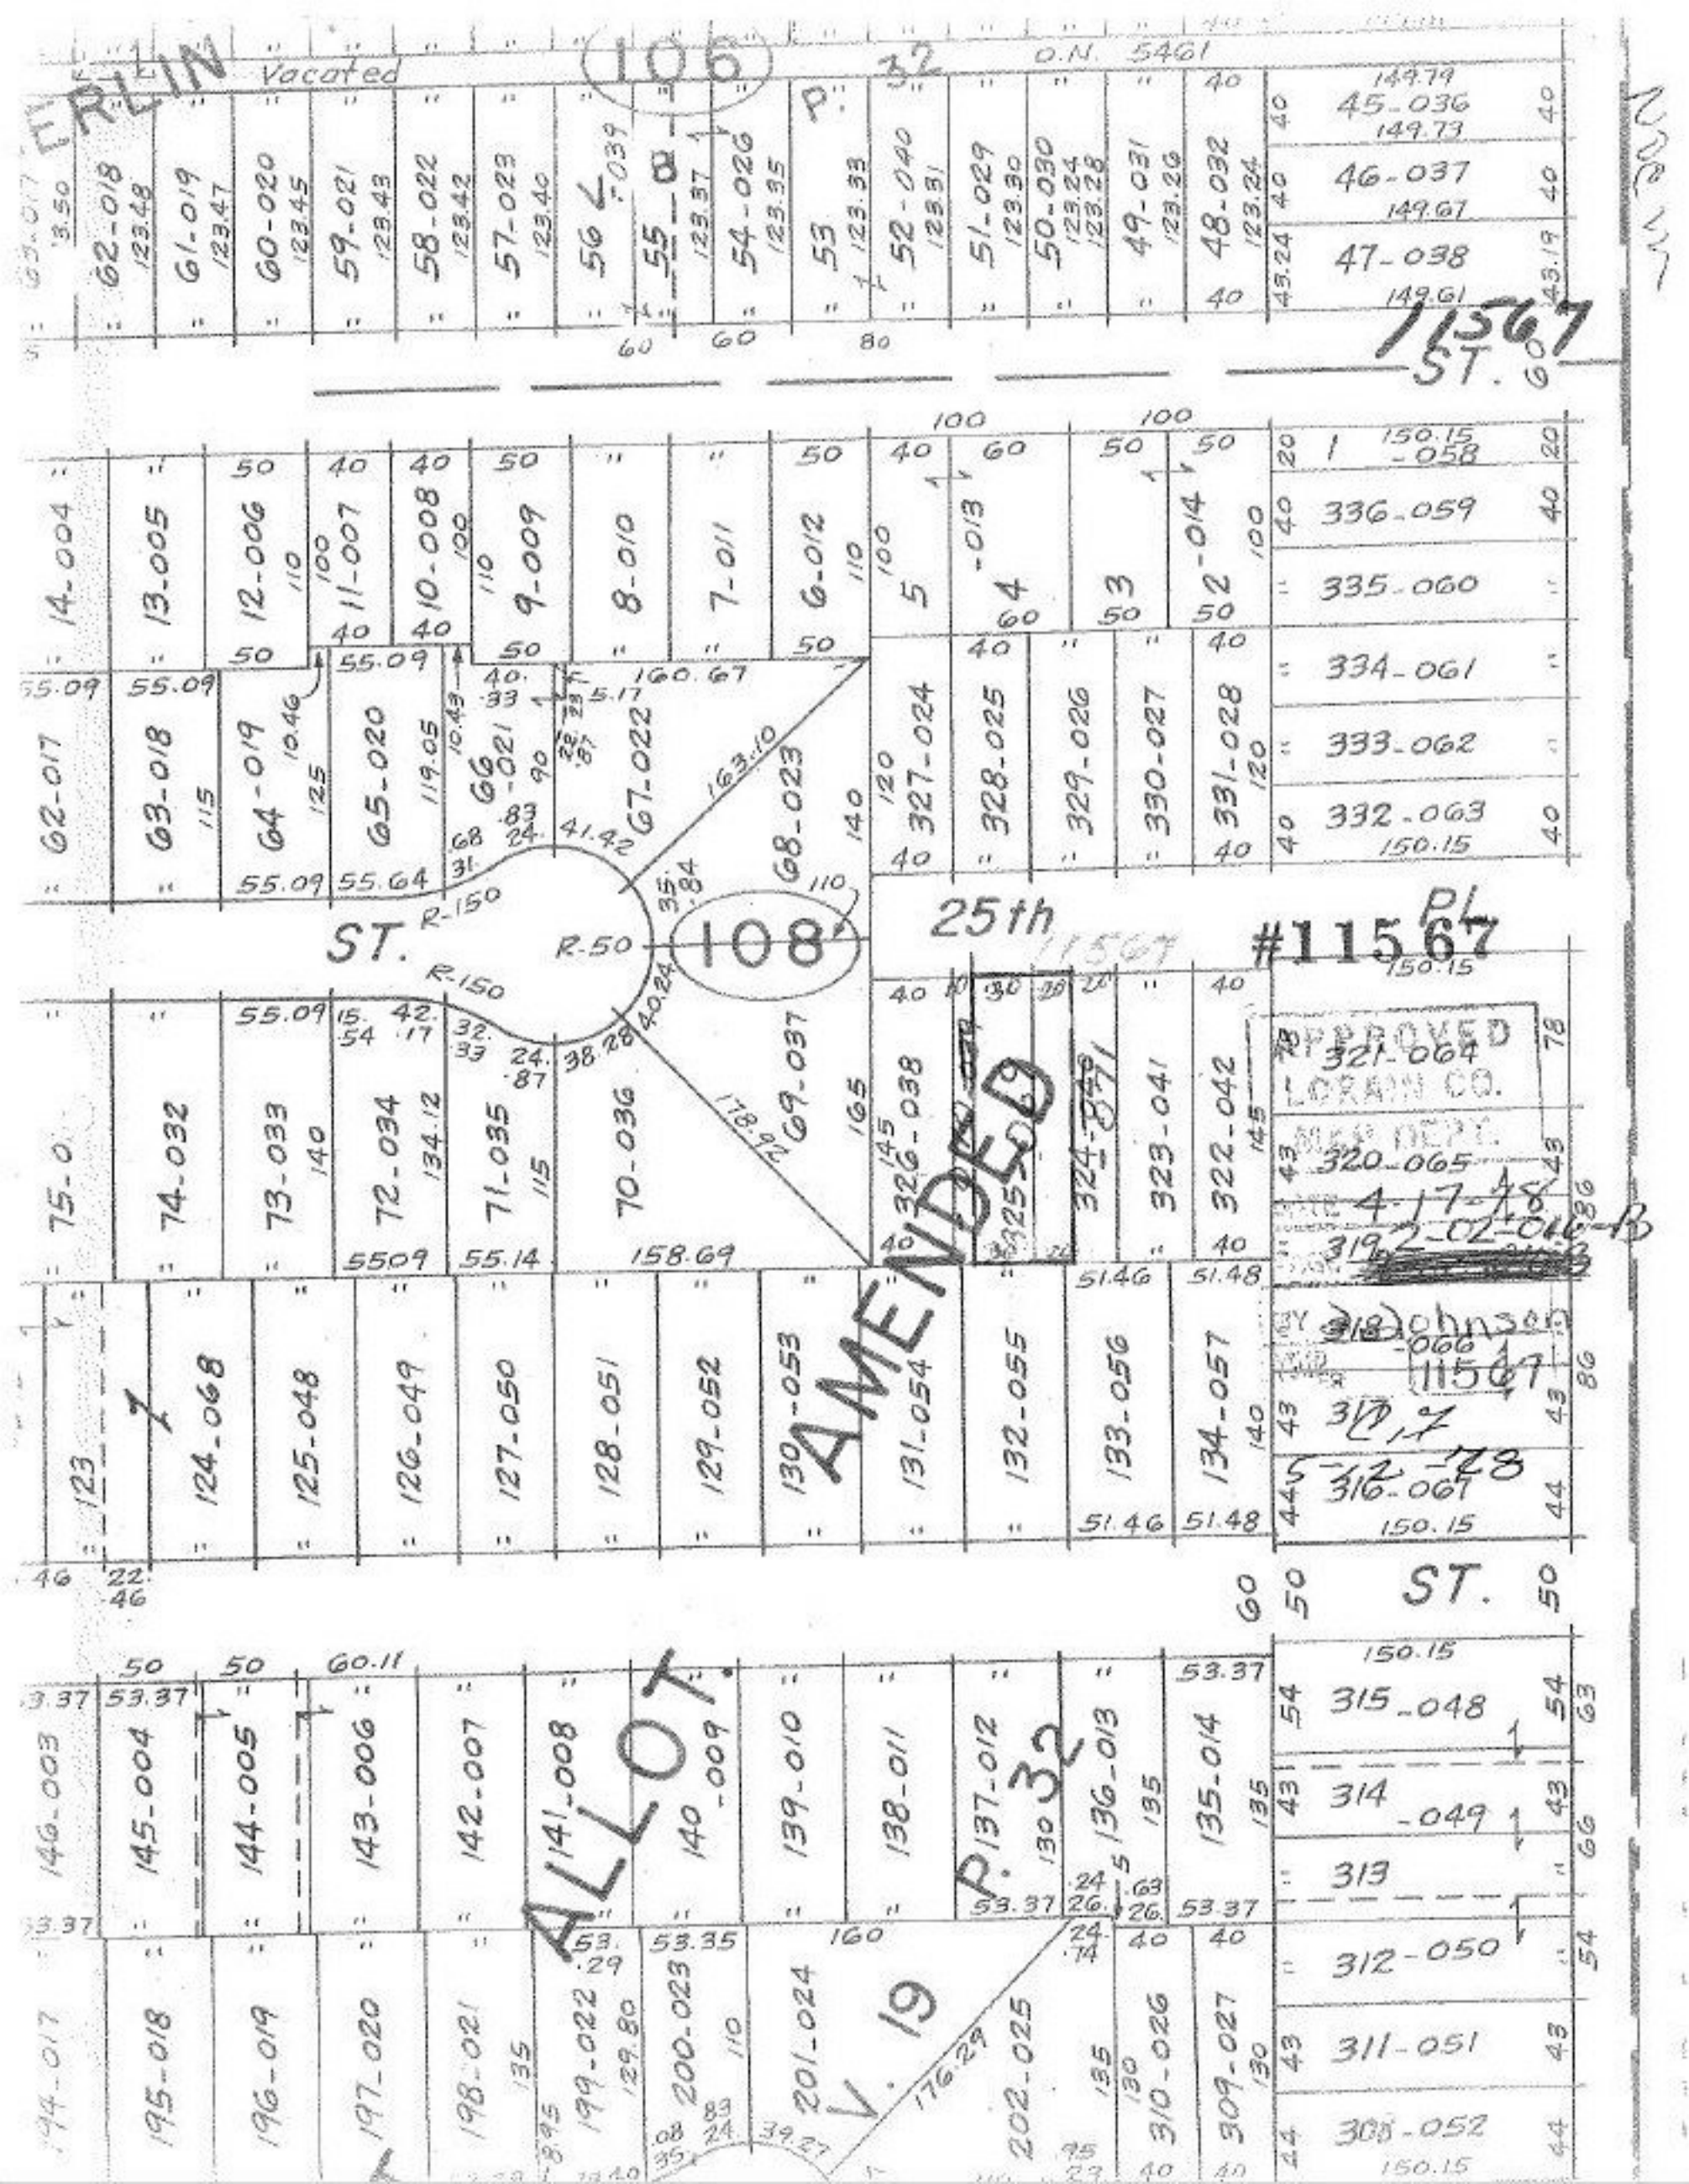

ERLIN
Vacated
106
P. 32
O.N. 5461
11567
ST.
108
25th
PL
#11567
AMENDED
ALLOT.
P. 32
V. 19
ST.
APPROVED
LORAIN CO.
MAP DEPT.
4-17-78
2-02-016-B
Johnson
11567
5-12-78