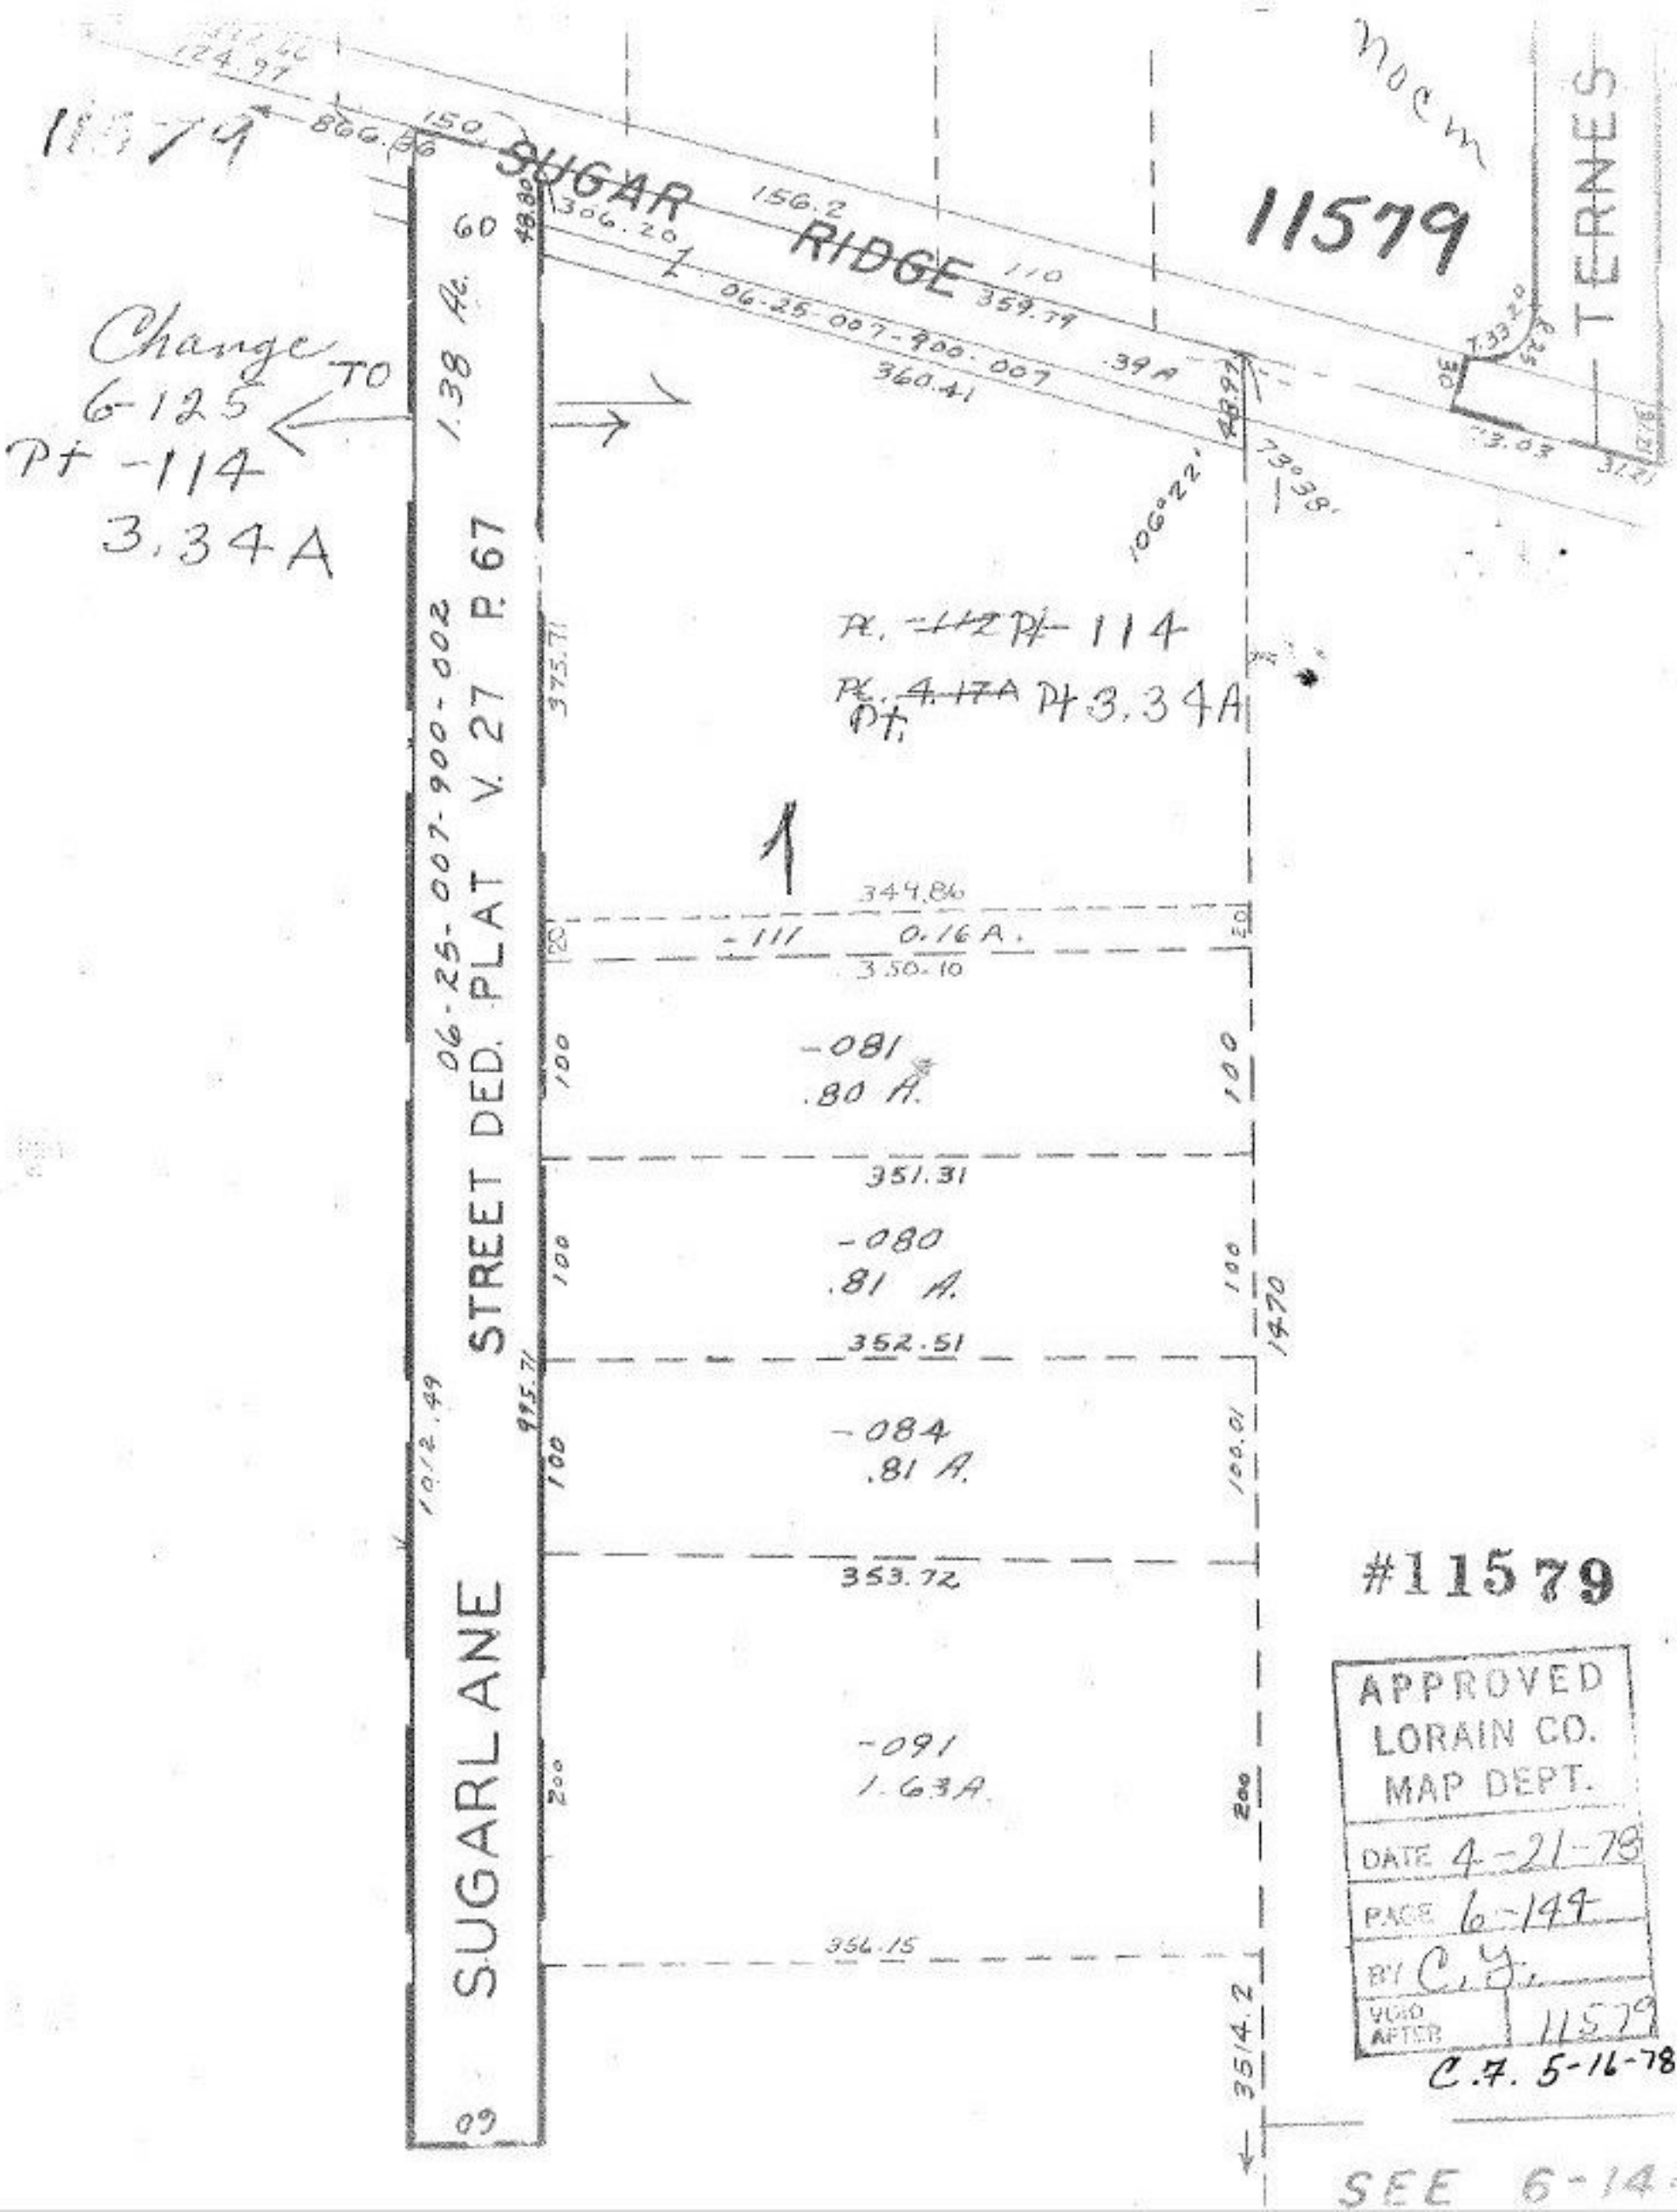

11579
SUGAR RIDGE
TERNES
Change TO 6-125 Pt -114 3.34A
1.38 Ac.
06-25-007-900-002
STREET DED. PLAT V. 27 P. 67
SUGARLANE
Pt. ~~-112~~ Pt -114
Pt. ~~4.17A~~ Pt. Pt 3.34A
-111 0.16 A.
-081 .80 A.
-080 .81 A.
-084 .81 A.
-091 1.63A.
#11579
APPROVED LORAIN CO. MAP DEPT.
DATE 4-21-78
PAGE 6-144
BY C.Y.
VOID AFTER 11579
C.7. 5-16-78
SEE 6-14