11579

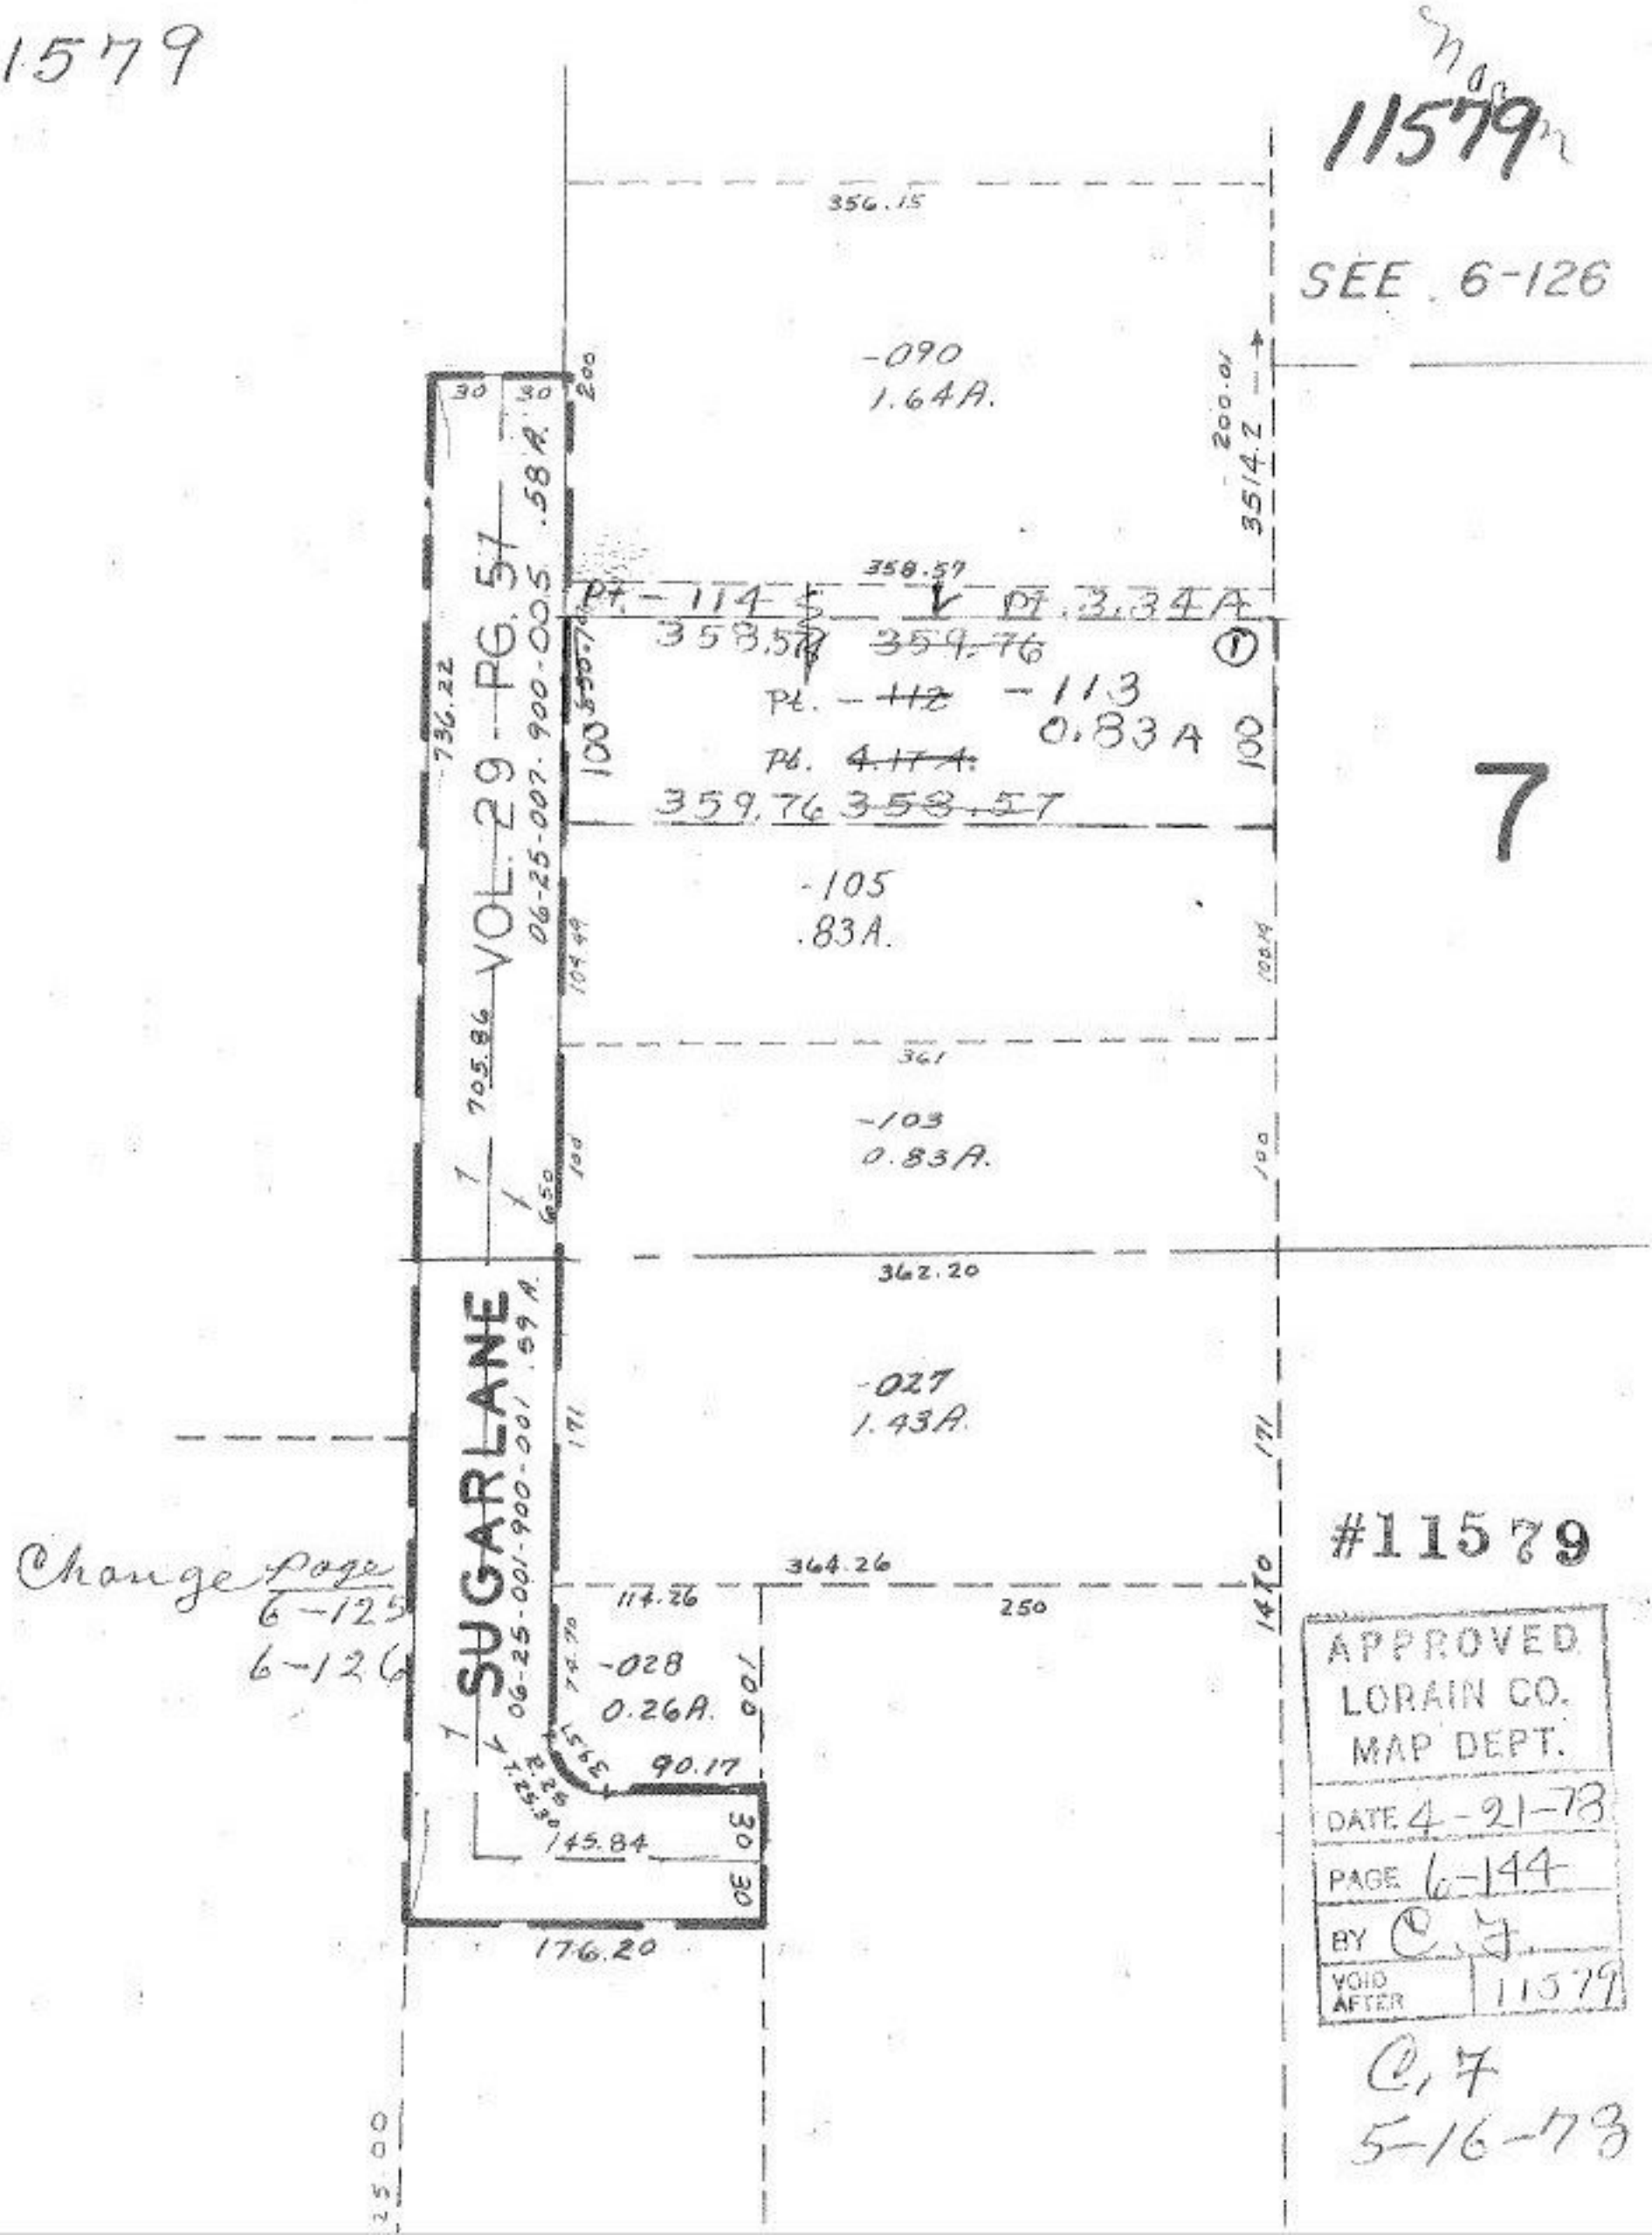
11579
SEE 6-126
356.15
-090
1.64A.
200.01
3514.2
358.57
Pt. - 114
Pt. 3.34A
358.57 ~~359.76~~
Pt. - ~~112~~ -113
0.83A
Pt. ~~4.17A.~~
359.76 ~~358.57~~
-105
.83A.
361
-103
0.83A.
362.20
-027
1.43A.
SUGARLANE
06-25-001-900-001 .59 A.
VOL. 29 - PG. 51
06-25-007-900-005 .58 A.
736.22
705.86
364.26
114.26
250
-028
0.26A.
90.17
145.84
176.20
Change page
6-125
6-126
7
#11579
APPROVED
LORAIN CO.
MAP DEPT.
DATE 4-21-78
PAGE 6-144
BY C. F.
VOID AFTER 11579
C. F.
5-16-78