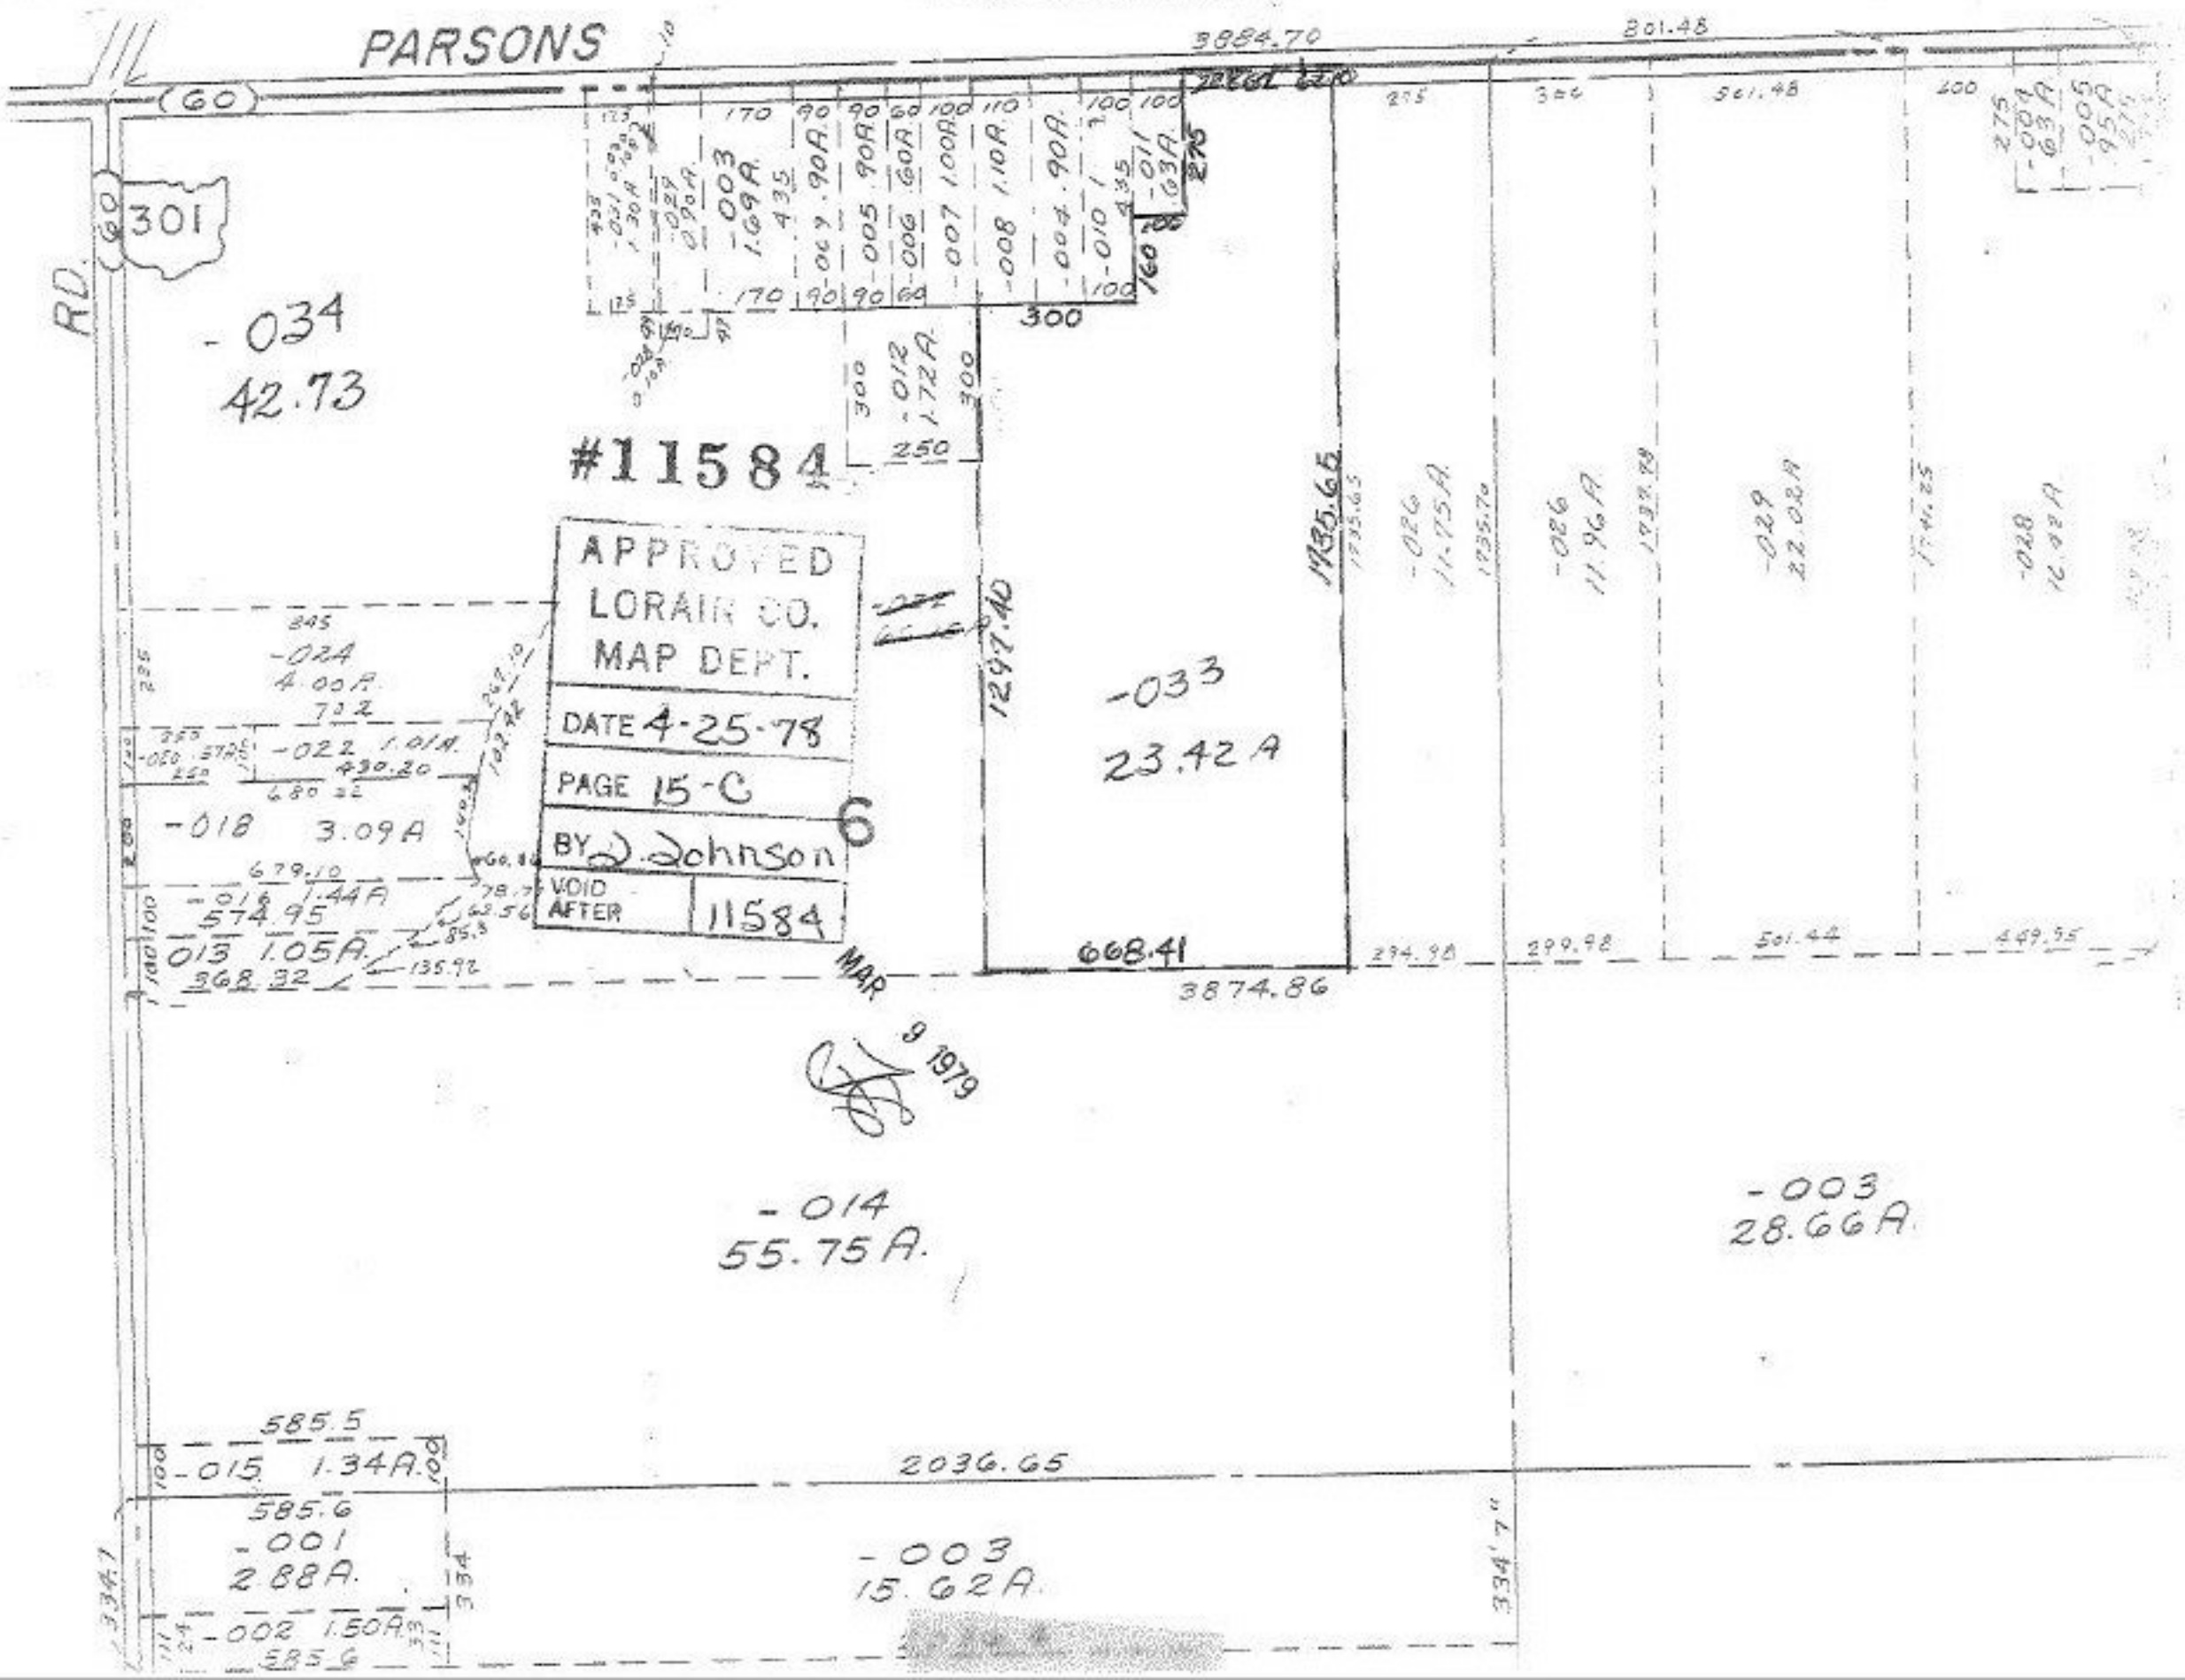
PARSONS
RD.
301
-034
42.73
#11584
APPROVED
LORAIN CO.
MAP DEPT.
DATE 4-25-78
PAGE 15-C
BY D. Johnson
VOID AFTER 11584
6
MAR 9 1979
-033
23.42 A
-014
55.75 A.
-003
28.66 A.
-003
15.62 A.
-024
4.00 A.
-022 1.01 A.
-018 3.09 A
-016 1.44 A
-013 1.05 A.
-015 1.34 A.
-001
2.88 A.
-002 1.50 A.
-026
11.75 A.
-026
11.96 A
-029
22.02 A
-028
16.42 A
-012
1.72 A.
-003
1.69 A.
-009 .90 A.
-005 .90 A.
-006 .60 A.
-007 1.00 A.
-008 1.10 A.
-004 .90 A.
-010 1
-011
.63 A.
-004
.63 A
-005
.95 A
3884.70
801.48
1735.65
1297.40
668.41
3874.86
2036.65
334'7"
585.5
585.6
574.95
368.32
679.10
680.32
430.20
702
1735.70
1737.78
1741.25
294.98
299.98
501.44
449.95
334.7
334