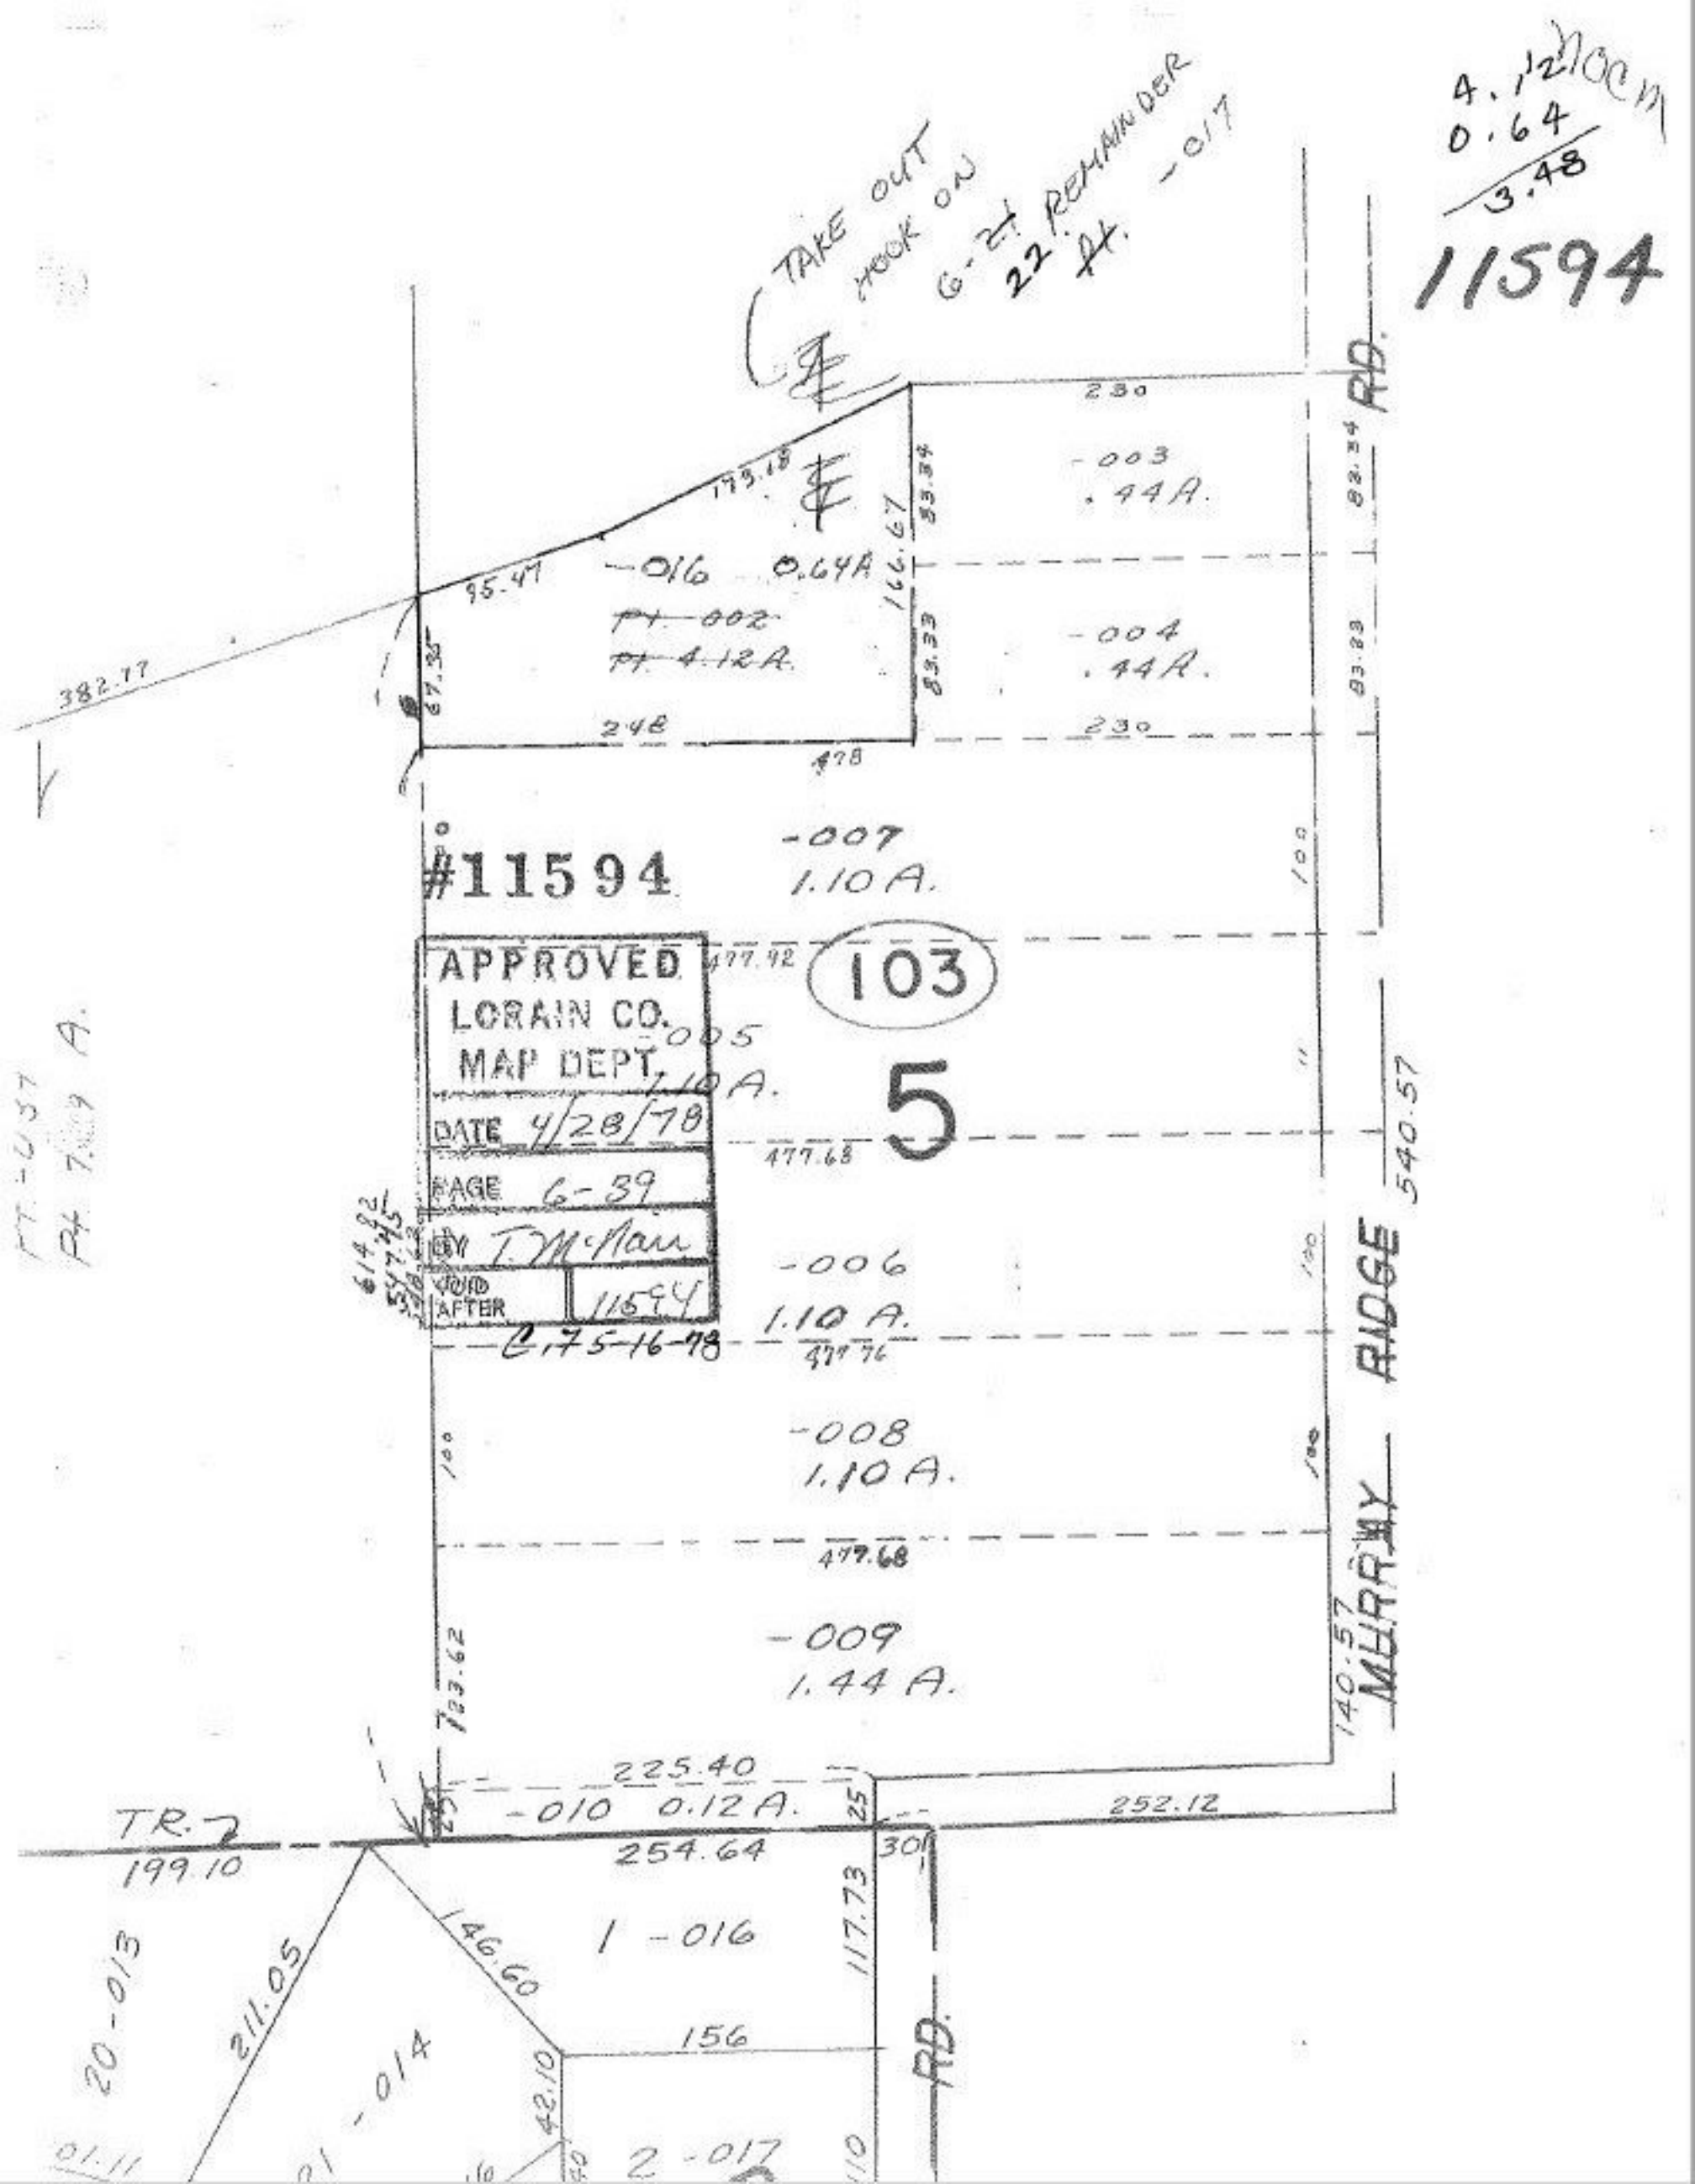

4.12 NOCM
0.64
3.48
11594
TAKE OUT
HOOK ON
6-21 REMAINDER
22 Pt. -017
230
-003
.44A.
173.18
83.34
166.67
95.47
-016 0.64A
Pt. 002
Pt. 4.12A.
-004
.44A.
382.77
67.35
83.33
248
230
478
RD.
#11594
-007
1.10A.
100
APPROVED
LORAIN CO.
MAP DEPT.
DATE 4/28/78
PAGE 6-39
BY T. McNair
VOID AFTER 11594
477.92
103
-005
1.10A.
5
477.68
540.57
-006
1.10A.
C.75-16-78
477.76
RIDGE
-008
1.10A.
477.68
MURRAY
-009
1.44A.
140.57
723.62
225.40
-010 0.12A.
252.12
TR.
199.10
254.64
301
1 -016
117.73
146.60
211.05
20-013
156
RD.
-014
42.10
2 -017