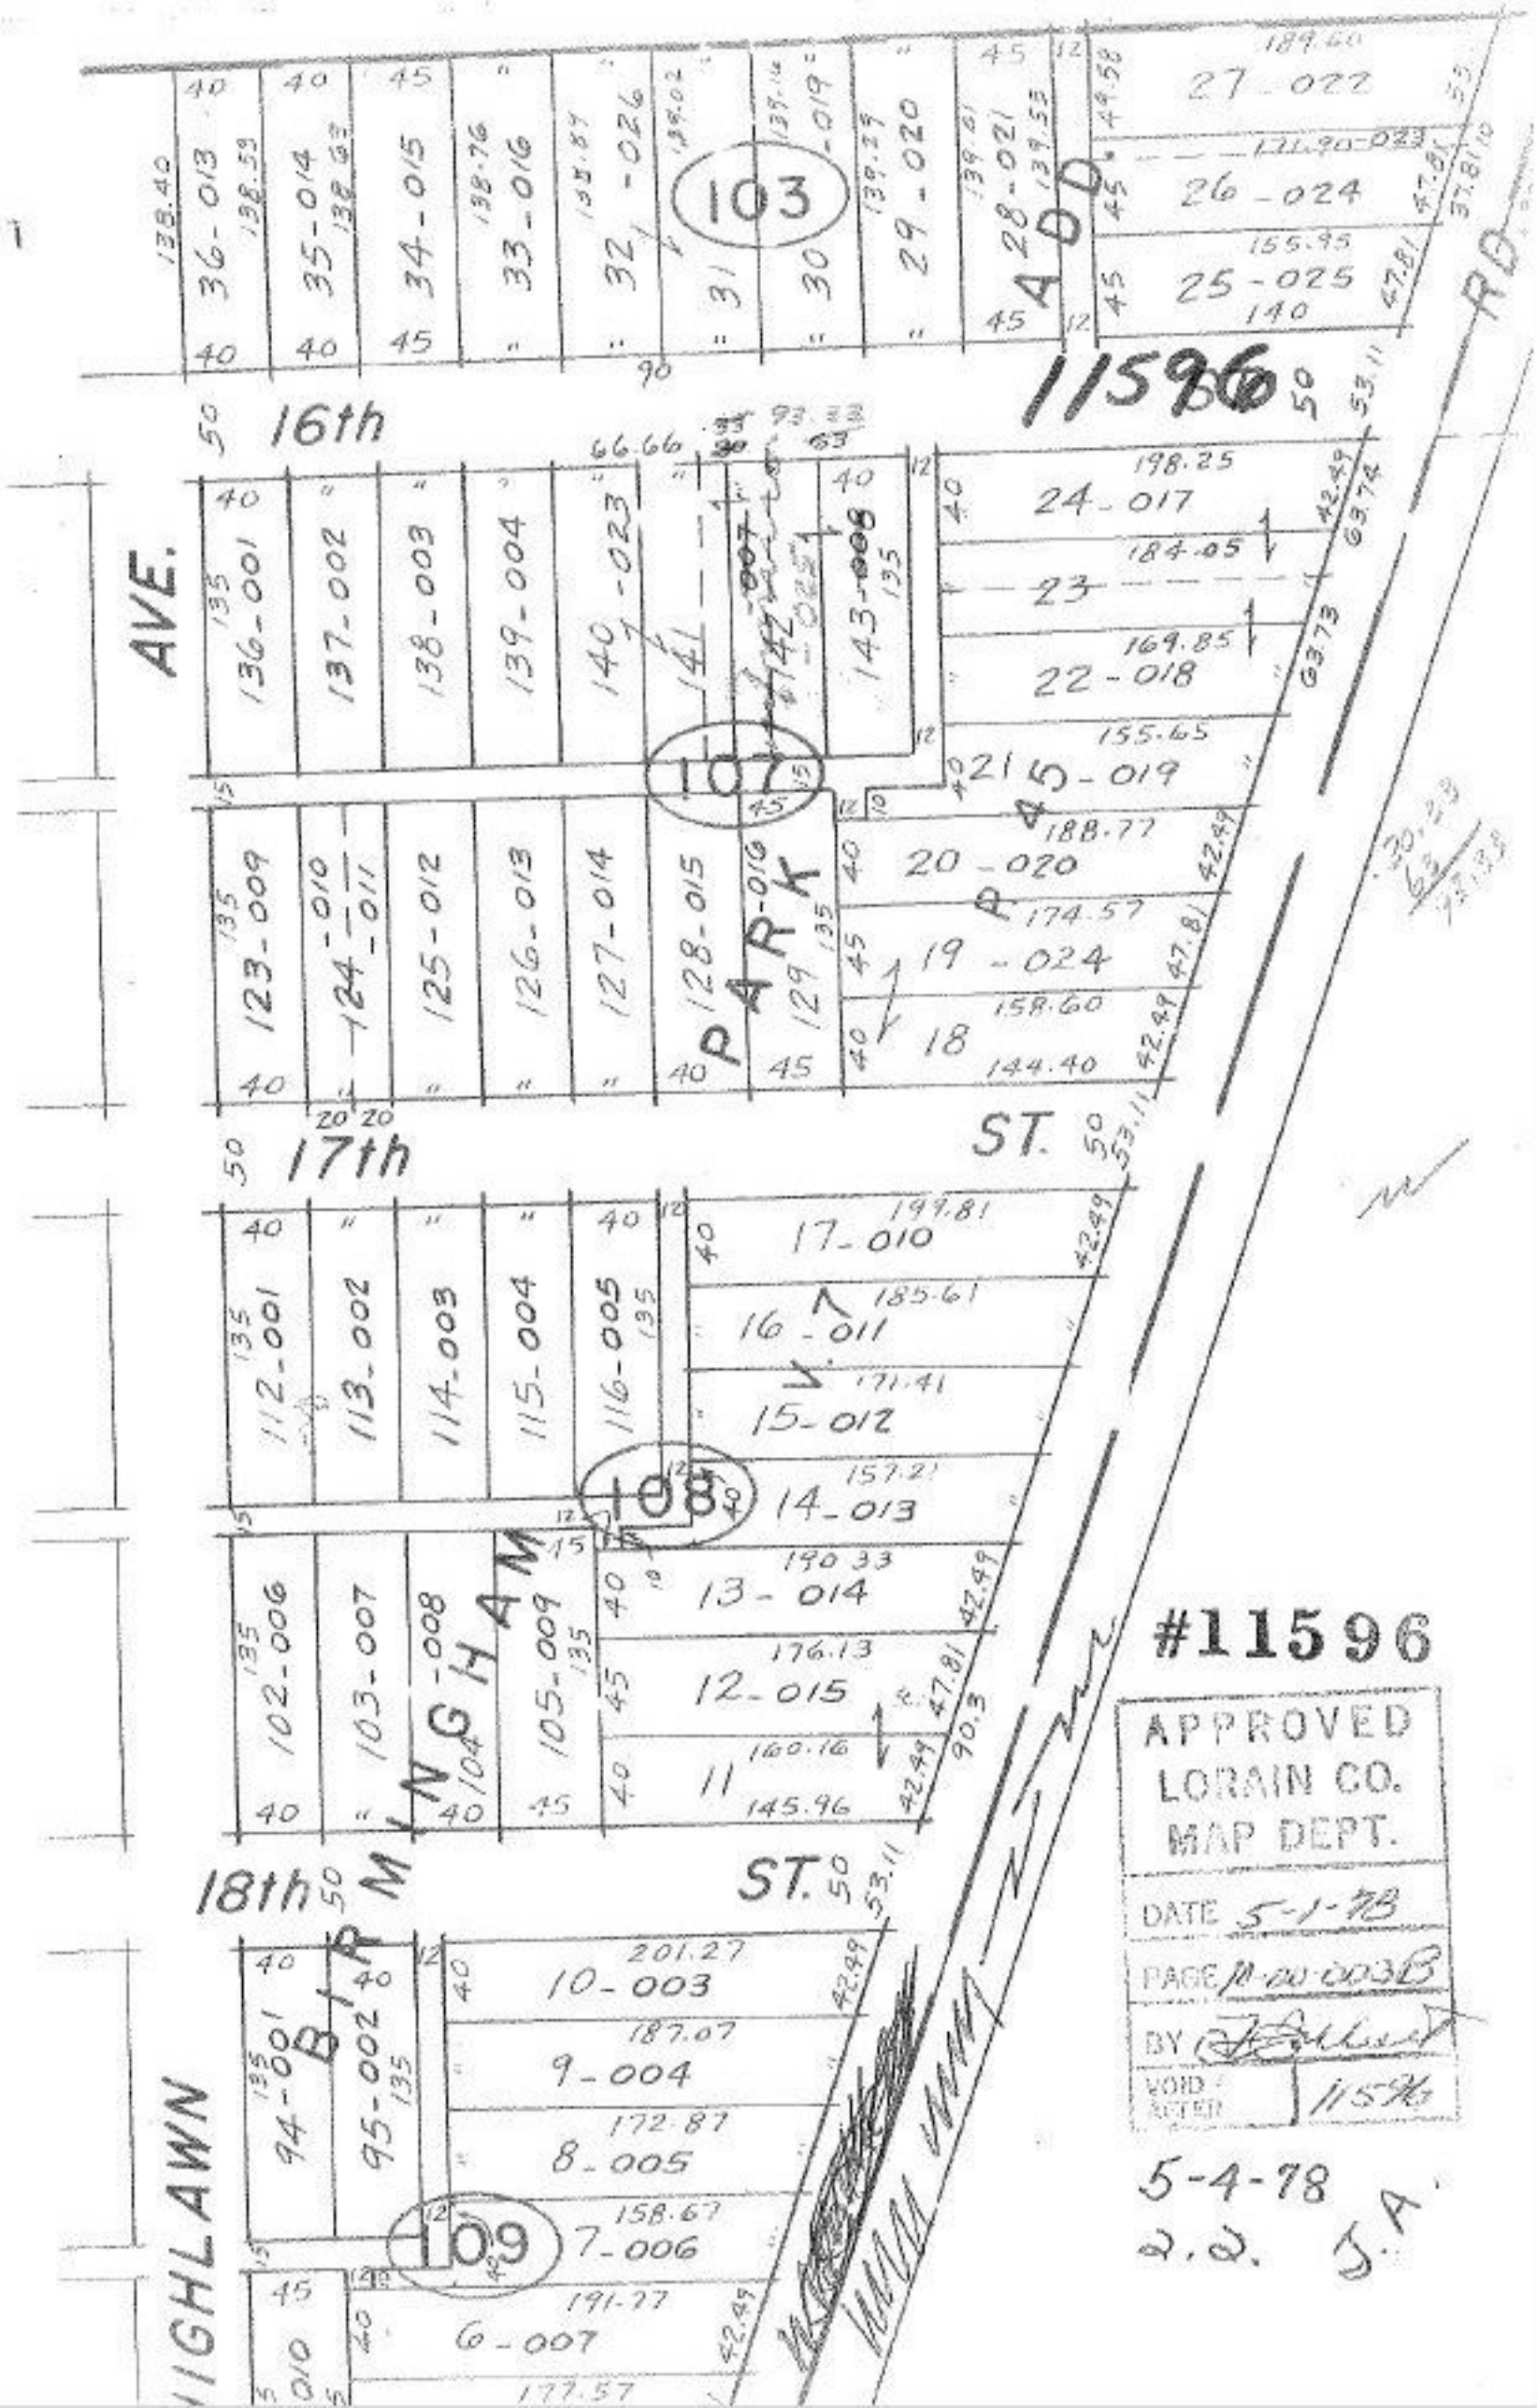

#11596

APPROVED
LORAIN CO.
MAP DEPT.

DATE 5-1-78

PAGE 10-00-003B

BY [signature]

VOID AFTER 11596

5-4-78
2.2. J.A.