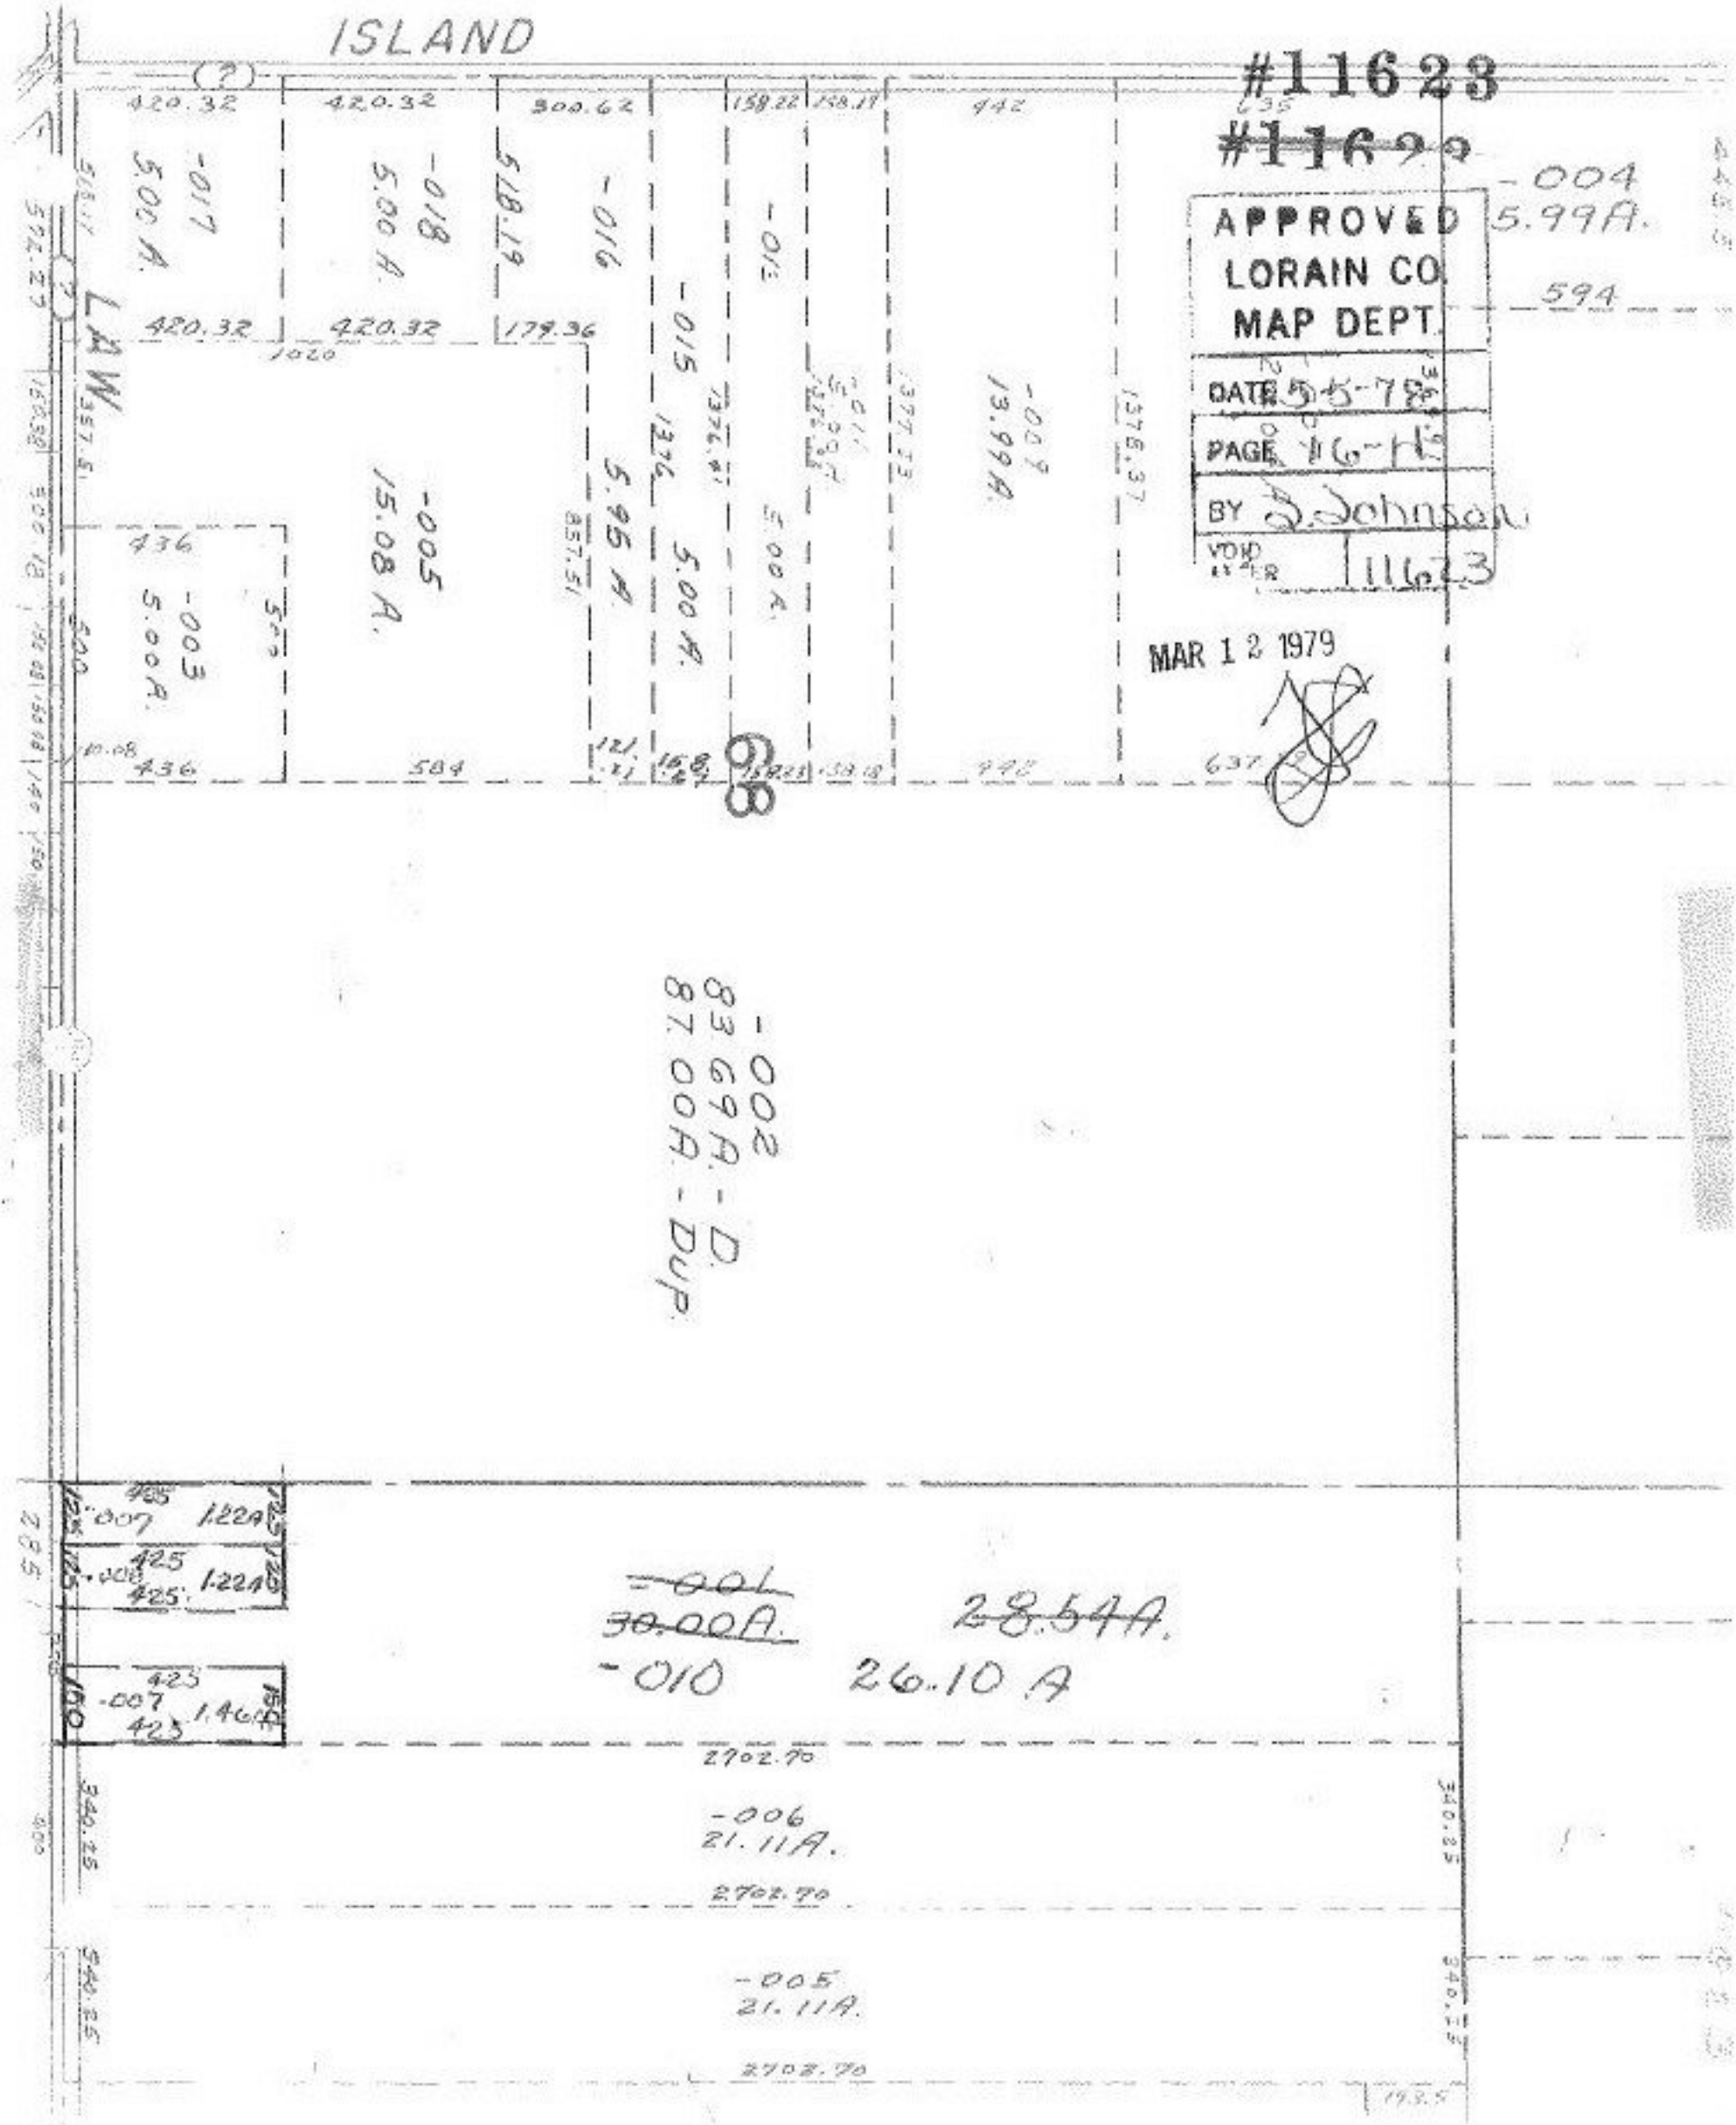
ISLAND
#11623
APPROVED
LORAIN CO.
MAP DEPT.
DATE 5-5-78
PAGE 16-H
BY S. Johnson
VOID AFTER 11623
MAR 12 1979
-004
5.99A.
-017
5.00 A.
-018
5.00 A.
-016
-015
-013
-009
13.99 A.
-005
15.08 A.
-003
5.00 A.
5.95 A.
5.00 A.
LAW
-002
83.69 A. - D.
87.00 A. - Dup.
-001
30.00 A.
28.54 A.
-010
26.10 A
-006
21.11 A.
-005
21.11 A.
2702.70
340.25