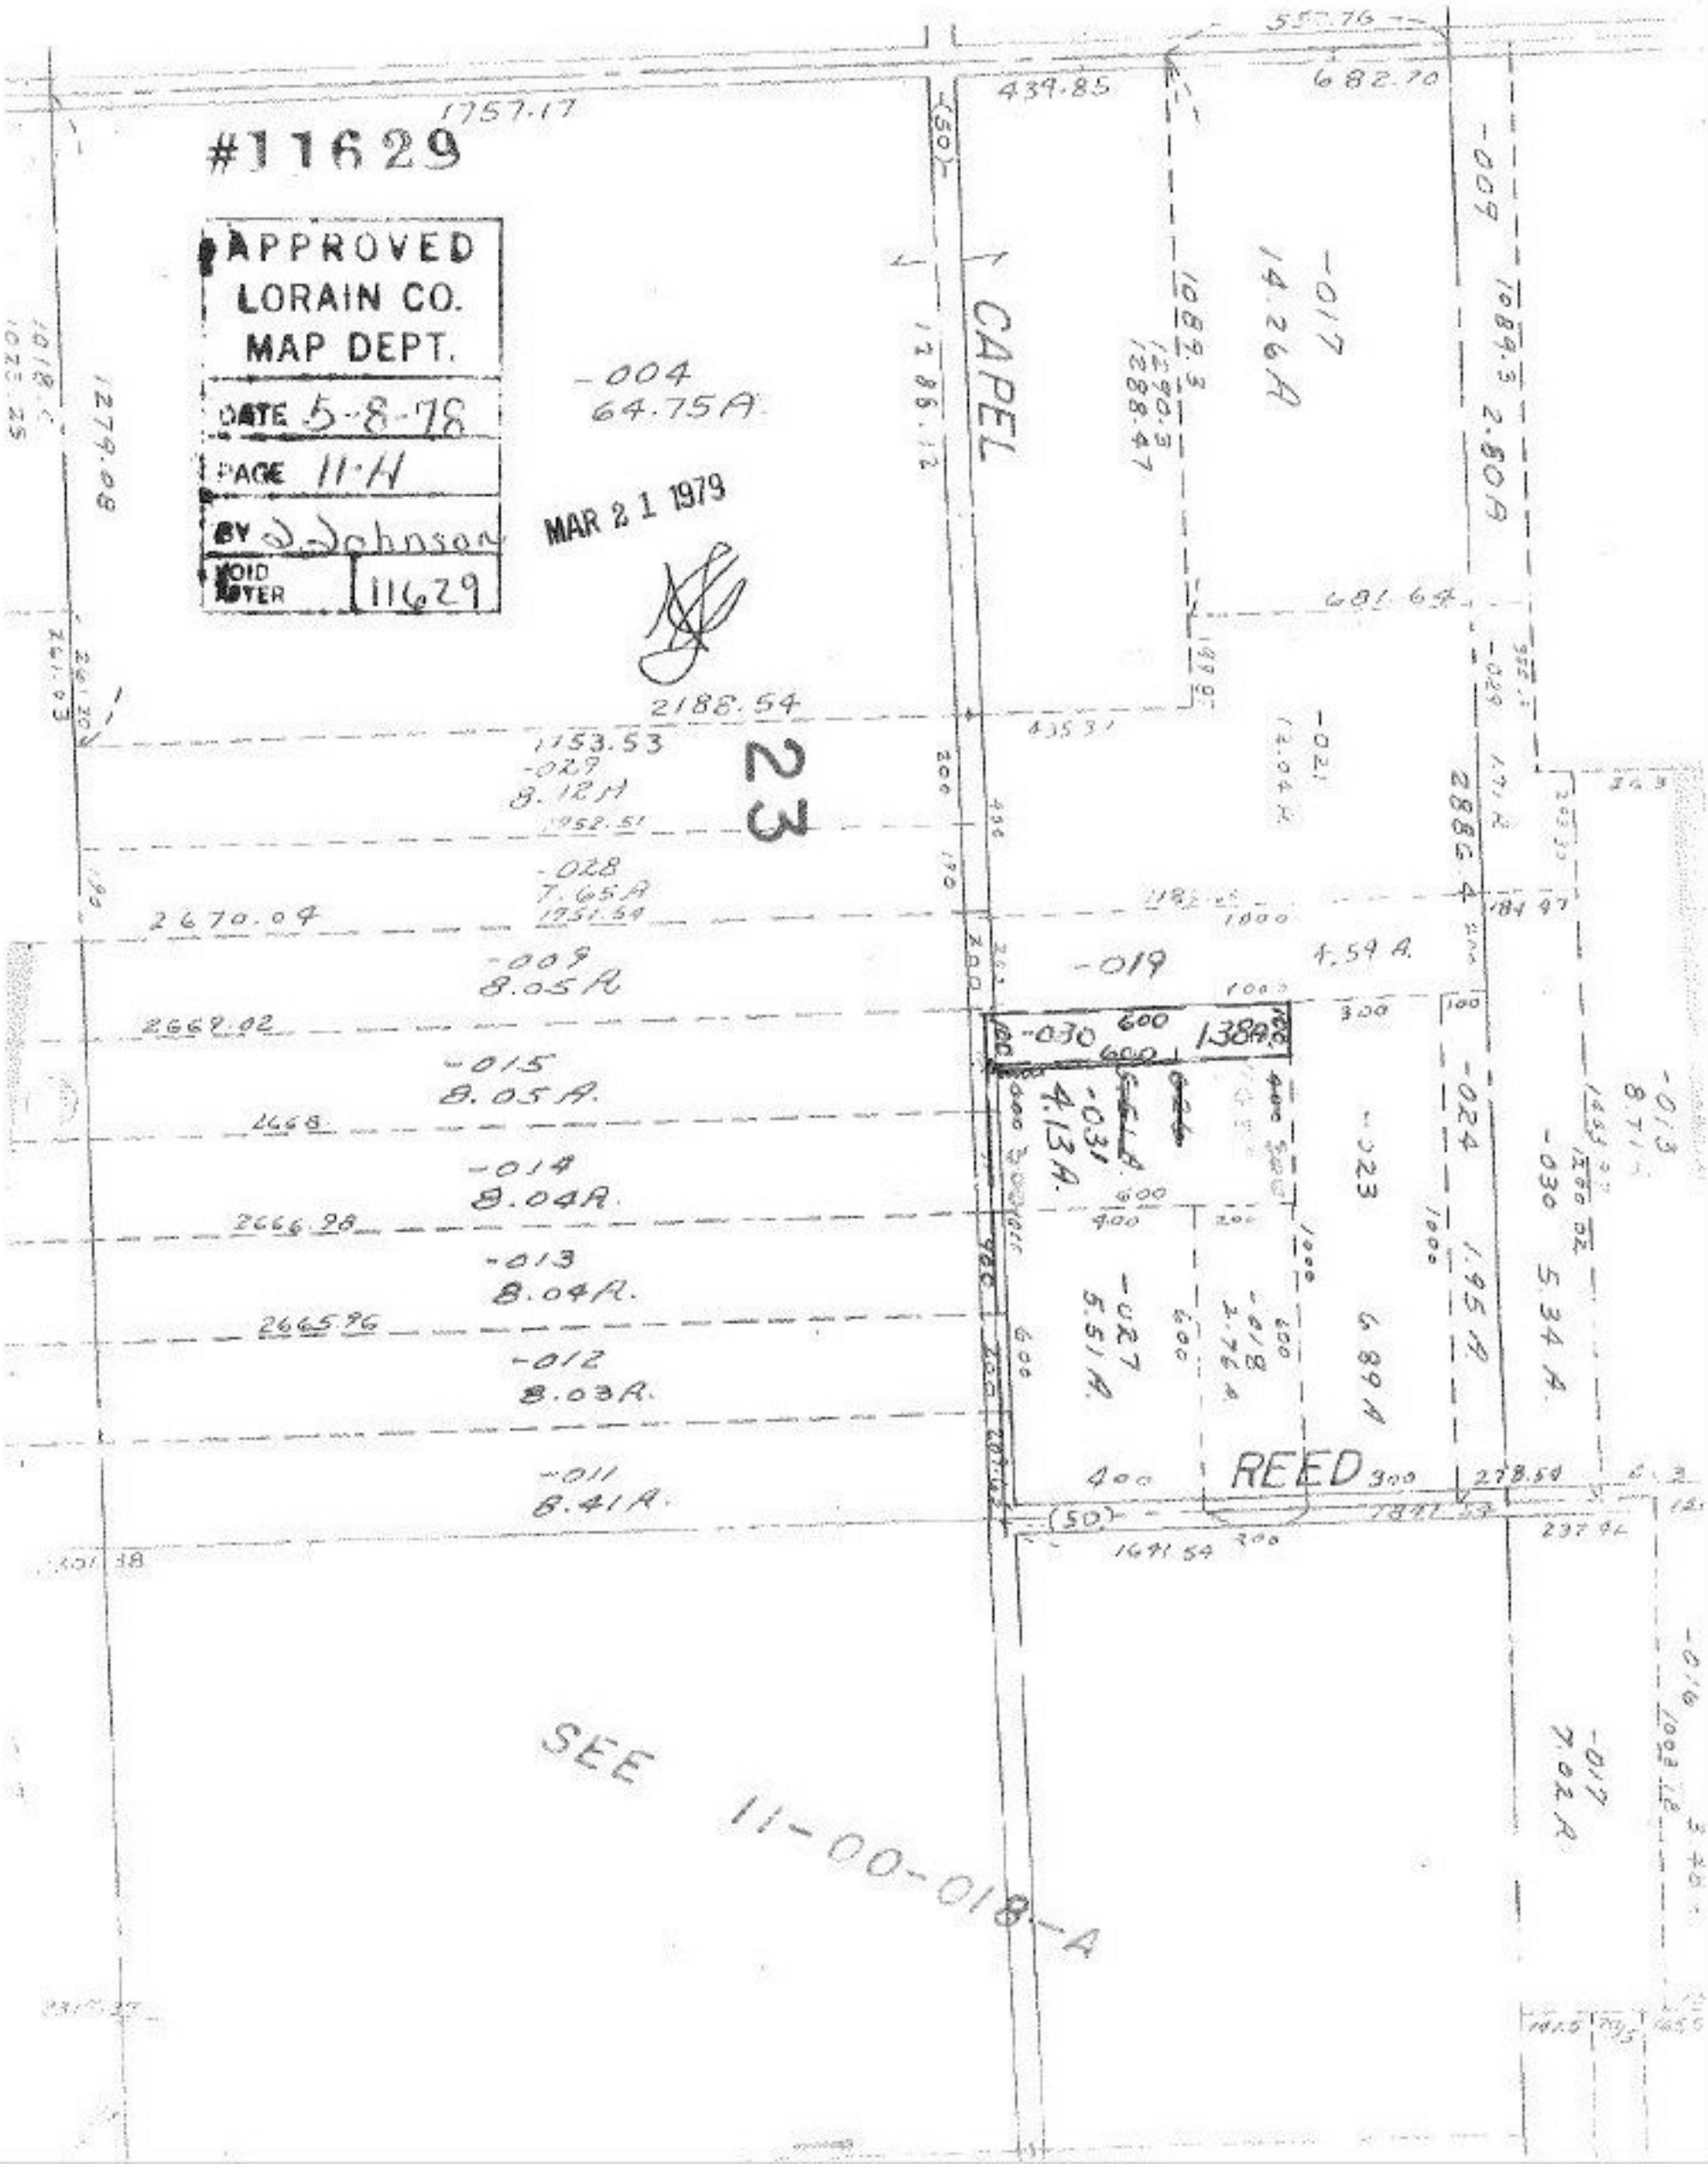
#11629
APPROVED
LORAIN CO.
MAP DEPT.
DATE 5-8-78
PAGE 11-H
BY J. Johnson
VOID AFTER 11629
MAR 21 1979
23
CAPEL
REED
-004
64.75A
-017
14.26A
-009
2.80A
-019
4.59 A.
-030
1.38A
-031
4.13A.
-027
5.51 A.
-018
2.76 A
-023
6.89 A
-024
1.95 A
-030
5.34 A.
-017
7.02 A
-029
8.12A
-028
7.65A
-009
8.05A
-015
8.05A.
-014
8.04A.
-013
8.04A.
-012
8.03A.
-011
8.41A.
SEE 11-00-018-A