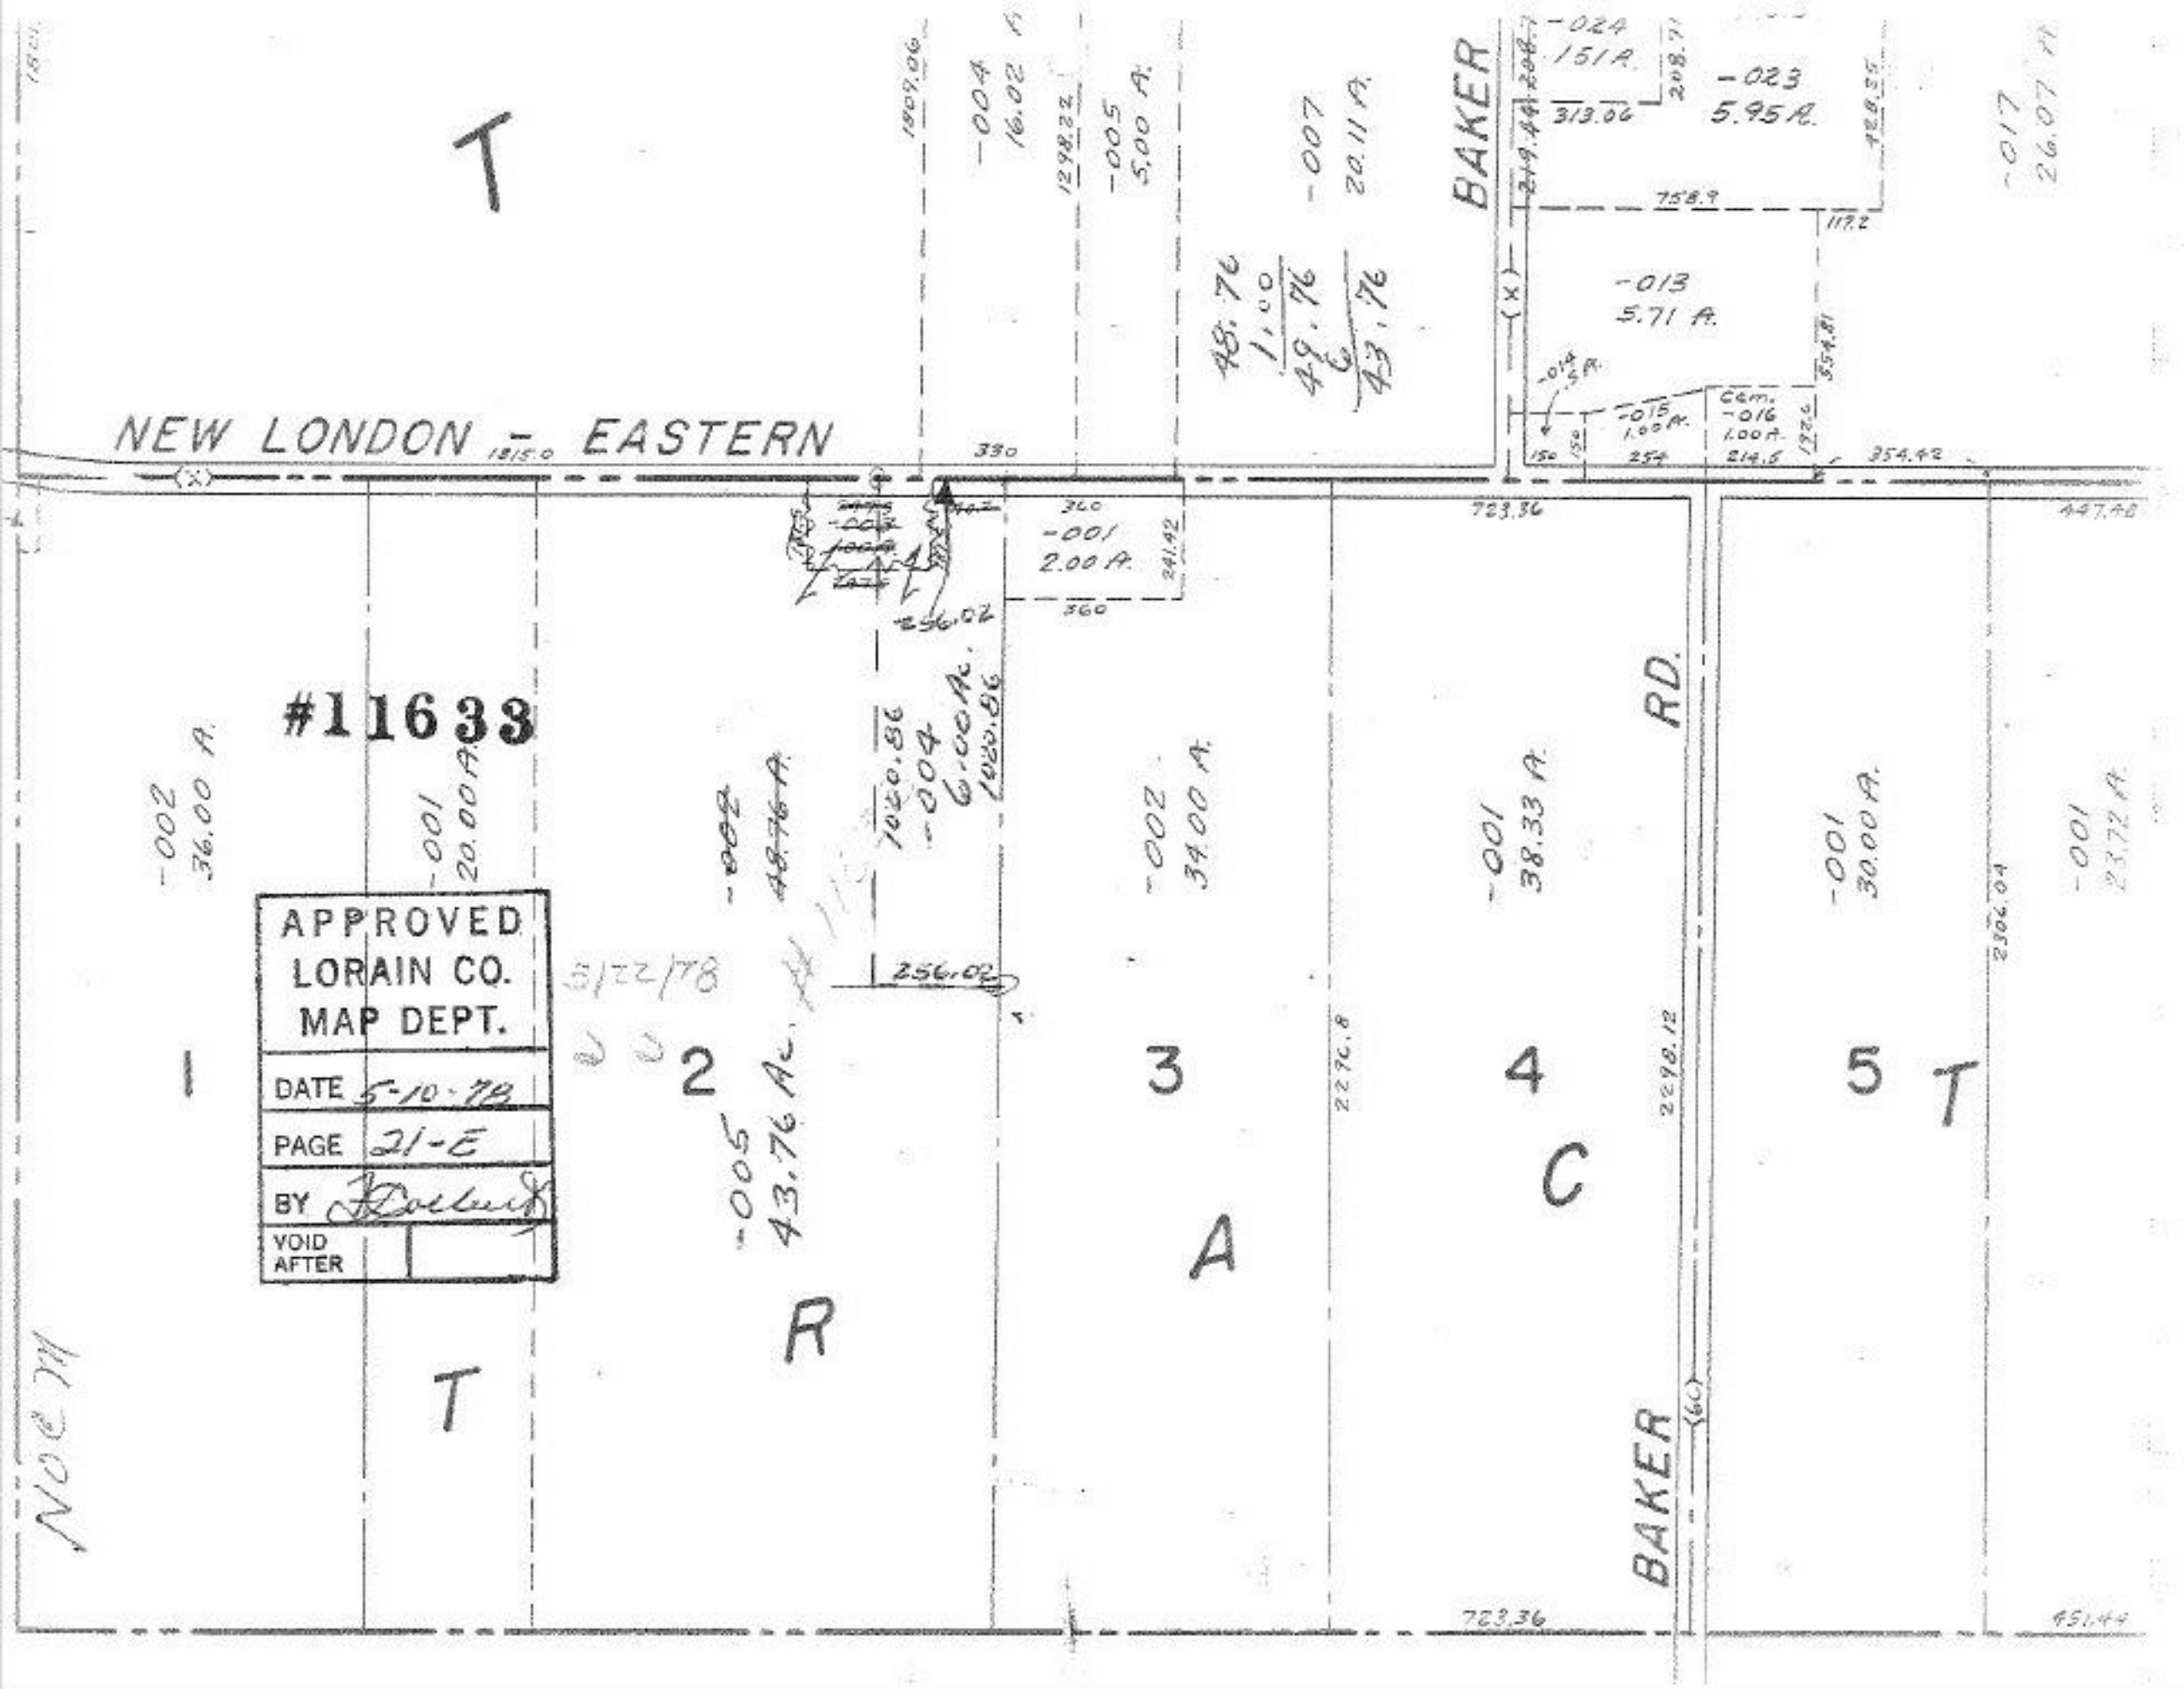

NEW LONDON - EASTERN
BAKER
RD.
BAKER
T
T
R
A
C
T
1
2
3
4
5
#11633
APPROVED
LORAIN CO.
MAP DEPT.
DATE 5-10-78
PAGE 21-E
BY
VOID AFTER
-002 36.00 A.
-001 20.00 A.
-002 48.76 A.
-004 6.00 Ac.
-005 43.76 Ac.
-002 34.00 A.
-001 38.33 A.
-001 30.00 A.
-001 23.72 A.
-001 2.00 A.
-004 16.02 A.
-005 5.00 A.
-007 20.11 A.
-024 1.51 A.
-023 5.95 A.
-013 5.71 A.
-015 1.00 A.
-016 1.00 A.
-017 26.07 A.
48.76
1.00
49.76
6
43.76
1815.0
330
360
360
723.36
723.36
447.48
451.44
256.02
256.02
1020.86
1020.86
2276.8
2298.12
2306.04