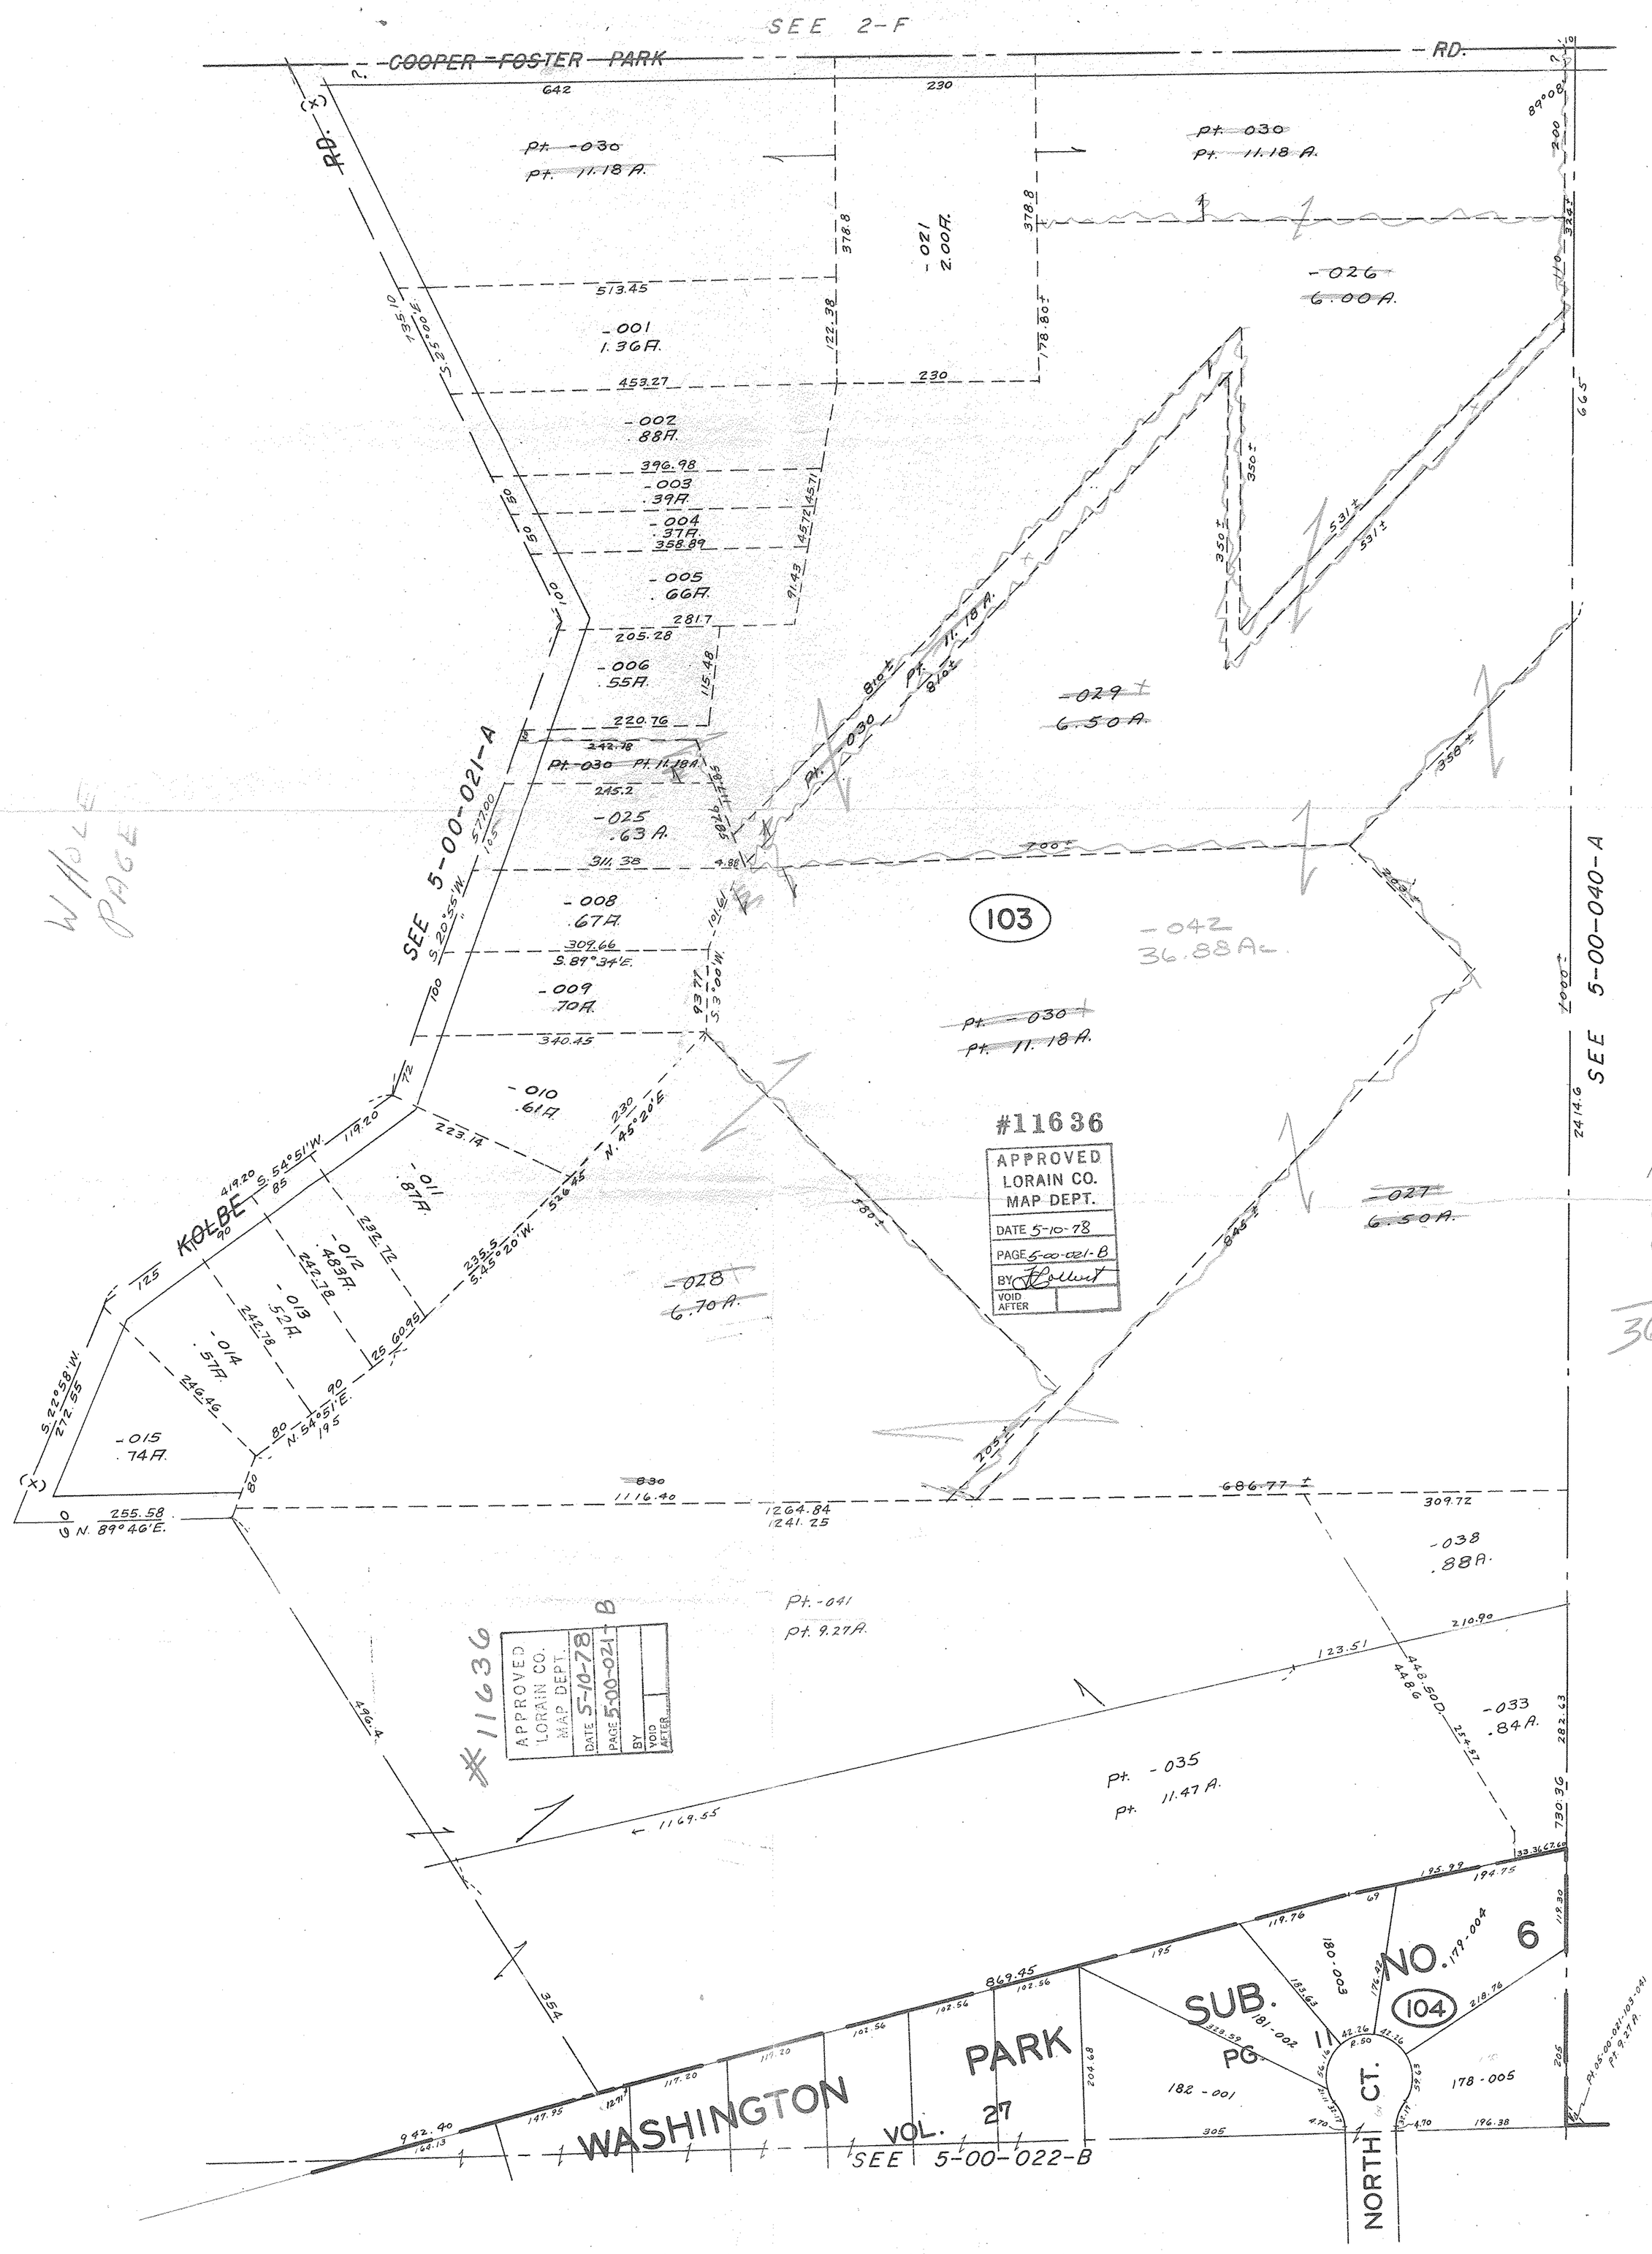

AMHERST TWP.

Copyright
Revised