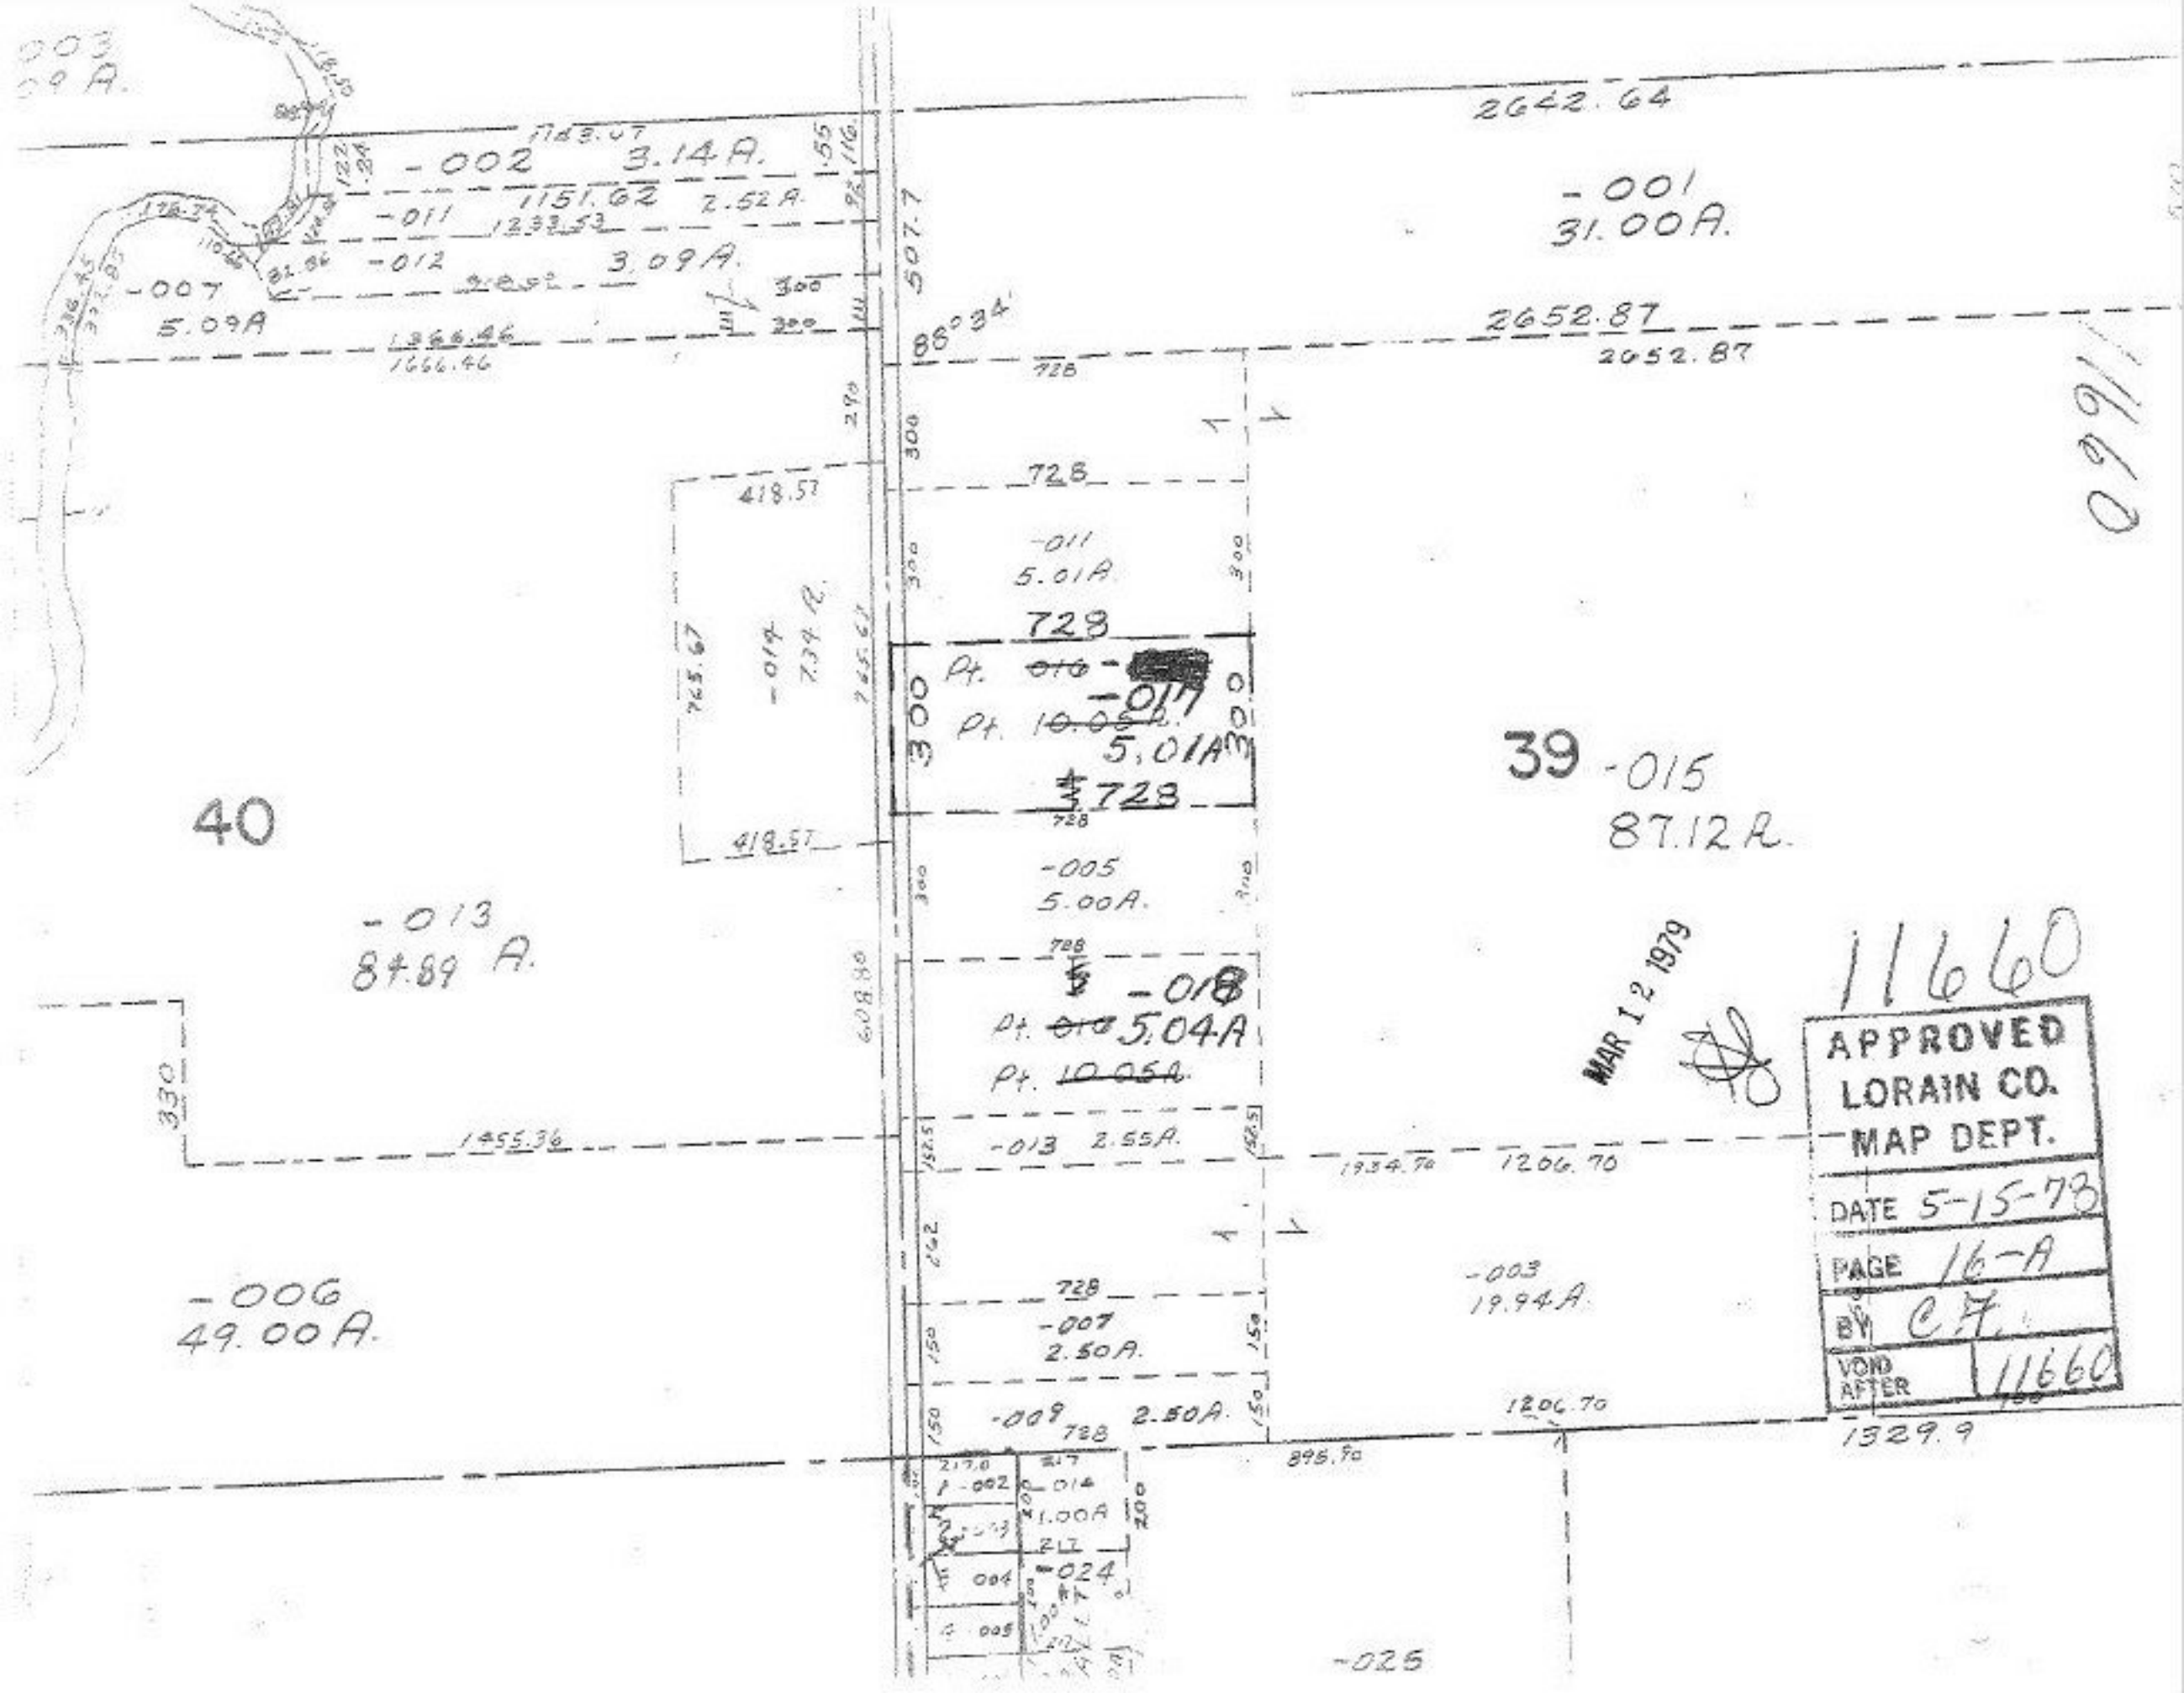

2642.64
-001
31.00A.
-002 3.14A.
1151.62 2.52A.
-011
-012 3.09A.
-007
5.09A
1366.46
1666.46
507.7
88°34'
2652.87
2652.87
11660
728
418.57
-011
5.01A
728
Pt. -017
Pt. 5.01A
728
-005
5.00A.
-018
Pt. 5.04A
Pt. 10.05A.
-013 2.55A.
1455.36
1934.70
1206.70
-003
19.94A.
-007
2.50A.
-009 2.50A.
1206.70
1329.9
895.90
-014
1.00A
-024
-025
40
39 -015
87.12A.
-013
84.89 A.
-006
49.00A.
MAR 12 1979
11660
APPROVED
LORAIN CO.
MAP DEPT.
DATE 5-15-78
PAGE 16-A
BY C.F.
VOID AFTER 11660