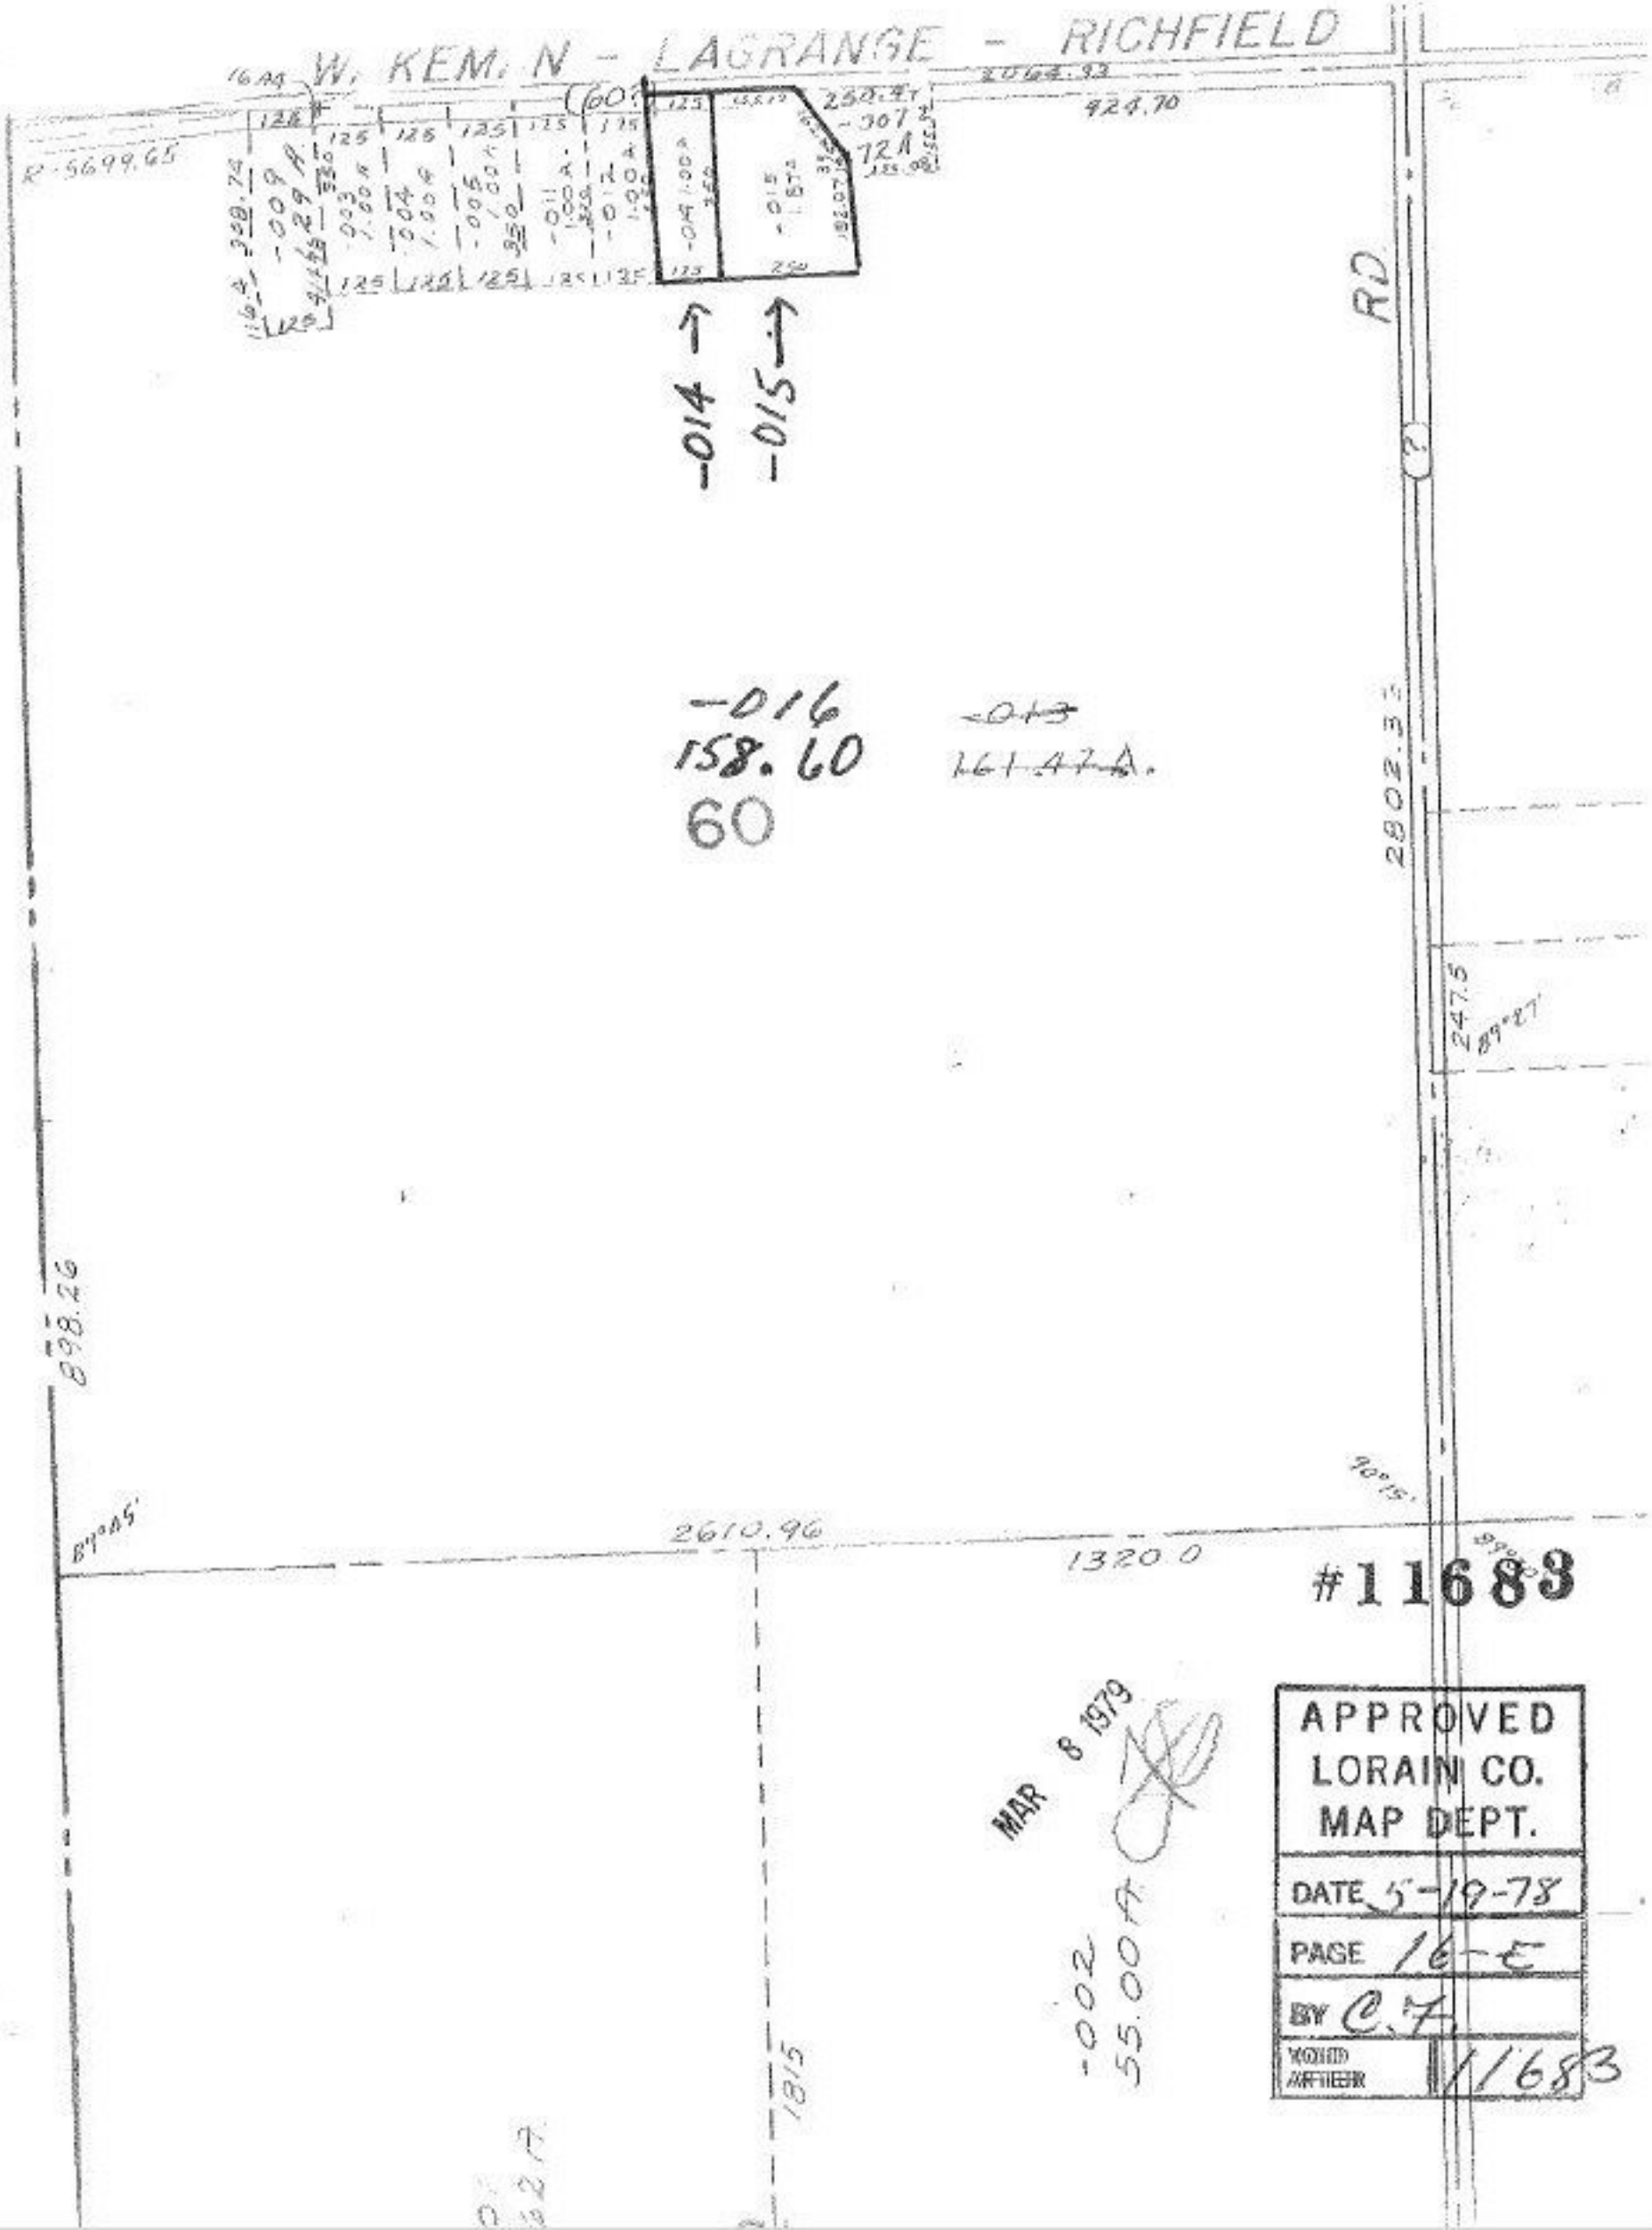
W. KEMPN - LAGRANGE - RICHFIELD
R-5699.65
924.70
RD
-014
-015
-016
158.60
60
~~-013~~
~~161.47 A.~~
2802.35
247.5
89°27'
898.26
2610.96
1320.0
#11683
MAR 8 1979
-002
55.00 A
1815
APPROVED
LORAIN CO.
MAP DEPT.
DATE 5-19-78
PAGE 16-E
BY C.F.
VOID AFTER 11683